

POLICE DETENTION CENTERS REHABILITATION PROJECT

CENTER NO (1):

AI-QALAA DETENTION CENTER

LIST OF DRAWINGS

ARCHITECTURAL DRAWINGS

NO.	DRAWING TITLE
A00	List Of Drawings
A01	Table of Area
A02	Existing Site Plan
A03	Proposed Site Plan
A04	Existing Plan
A05	Demolition Plan
A06	To Be Built Walls Plan
A07	Proposed Buildings Plan
A08	Proposed Furniture Plan
A09	Proposed Dimensional Plan
A10	Proposed Staircase Furniture & Dimensional Plan
A11	Proposed Staircase Roof
A12	Northern Elevation
A13	Eastern Elevation
A14	Section A-A

LEGEND



1- EXISTING EXTERNAL WALL	
2- REINFORCED CONCRETE	
3- CONCRETE BLOCK WALL	
4- EXTERIOR PAVING	

NOTES

Rev.:	Date:	Description:	Approved:
-------	-------	--------------	-----------

All information in this document is the property of PALESTINIAN CIVIL POLICE and cannot be copied anywhere but in this project without prior written consent of PALESTINIAN CIVIL POLICE.

Partners:

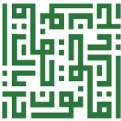The Independent Commission For Human Rights (ICHR)	PALESTINIAN CIVIL POLICE
	

Funded by:

	Kingdom of Norway
---	-------------------

Design & Implementation:

	QURIE ARCHITECTURE
---	-----------------------

Project Name:

Detention Centers Rehabilitation
Project in the West Bank
(Norwegian Grant)


Title:

Al-Qalaa Detention Center

Drawings Title:

List Of Drawings

Project No.:	Phase:	Discipline:	Date:	Drawing No.:
000000	01	A	8.2021	A00
Drawn:	Checked:	Approved:	Size:	Scale:
			A3	

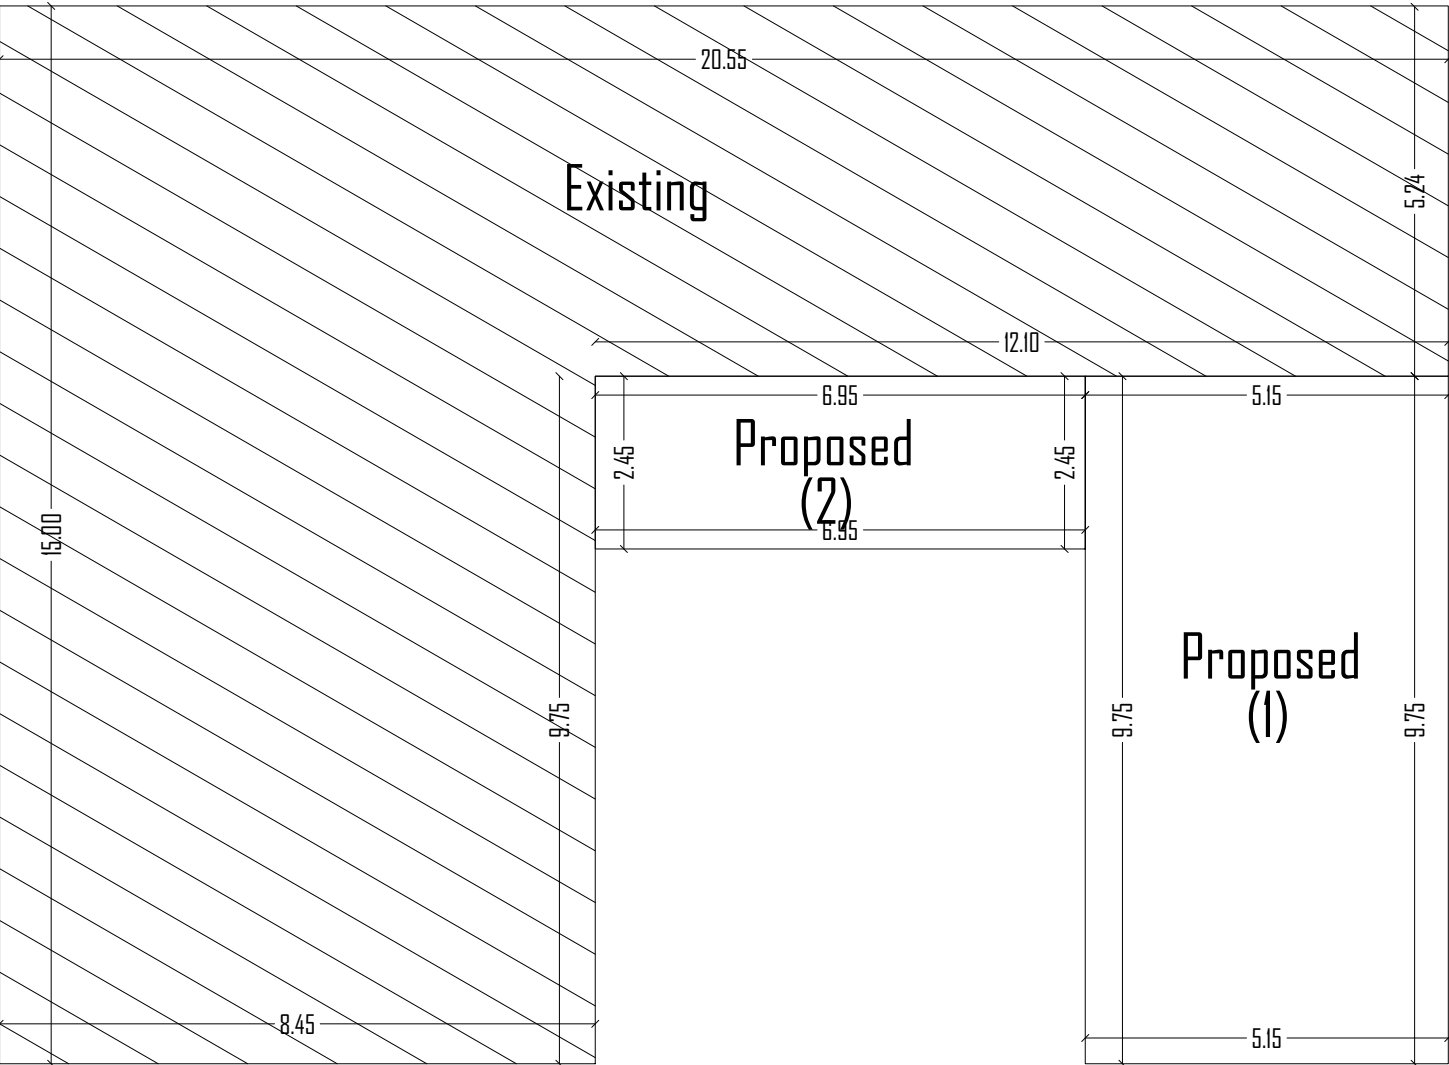

Total Areas and Volumes Table				
Existing		Proposed		
Area m2	Volume m3	No	Area m2	Volume m3
190	874.00	(1)	50.21	163.18
		(2)	16.68	54.21
		Total:	66.89	217.39

LEGEND

1- EXISTING EXTERNAL WALL

2- REINFORCED CONCRETE

3- CONCRETE BLOCK WALL

4- EXTERIOR PAVING

NOTES

Rev.:Date:Description:Approved:

All information in this document is the property of PALESTINIAN CIVIL POLICE and cannot be copied anywhere but in this project without prior written consent of PALESTINIAN CIVIL POLICE.

Partners:

The Independent Commission For Human Rights (ICHR)

PALESTINIAN CIVIL POLICE

Funded by:

Kingdom of Norway

Design & Implementation:

QURIE ARCHITECTURE

Project Name:

Detention Centers Rehabilitation Project in the West Bank (Norwegian Grant)


Title:

Al-Qalaa Detention Center

Drawings Title:

Table of Area

Project No.:	Phase:	Discipline:	Date:	Drawing No.:
000000	01	A	8.2021	A01
Drawn:	Checked:	Approved:	Size:	Scale:
			A3	1:100

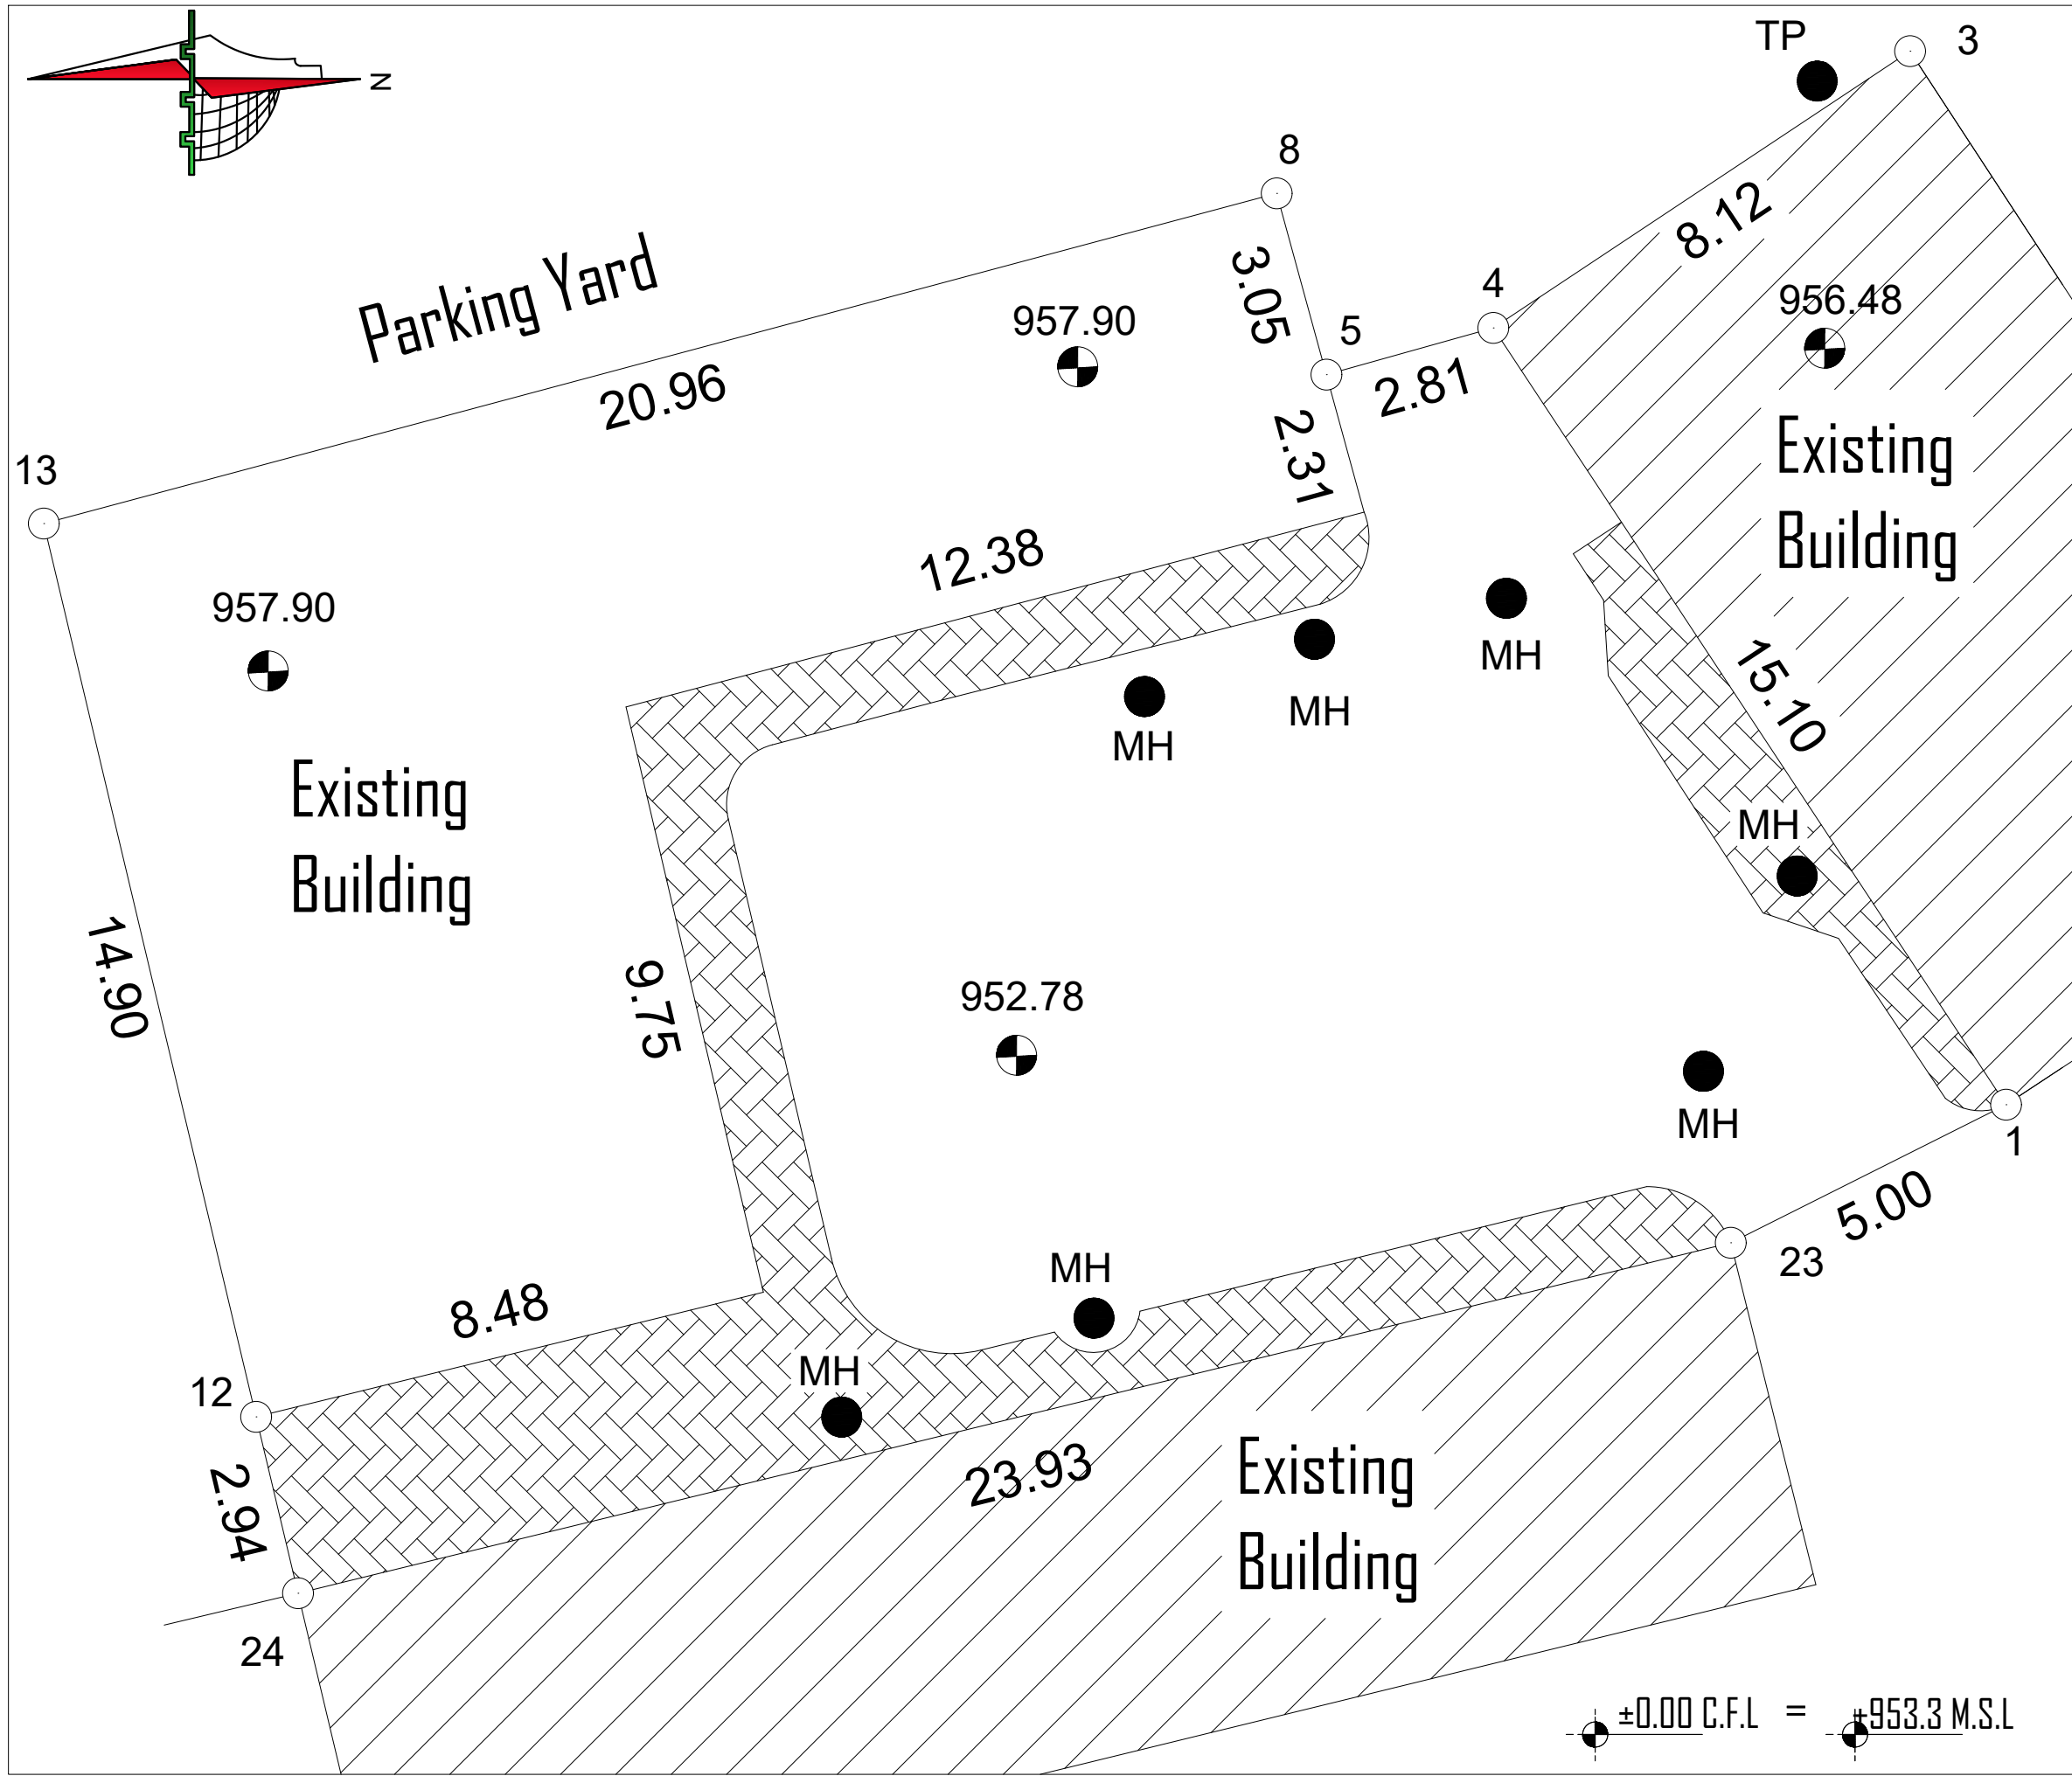


LEGEND

1- EXISTING EXTERNAL WALL	
2- REINFORCED CONCRETE	
3- CONCRETE BLOCK WALL	
4- EXTERIOR PAVING	

NOTES

Rev.:	Date:	Description:	Approved:		
All information in this document is the property of PALESTINIAN CIVIL POLICE and cannot be copied anywhere but in this project without prior written consent of PALESTINIAN CIVIL POLICE.					
Partners:					
The Independent Commission For Human Rights (ICHR)		PALESTINIAN CIVIL POLICE			
Funded by:					
		Kingdom of Norway			
Design & Implementation:					
		QURIE ARCHITECTURE			
Project Name:					
Detention Centers Rehabilitation Project in the West Bank (Norwegian Grant)					
Title:					
Al-Qalaa Detention Center					
Drawings Title:					
Existing Site Plan					
Project No.:	Phase:	Discipline:	Date:	Drawing No.:	
00000	01	A	8.2021	A02	
Drawn:	Checked:	Approved:	Size:	Scale:	Rev.:
			A3		

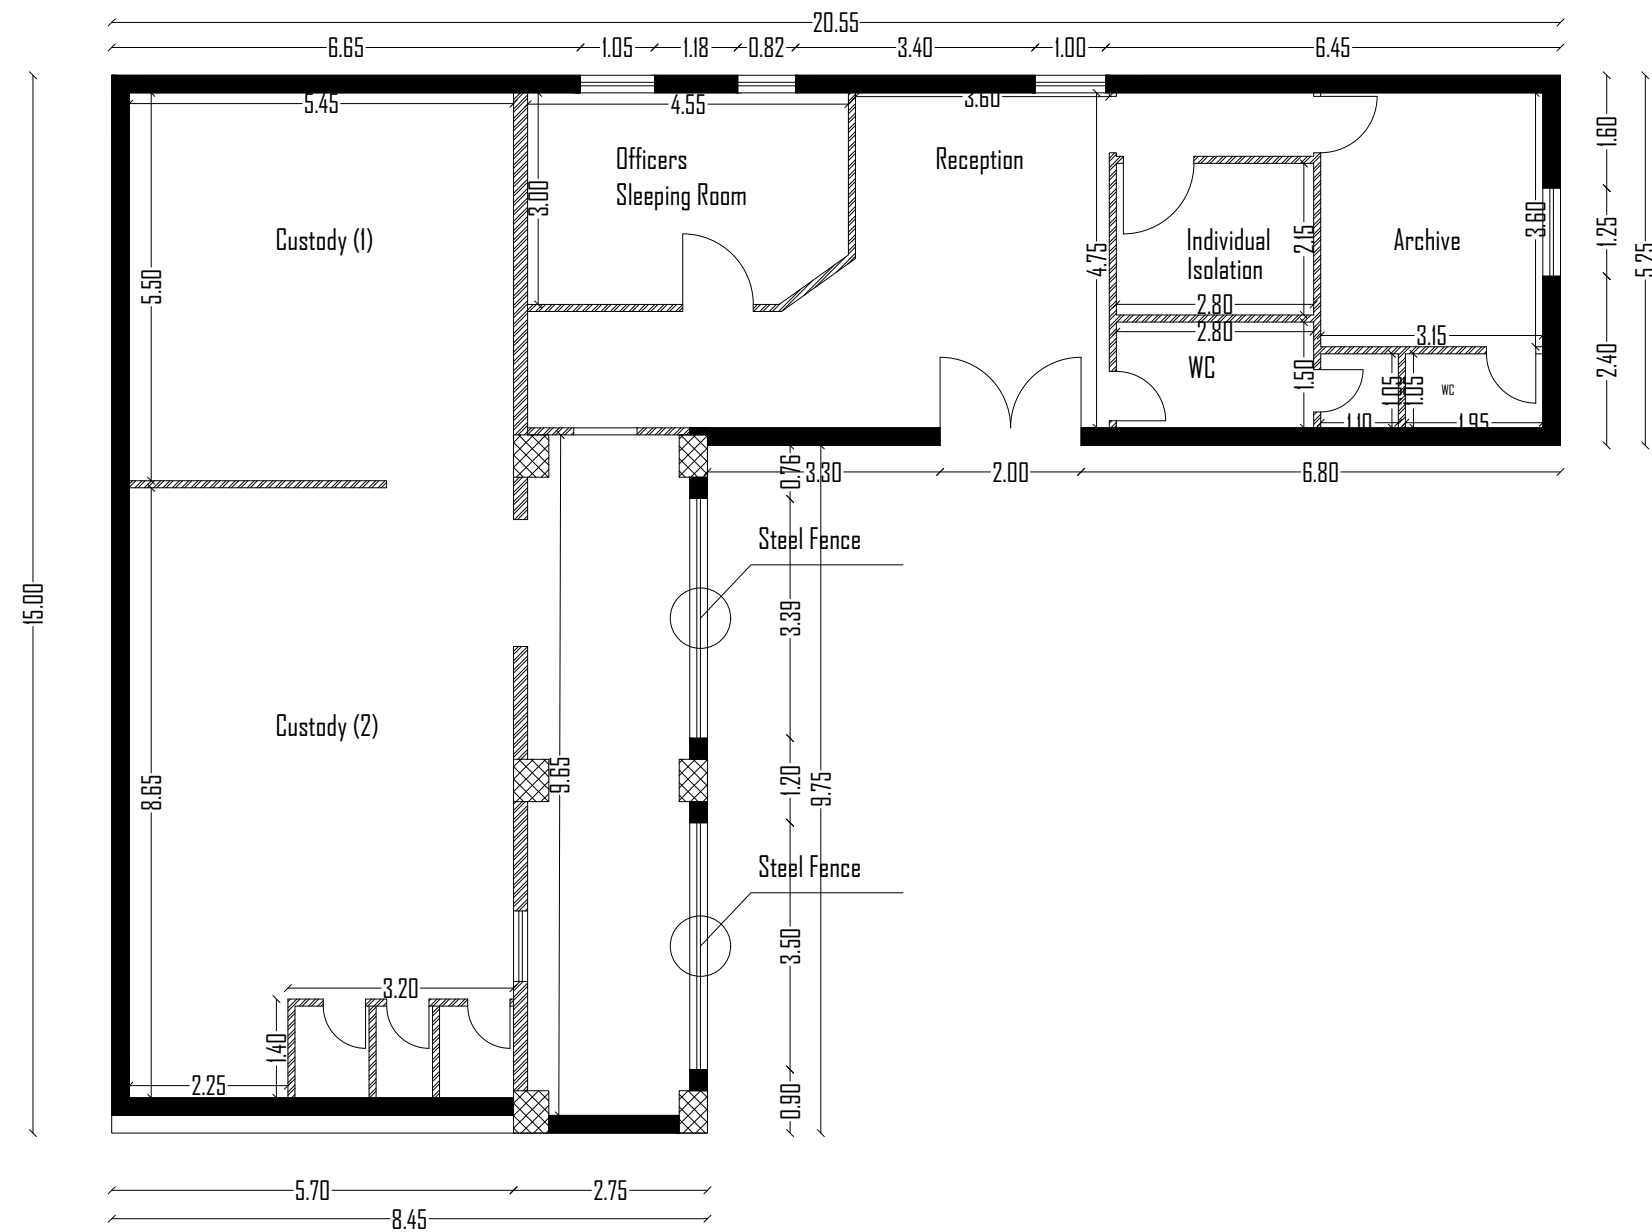

Existing Heights :

H = 4.35m 'Clarence'

H = 4.60m FFL to FFL

LEGEND

1- EXISTING EXTERNAL WALL

2- REINFORCED CONCRETE

3- CONCRETE BLOCK WALL

4- EXTERIOR PAVING

NOTES

Rev.:	Date:	Description:	Approved:

All information in this document is the property of PALESTINIAN CIVIL POLICE and cannot be copied anywhere but in this project without prior written consent of PALESTINIAN CIVIL POLICE.

Partners:

The Independent Commission For Human Rights (ICHR)

PALESTINIAN CIVIL POLICE

Funded by:

Kingdom of Norway

Design & Implementation:

QURIE

ARCHITECTURE

Project Name:

Detention Centers Rehabilitation Project in the West Bank (Norwegian Grant)


Title:

Al-Qalaa Detention Center

Drawings Title:

Existing Plan

Project No.:	Phase:	Discipline:	Date:	Drawing No.:
000000	01	A	8.2021	A04
Drawn:	Checked:	Approved:	Size:	Scale:
			A3	1:100

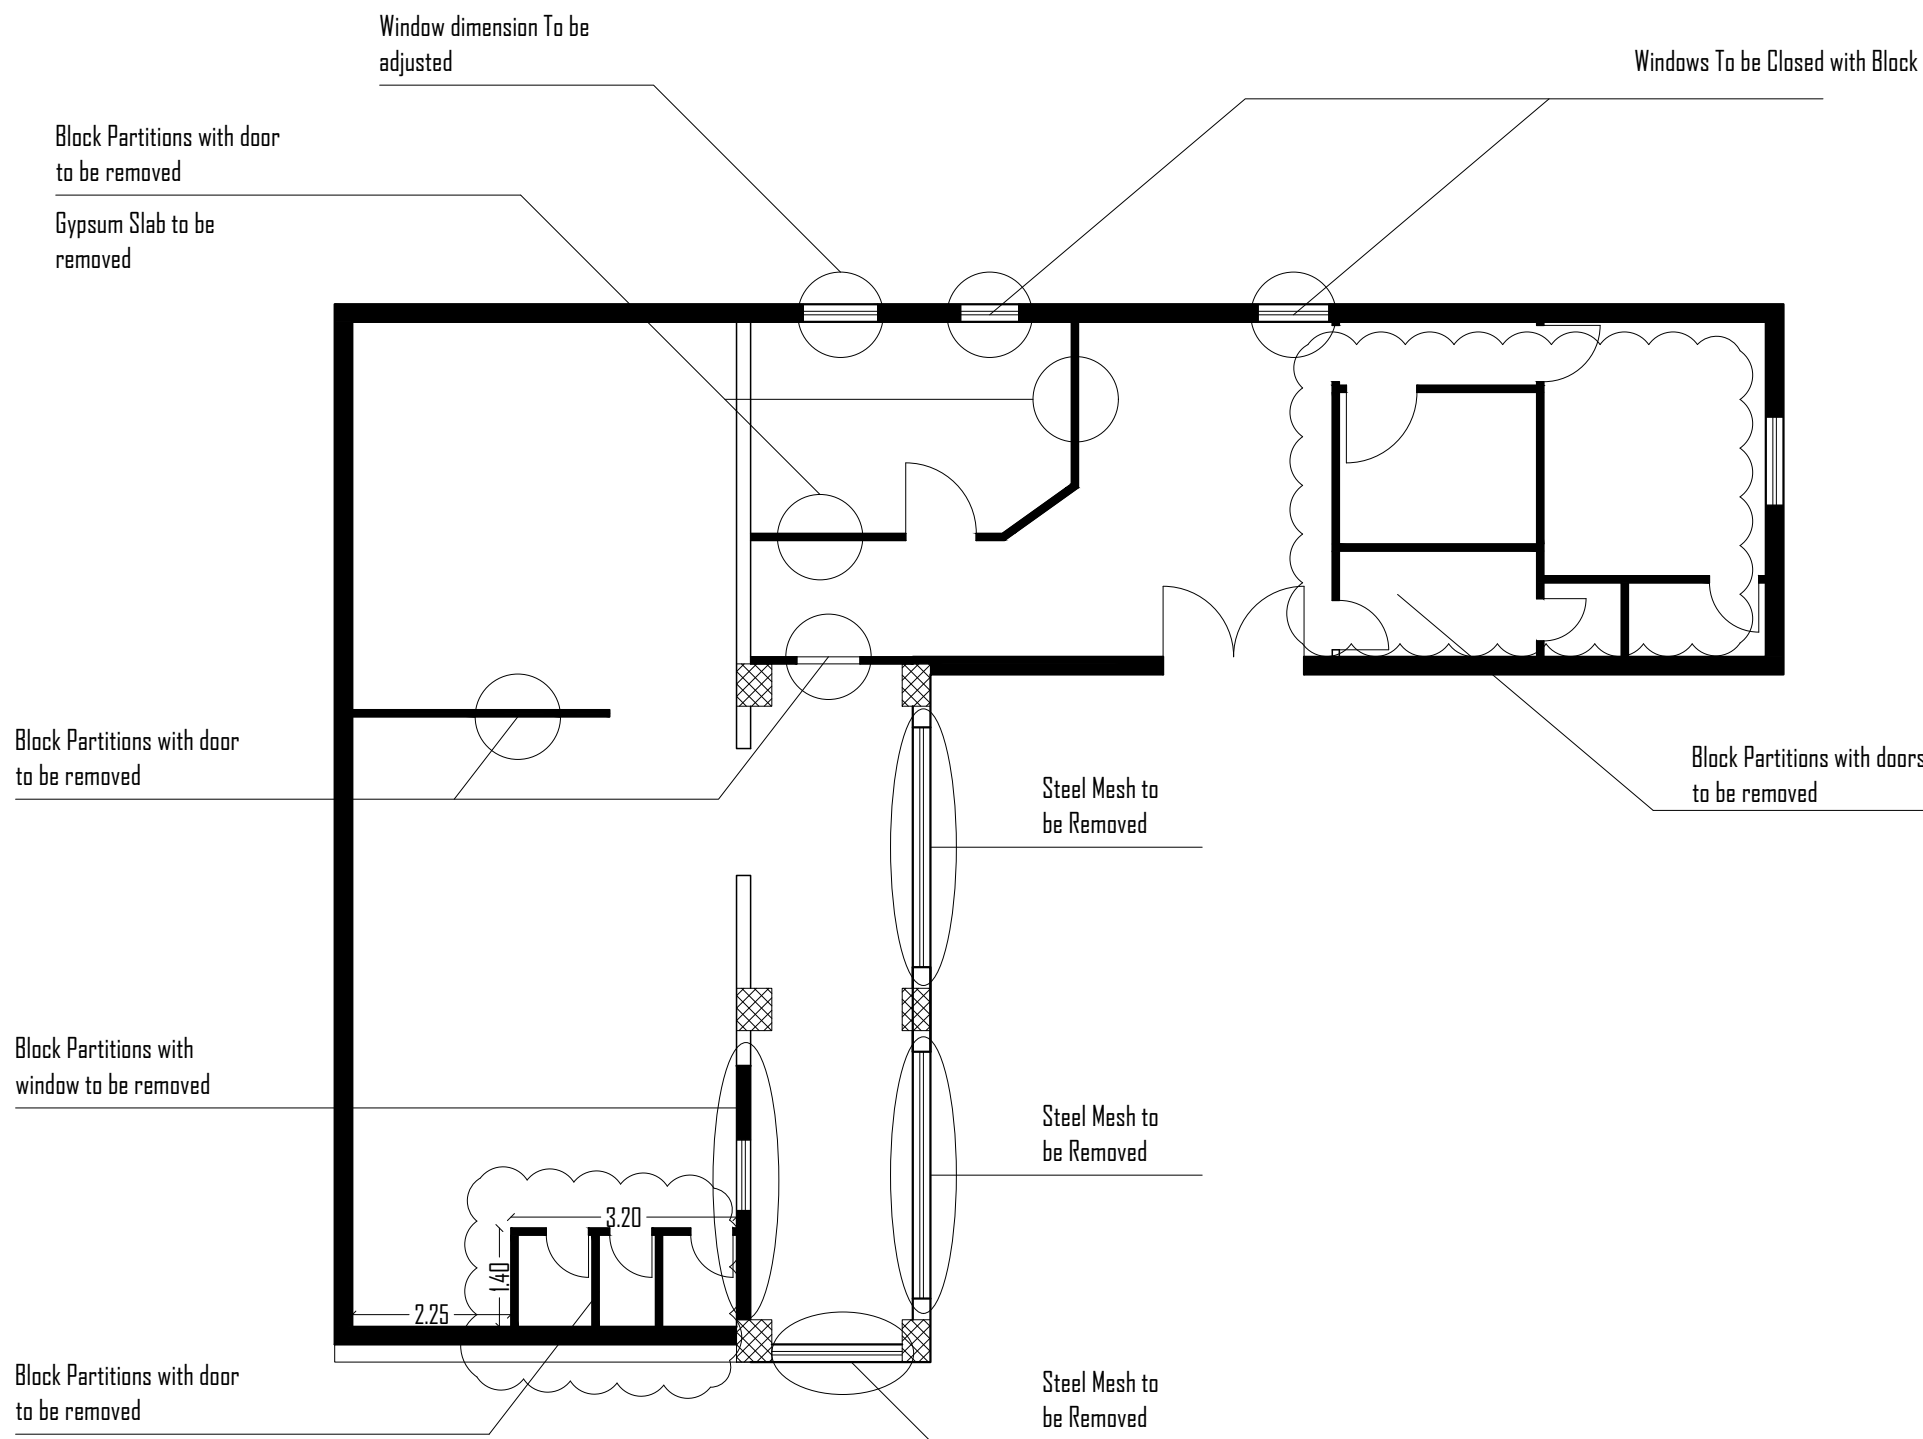

*All Existing Floor Tiles and Walls Tile to be Removed

LEGEND

1- EXISTING EXTERNAL WALL	
2- REINFORCED CONCRETE	
3- CONCRETE BLOCK WALL	
4- EXTERIOR PAVING	

NOTES

Rev.:	Date:	Description:	Approved:

All information in this document is the property of PALESTINIAN CIVIL POLICE and cannot be copied anywhere but in this project without prior written consent of PALESTINIAN CIVIL POLICE.

Partners:

The Independent Commission For Human Rights (ICHR)	PALESTINIAN CIVIL POLICE

Funded by:

	Kingdom of Norway
--	-------------------

Design & Implementation:

	QURIE ARCHITECTURE
--	--------------------

Project Name:

Detention Centers Rehabilitation Project in the West Bank (Norwegian Grant)


Title:

Al-Qalaa Detention Center

Drawings Title:

Demolition Plan

Project No.:	Phase:	Discipline:	Date:	Drawing No.:
000000	01	A	8.2021	A05
Drawn:	Checked:	Approved:	Size:	Scale:
			A3	1:1000

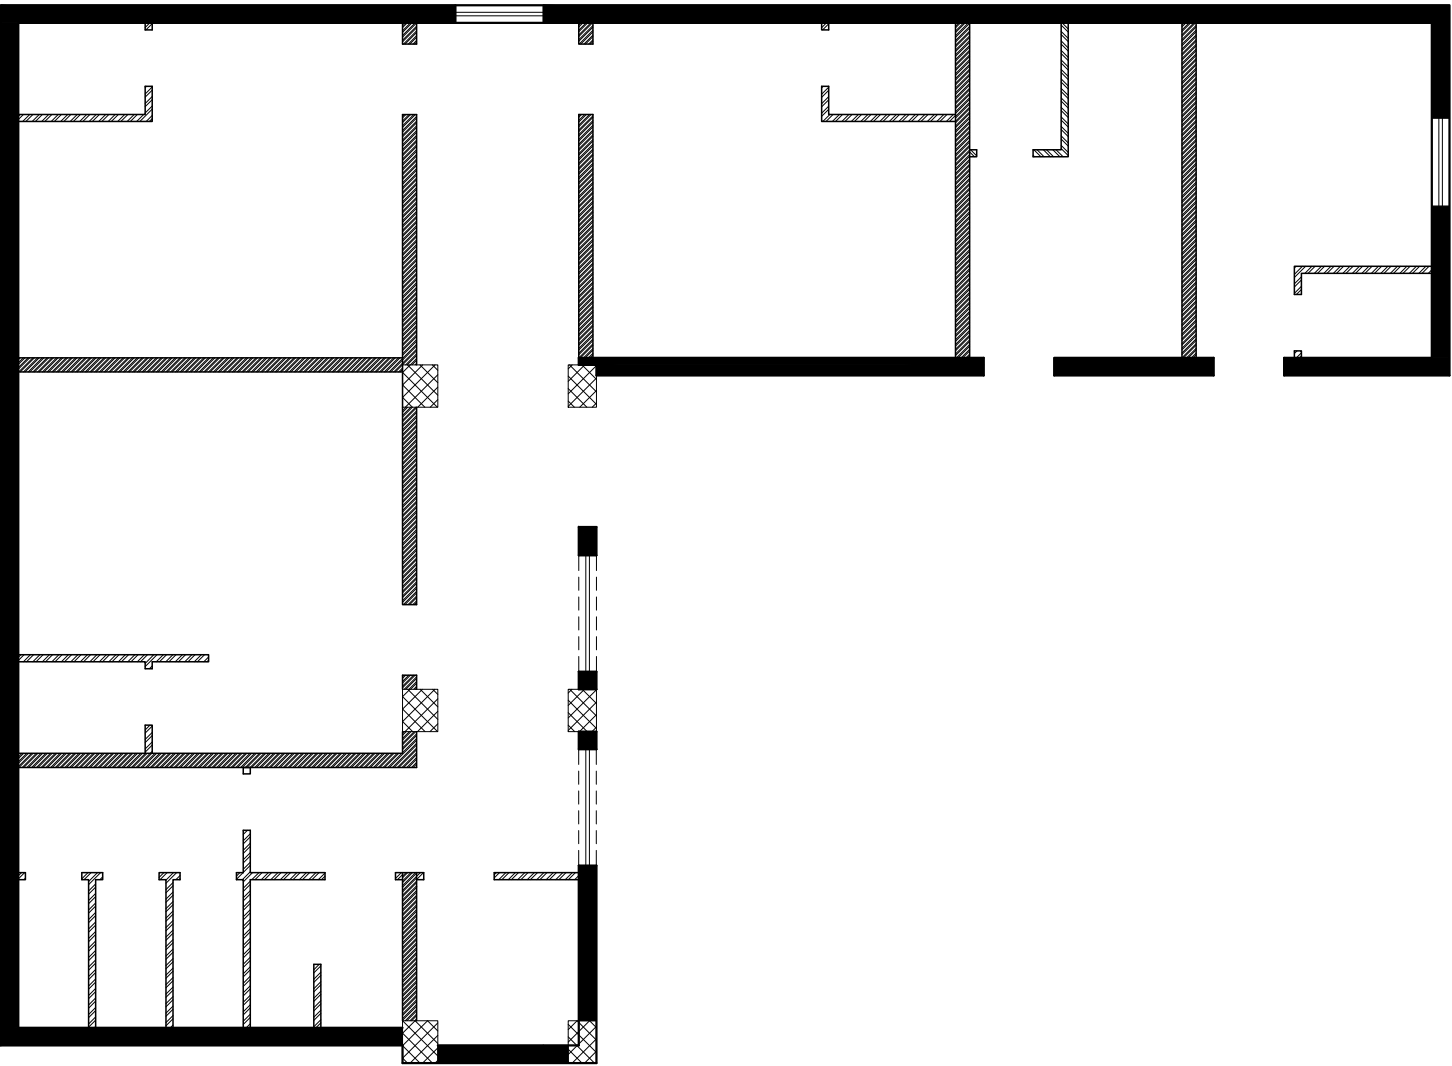

LEGEND

1- EXISTING EXTERNAL WALL	
2- REINFORCED CONCRETE	
3- CONCRETE BLOCK WALL	
4- EXTERIOR PAVING	

NOTES

Rev.:	Date:	Description:	Approved:
-------	-------	--------------	-----------

All information in this document is the property of PALESTINIAN CIVIL POLICE and cannot be copied anywhere but in this project without prior written consent of PALESTINIAN CIVIL POLICE.

Partners:


The Independent Commission
For Human Rights (ICHR)

PALESTINIAN CIVIL POLICE

Funded by:

 Kingdom of Norway

Design & Implementation:



QURIE

ARCHITECTURE

Project Name:

Detention Centers Rehabilitation
Project in the West Bank
(Norwegian Grant)


Title:

Al-Qalaa Detention Center

Drawings Title:

To Be Built Walls Plan

Project No.:	Phase:	Discipline:	Date:	Drawing No.:
000000	01	A	8.2021	A06
Drawn:	Checked:	Approved:	Size:	Scale:
			A3	1:100

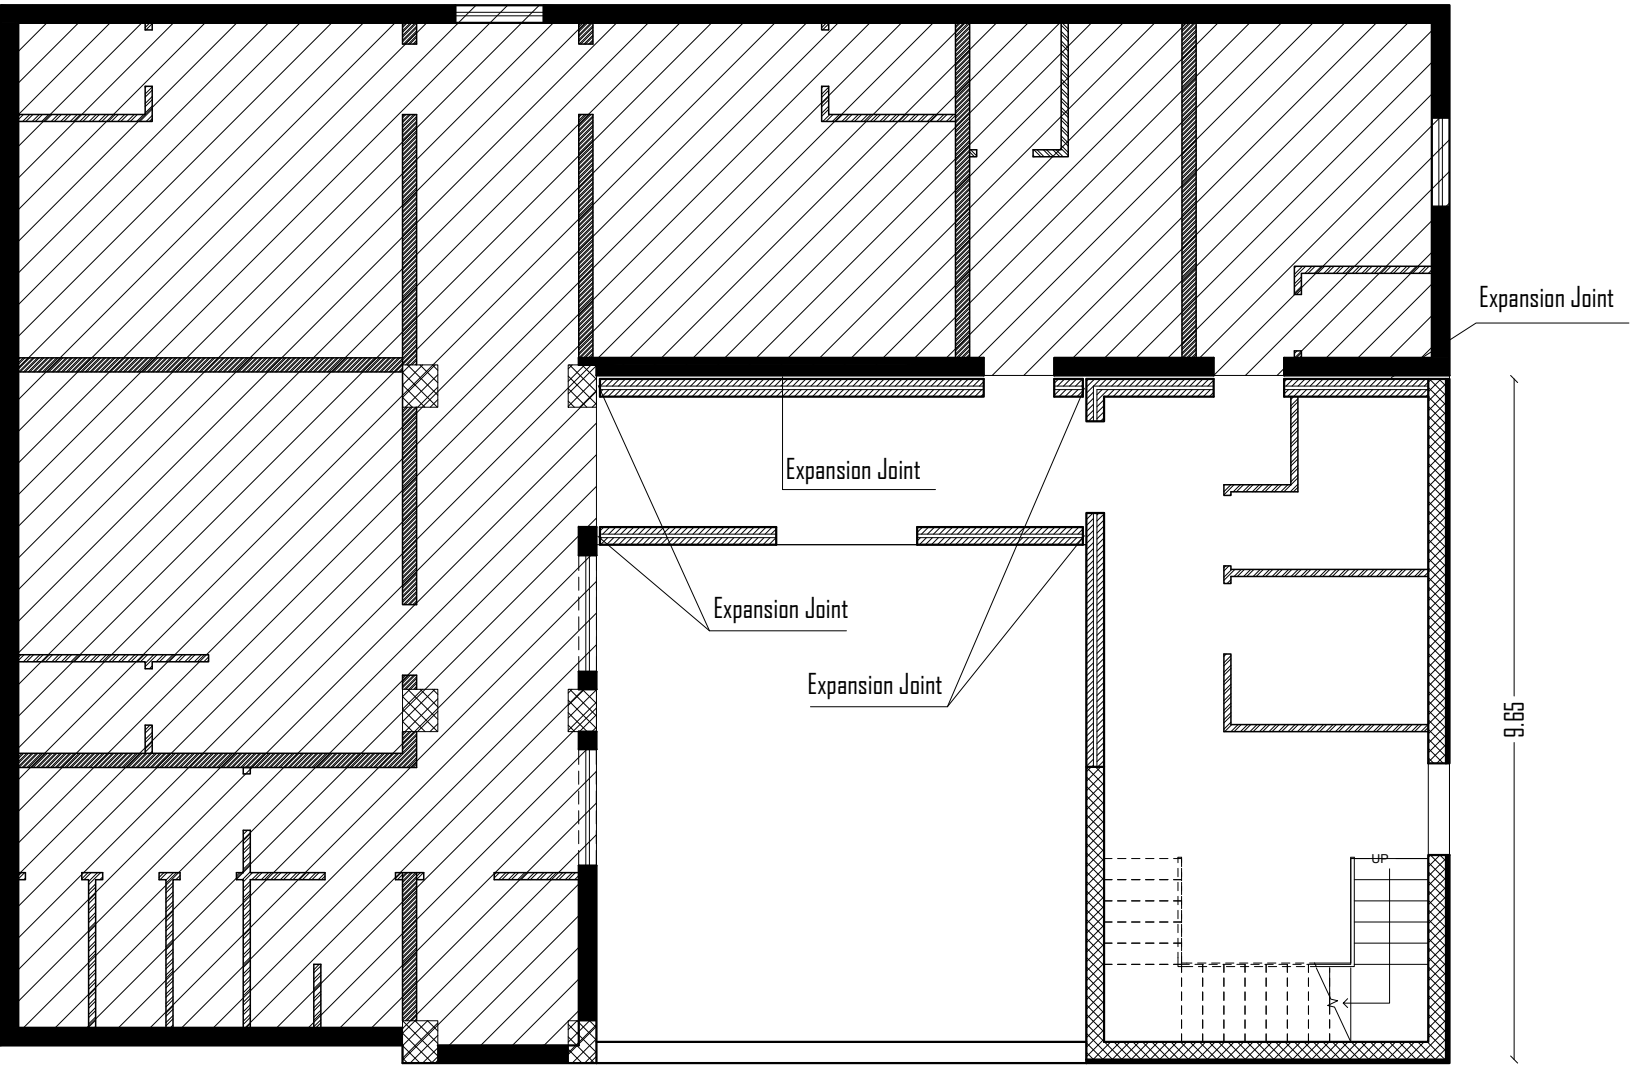

Proposed Heights :

H = 3.00m 'Clarence'

H = 3.25m FFL to FFL

LEGEND

1- EXISTING EXTERNAL WALL


2- REINFORCED CONCRETE

3- CONCRETE BLOCK WALL

4- EXTERIOR PAVING

NOTES

Rev.:	Date:	Description:	Approved:		
All information in this document is the property of PALESTINIAN CIVIL POLICE and cannot be copied anywhere but in this project without prior written consent of PALESTINIAN CIVIL POLICE.					
Partners:					
The Independent Commission For Human Rights (ICHR)		PALESTINIAN CIVIL POLICE			
Funded by:					
		Kingdom of Norway			
Design & Implementation:					
		QURIE ARCHITECTURE			
Project Name:					
Detention Centers Rehabilitation Project in the West Bank (Norwegian Grant)					
Title:					
Al-Qalaa Detention Center					
Drawings Title:					
Proposed Buildings Plan					
Project No.:	Phase:	Discipline:	Date:	Drawing No.:	
000000	01	A	8.2021	A07	
Drawn:	Checked:	Approved:	Size:	Scale:	Rev.:
			A3	1:100	

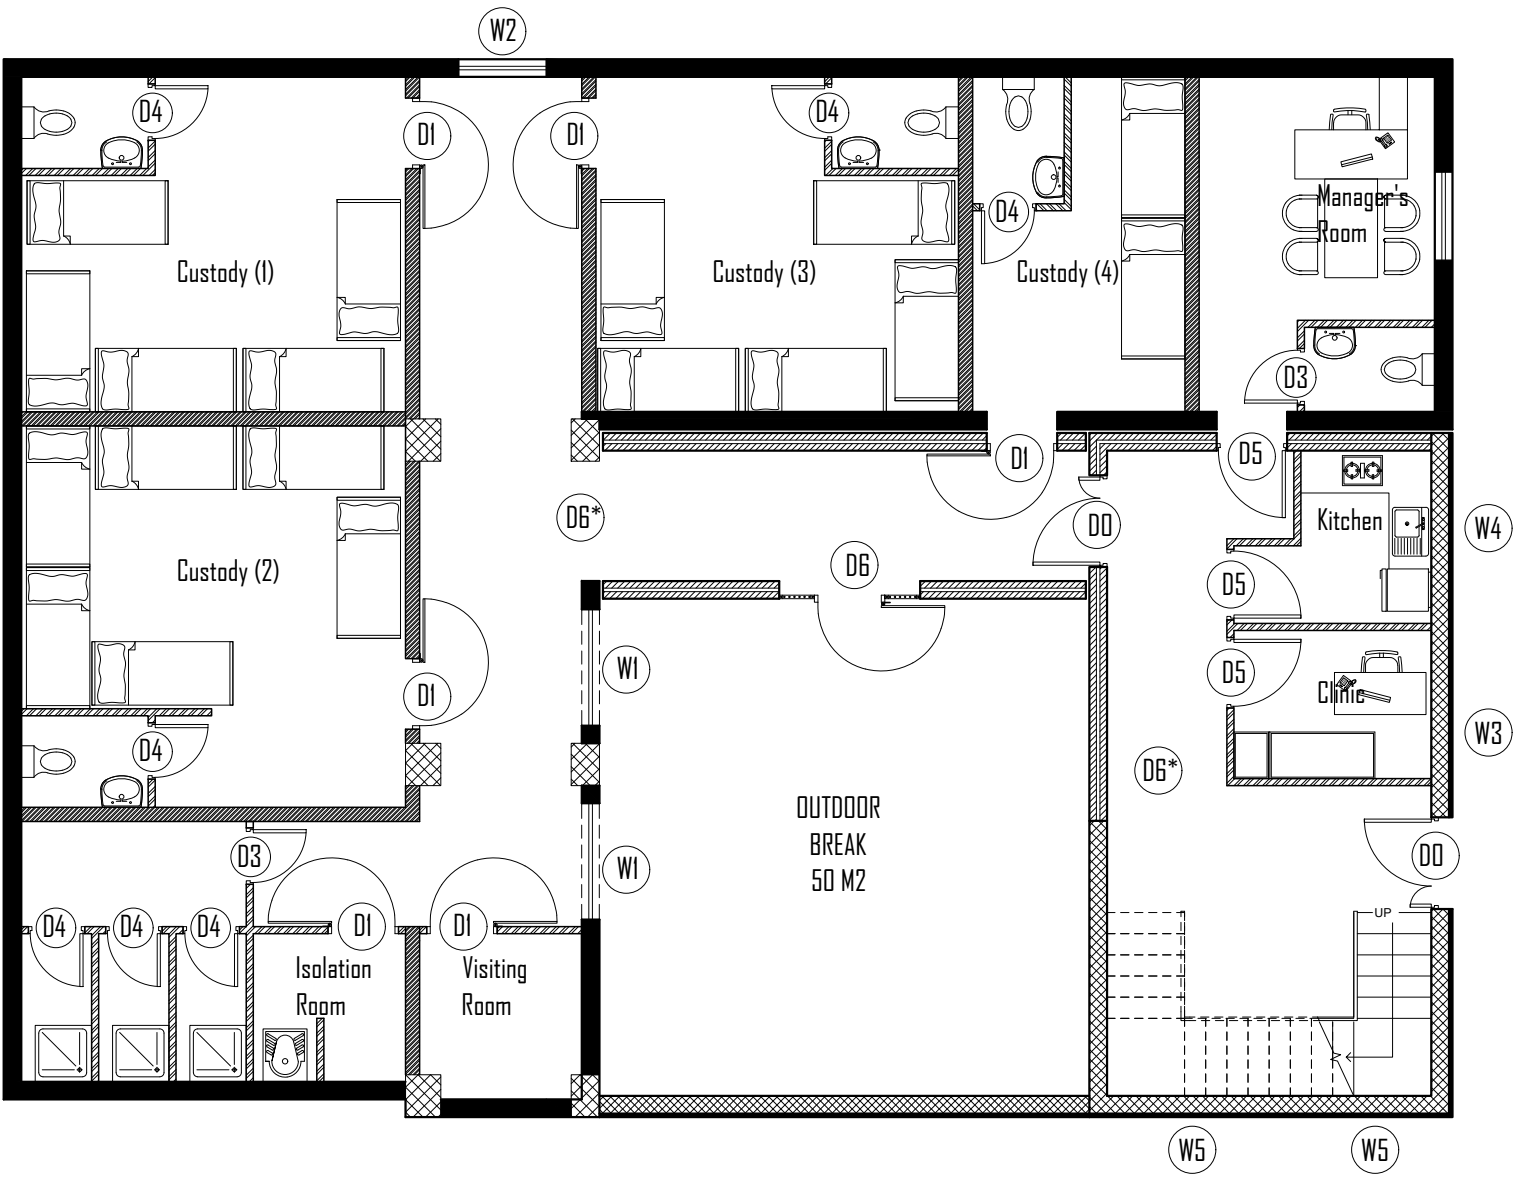

STRUCTURAL OPENING	WIDTH -cm	HIEGHT -cm
W1	165	As it exists
W2	125	250
W3	80	100
W4	100	100
W5	60	265
W6		

LEGEND

1- EXISTING EXTERNAL WALL	
2- REINFORCED CONCRETE	
3- CONCRETE BLOCK WALL	
4- EXTERIOR PAVING	

NOTES

Rev.: Date: Description: Approved:

All information in this document is the property of PALESTINIAN CIVIL POLICE and cannot be copied anywhere but in this project without prior written consent of PALESTINIAN CIVIL POLICE.

Partners:

The Independent Commission
For Human Rights (ICHR)

PALESTINIAN CIVIL POLICE



Funded by:



Kingdom of Norway

Design & Implementation:



QURIE
ARCHITECTURE

Project Name:

Detention Centers Rehabilitation
Project in the West Bank
(Norwegian Grant)


Title:

Al-Qalaa Detention Center

Drawings Title:

Proposed Furniture Plan

Project No.:	Phase:	Discipline:	Date:	Drawing No.:
000000	01	A	8.2021	A08
Drawn:	Checked:	Approved:	Size:	Scale:
			A3	1:100

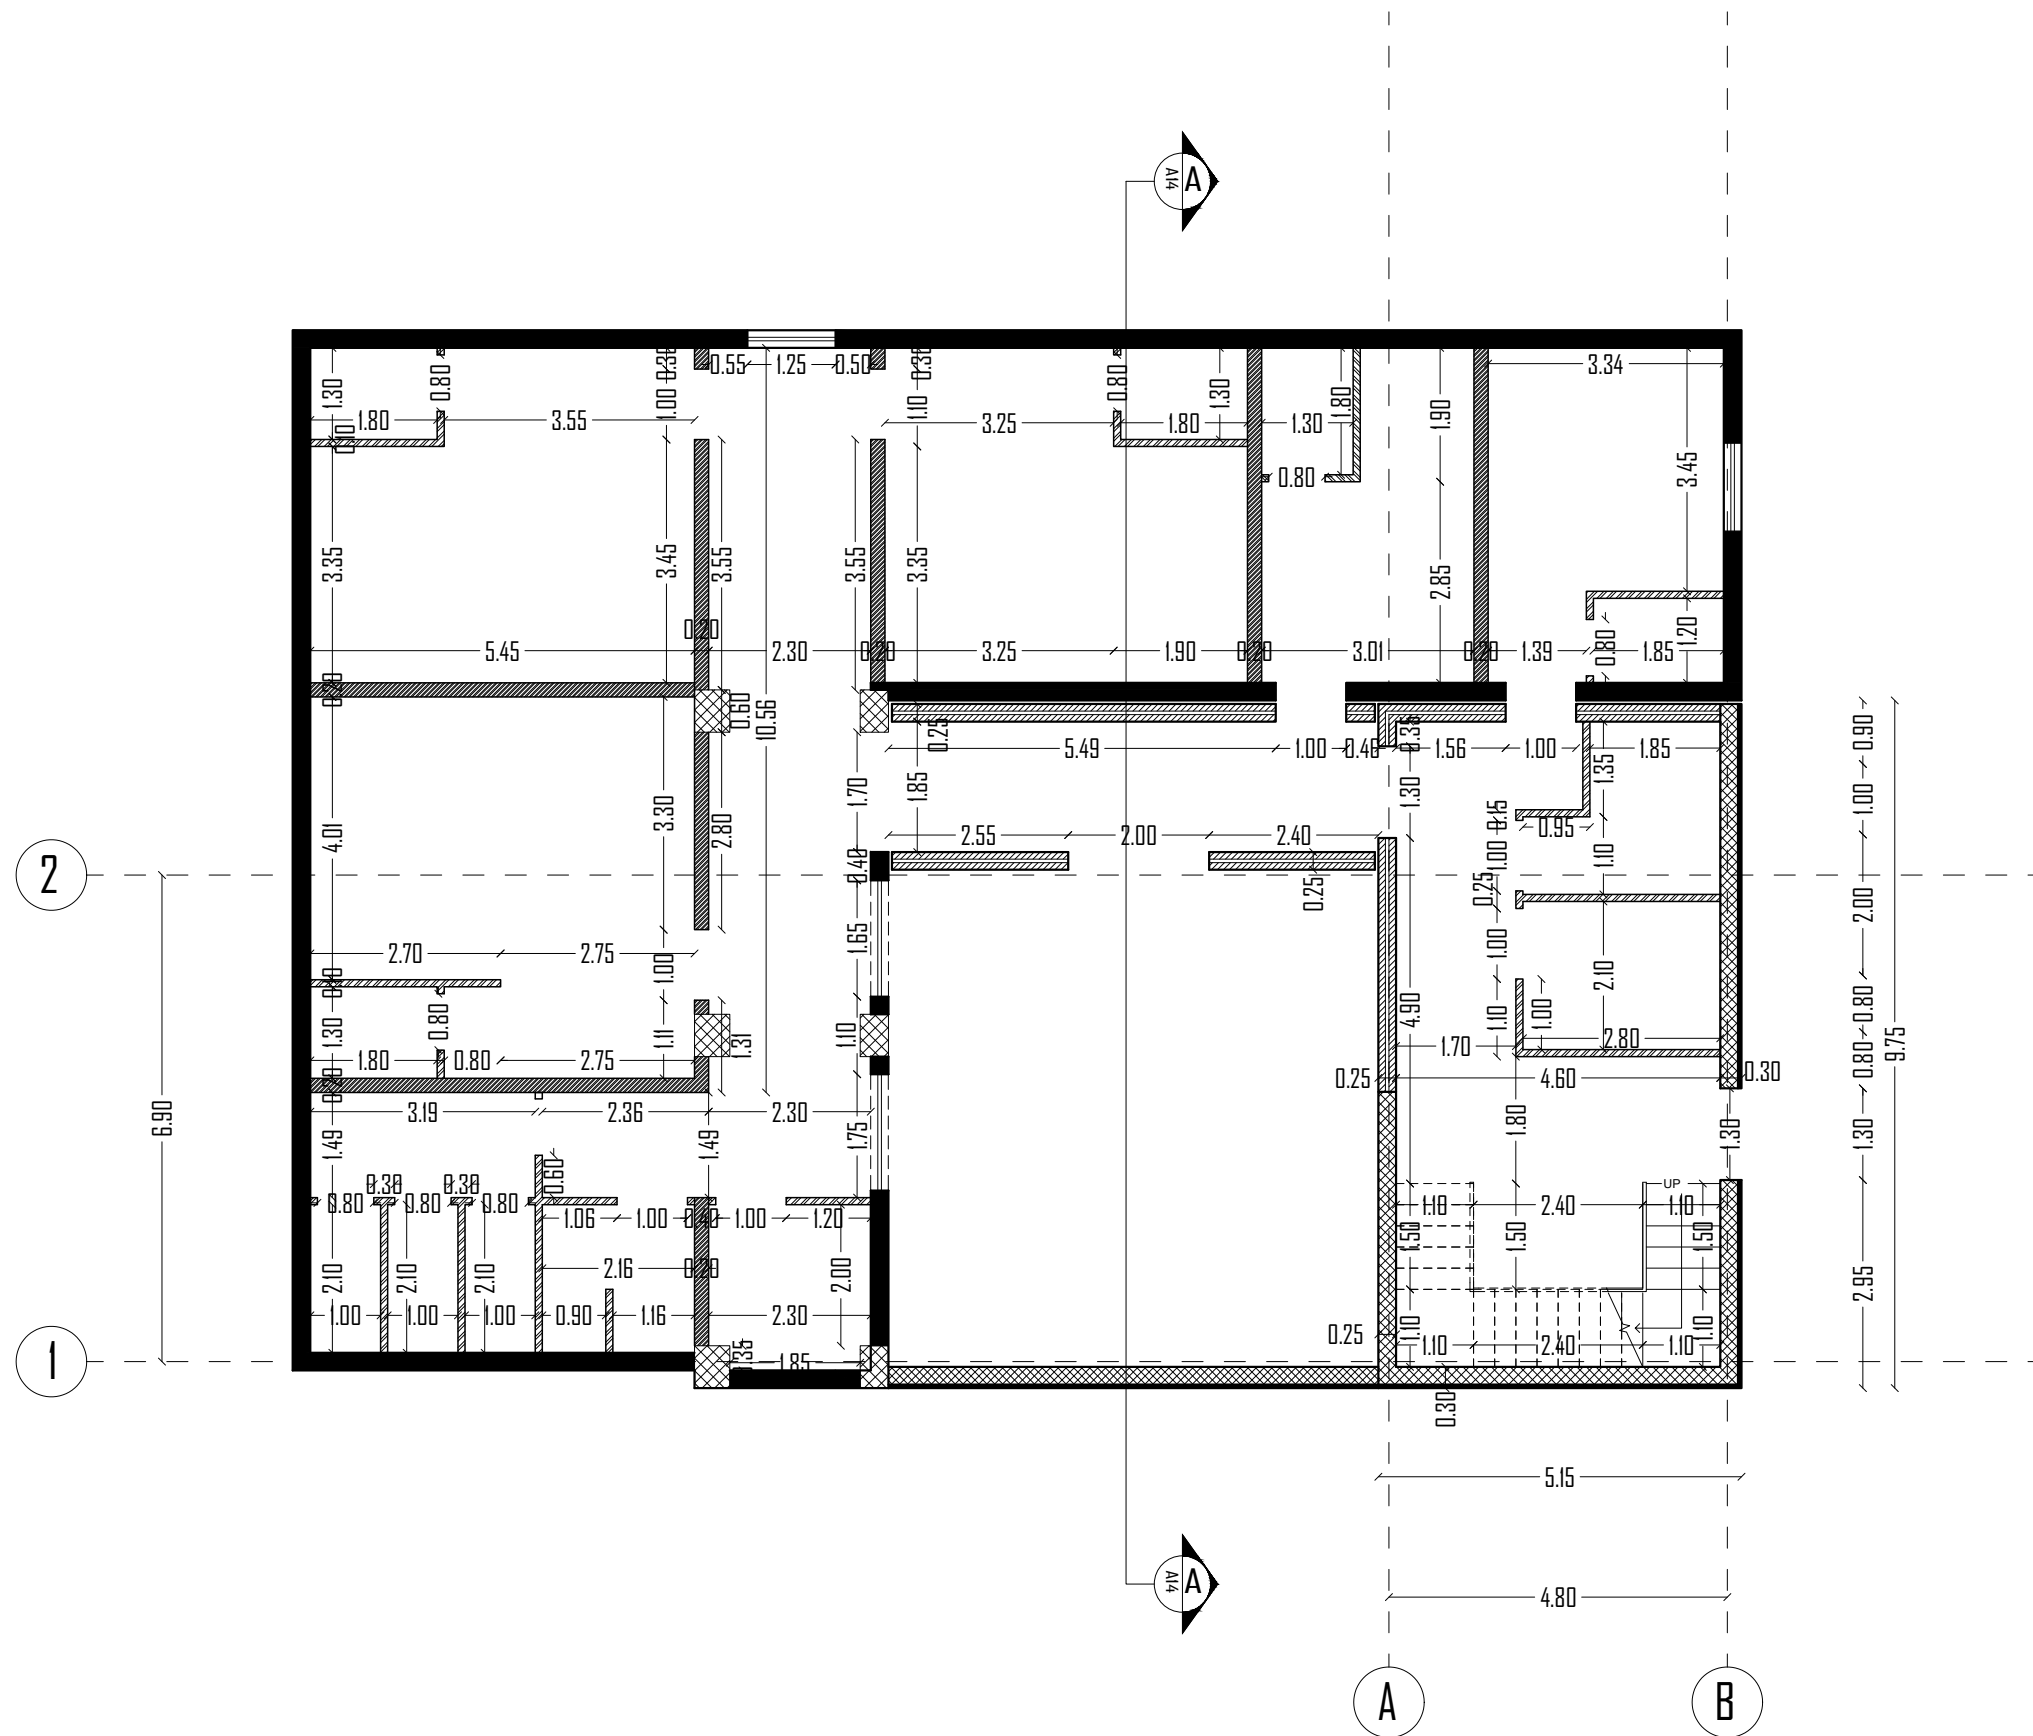

LEGEND

1- EXISTING EXTERNAL WALL

2- REINFORCED CONCRETE

3- CONCRETE BLOCK WALL

4- EXTERIOR PAVING

NOTES

Rev.:

Date:

Description:

Approved:


All information in this document is the property of PALESTINIAN CIVIL POLICE and cannot be copied anywhere but in this project without prior written consent of PALESTINIAN CIVIL POLICE.

Partners:


The Independent Commission For Human Rights (ICHR)

PALESTINIAN CIVIL POLICE

Funded by:

Kingdom of Norway

Design & Implementation:



QURIE
ARCHITECTURE

Project Name:

Detention Centers Rehabilitation Project in the West Bank (Norwegian Grant)

Title:

Al-Qalaa Detention Center

Drawings Title:

Proposed Dimensional Plan

Project No.:

000000

Phase:

01

Discipline:

A

Date:

8.2021

Drawing No.:

A09

Drawn:

Checked:

Approved:


Size:

A3

Scale:

1:100

Rev.:

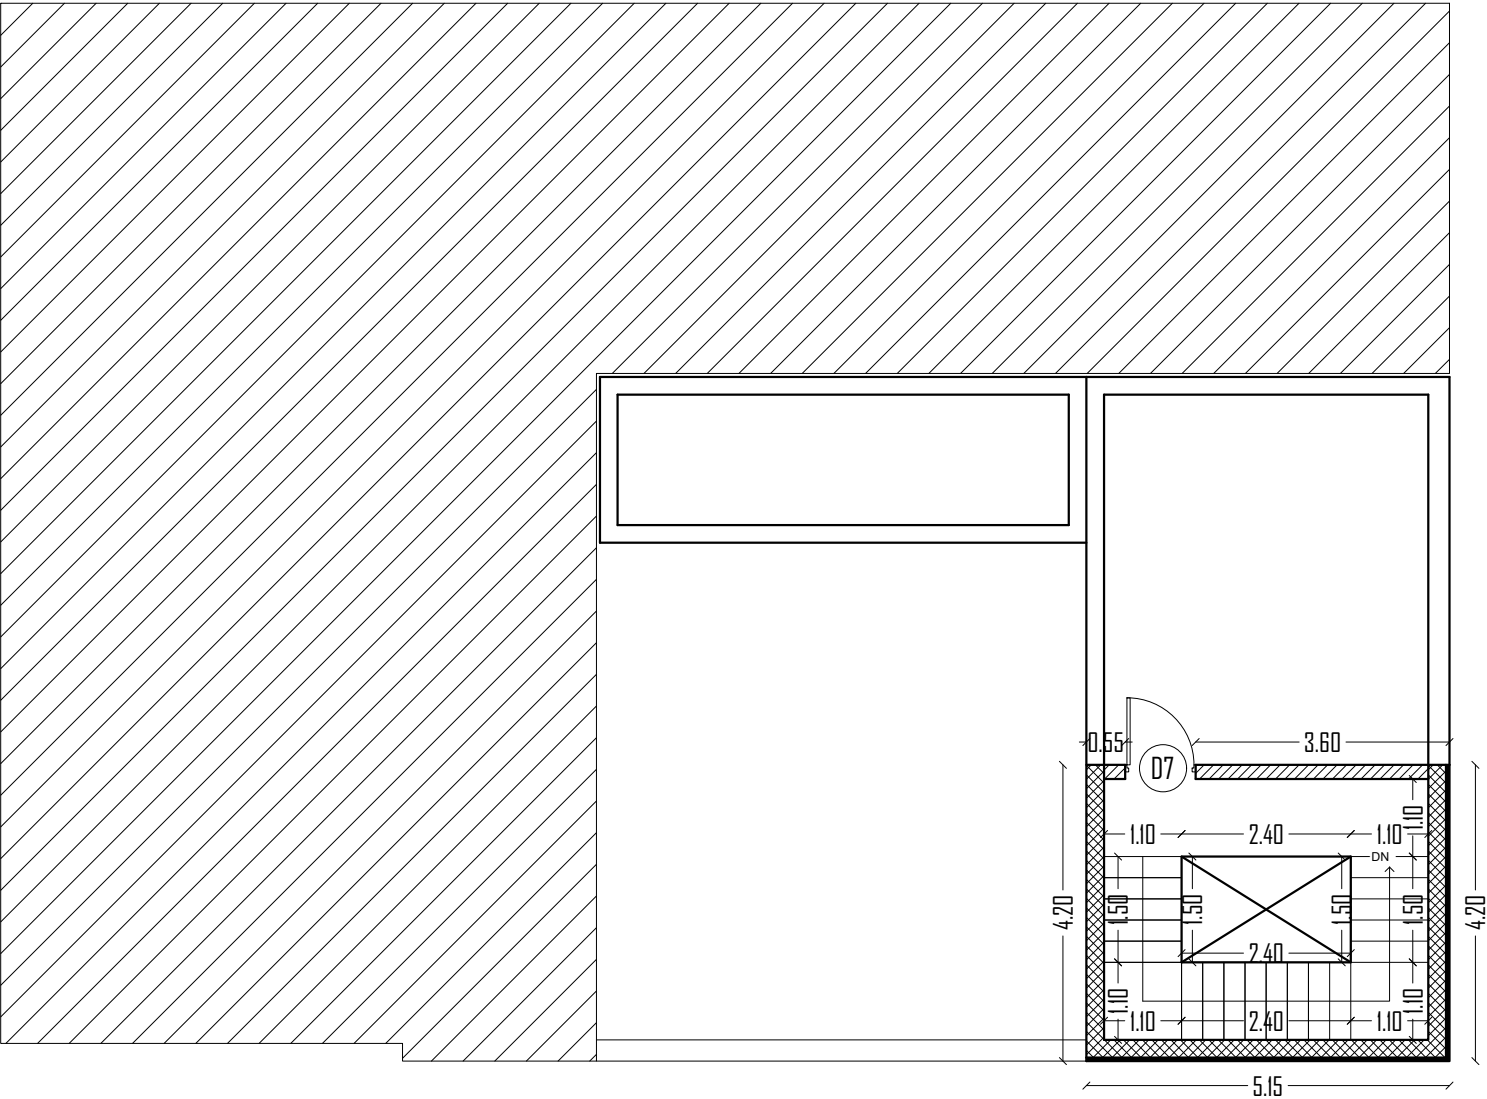

LEGEND

1- EXISTING EXTERNAL WALL	
2- REINFORCED CONCRETE	
3- CONCRETE BLOCK WALL	
4- EXTERIOR PAVING	

NOTES

Rev.:	Date:	Description:	Approved:
-------	-------	--------------	-----------

All information in this document is the property of PALESTINIAN CIVIL POLICE and cannot be copied anywhere but in this project without prior written consent of PALESTINIAN CIVIL POLICE.

Partners:

The Independent Commission For Human Rights (ICHR)	PALESTINIAN CIVIL POLICE

Funded by:

	Kingdom of Norway
--	-------------------

Design & Implementation:

	QURIE ARCHITECTURE
--	-----------------------

Project Name:

Detention Centers Rehabilitation
Project in the West Bank
(Norwegian Grant)


Title:

Al-Qalaa Detention Center

Drawings Title:

Proposed Staircase
Furniture & Dimensional Plan

Project No.:	Phase:	Discipline:	Date:	Drawing No.:
000000	01	A	8.2021	A10
Drawn:	Checked:	Approved:	Size:	Scale:
			A3	1:100

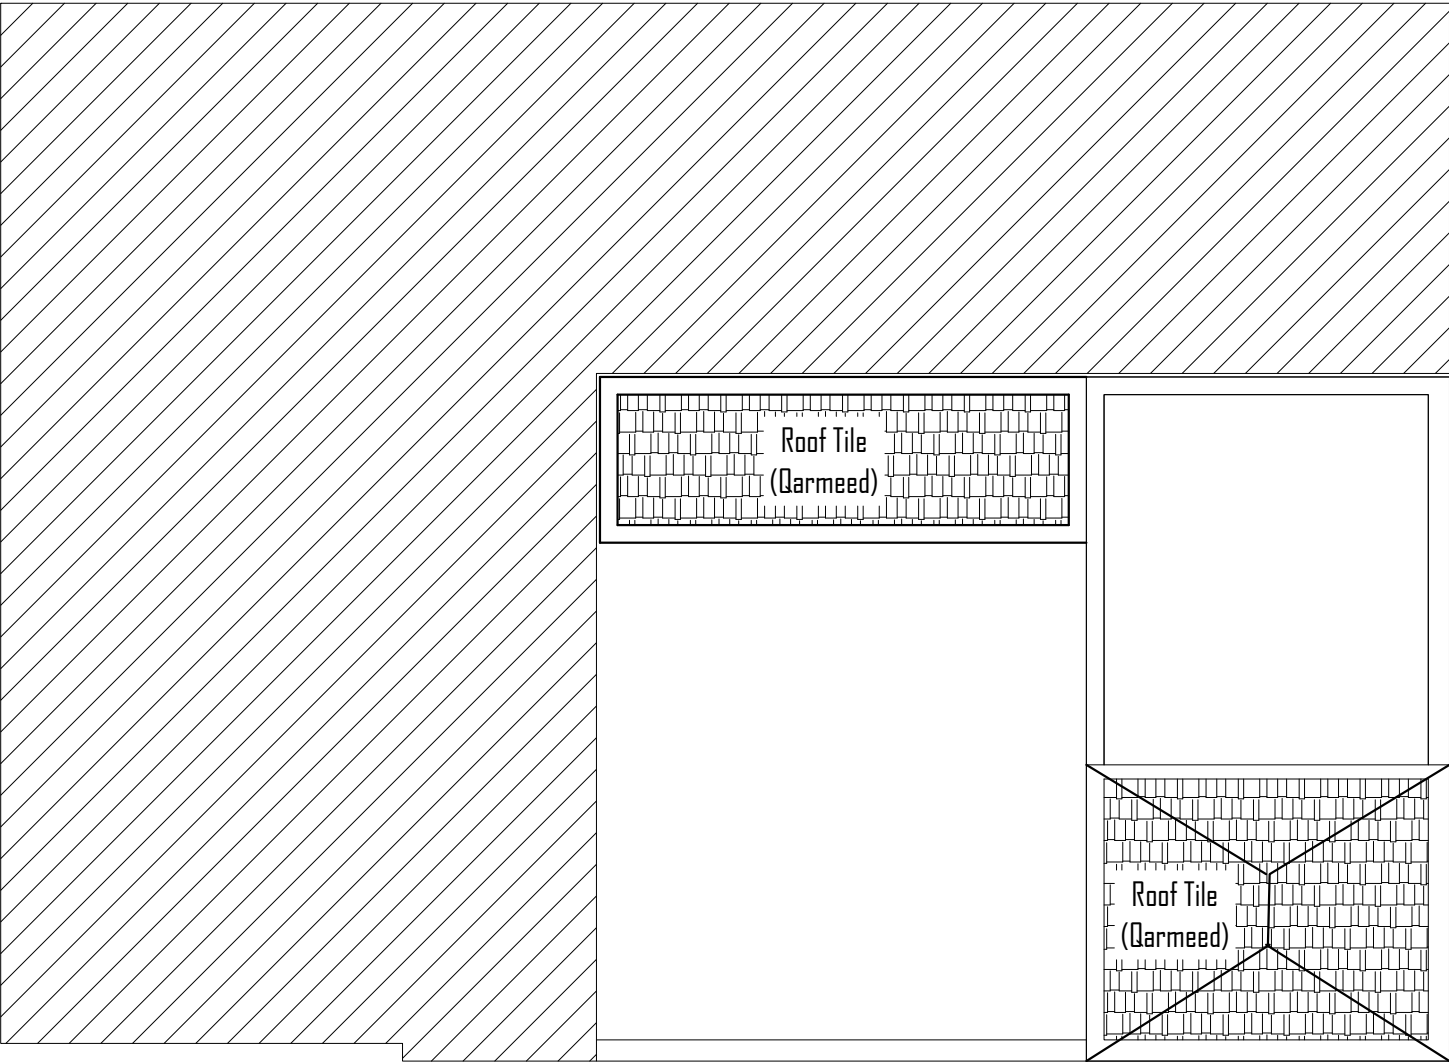

LEGEND



1- EXISTING EXTERNAL WALL	
2- REINFORCED CONCRETE	
3- CONCRETE BLOCK WALL	
4- EXTERIOR PAVING	

NOTES


Rev.:	Date:	Description:	Approved:
-------	-------	--------------	-----------

All information in this document is the property of PALESTINIAN CIVIL POLICE and cannot be copied anywhere but in this project without prior written consent of PALESTINIAN CIVIL POLICE.


Partners:

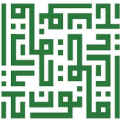The Independent Commission For Human Rights (ICHR)	PALESTINIAN CIVIL POLICE
	

Funded by:

	Kingdom of Norway
---	-------------------

Design & Implementation:

	QURIE ARCHITECTURE
---	-----------------------

Project Name:

Detention Centers Rehabilitation
Project in the West Bank
(Norwegian Grant)


Title:

Al-Qalaa Detention Center

Drawings Title:

Proposed Staircase Roof

Project No.:	Phase:	Discipline:	Date:	Drawing No.:
000000	01	A	8.2021	A11
Drawn:	Checked:	Approved:	Size:	Scale:
			A3	1:100

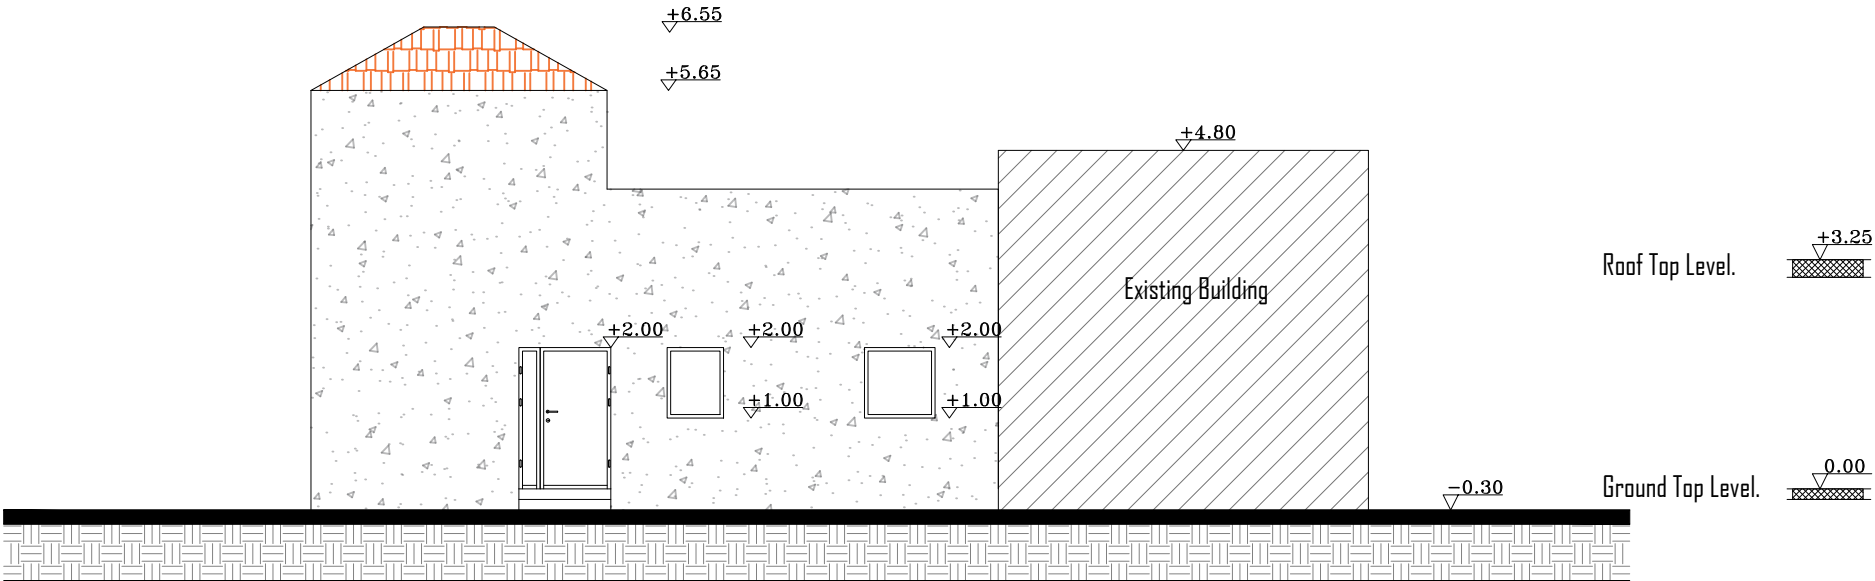



LEGEND

1- EXISTING EXTERNAL WALL	
2- REINFORCED CONCRETE	
3- CONCRETE BLOCK WALL	
4- EXTERIOR PAVING	


NOTES

Rev.:	Date:	Description:	Approved:
-------	-------	--------------	-----------

All information in this document is the property of PALESTINIAN CIVIL POLICE and cannot be copied anywhere but in this project without prior written consent of PALESTINIAN CIVIL POLICE.

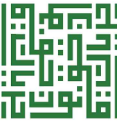Partners:	
The Independent Commission For Human Rights (ICHR)	PALESTINIAN CIVIL POLICE
	

Funded by:	
	Kingdom of Norway


Design & Implementation:	
	QURIE ARCHITECTURE

Project Name:	
Detention Centers Rehabilitation Project in the West Bank (Norwegian Grant)	

Title:	
Al-Qalaa Detention Center	

Drawings Title:	
Northern Elevation	

Project No.:	Phase:	Discipline:	Date:	Drawing No.:
000000	01	A	11.2021	A12
Drawn:	Checked:	Approved:	Size:	Scale:
			A3	1:100

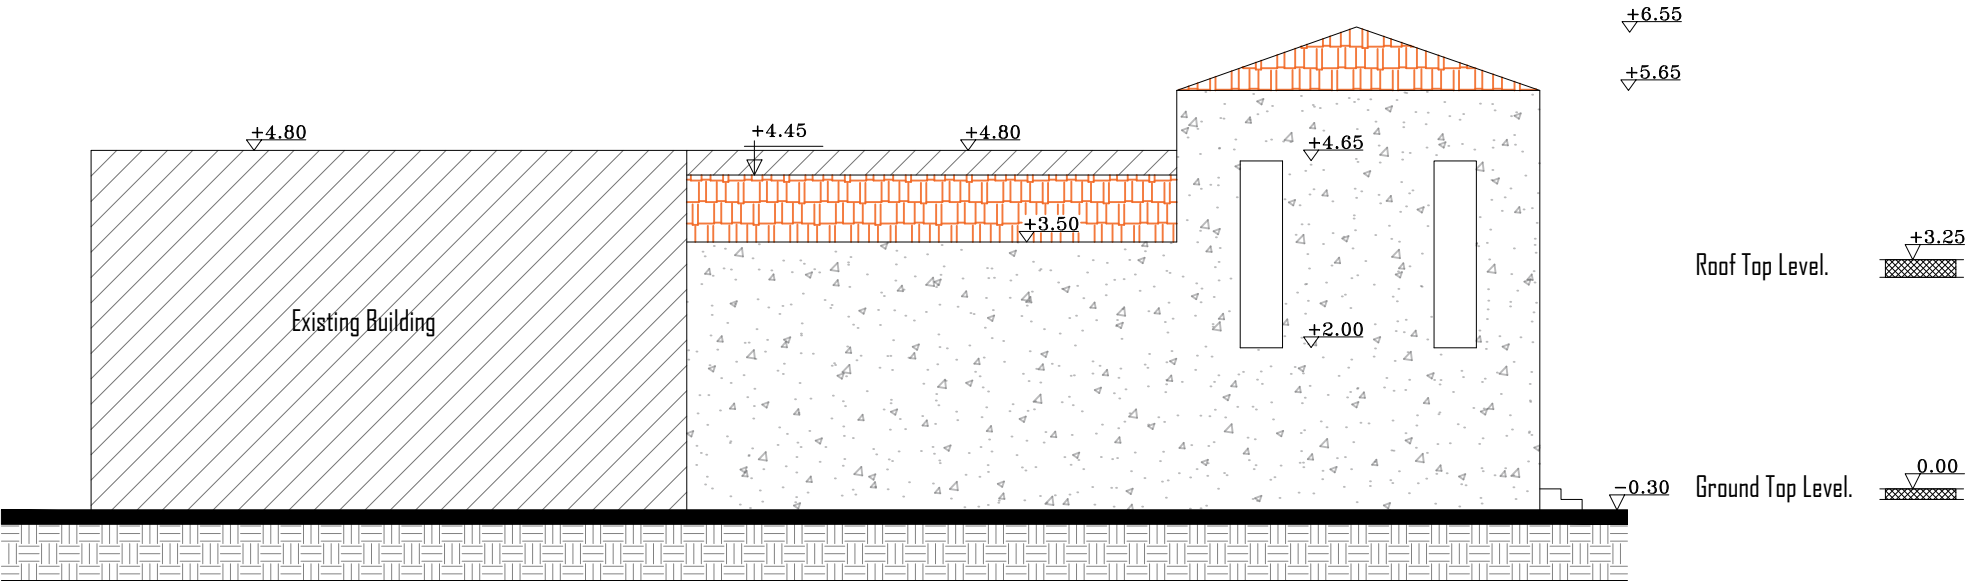

LEGEND

1- EXISTING EXTERNAL WALL	
2- REINFORCED CONCRETE	
3- CONCRETE BLOCK WALL	
4- EXTERIOR PAVING	

NOTES

Rev.:	Date:	Description:	Approved:
-------	-------	--------------	-----------

All information in this document is the property of PALESTINIAN CIVIL POLICE and cannot be copied anywhere but in this project without prior written consent of PALESTINIAN CIVIL POLICE.

Partners:

The Independent Commission For Human Rights (ICHR)	PALESTINIAN CIVIL POLICE

Funded by:

	Kingdom of Norway
--	-------------------

Design & Implementation:

	QURIE ARCHITECTURE
--	-----------------------

Project Name:

Detention Centers Rehabilitation
Project in the West Bank
(Norwegian Grant)


Title:

Al-Qalaa Detention Center

Drawings Title:

Eastern Elevation

Project No.:	Phase:	Discipline:	Date:	Drawing No.:
000000	01	A	11.2021	A13
Drawn:	Checked:	Approved:	Size:	Scale:
			A3	1:100

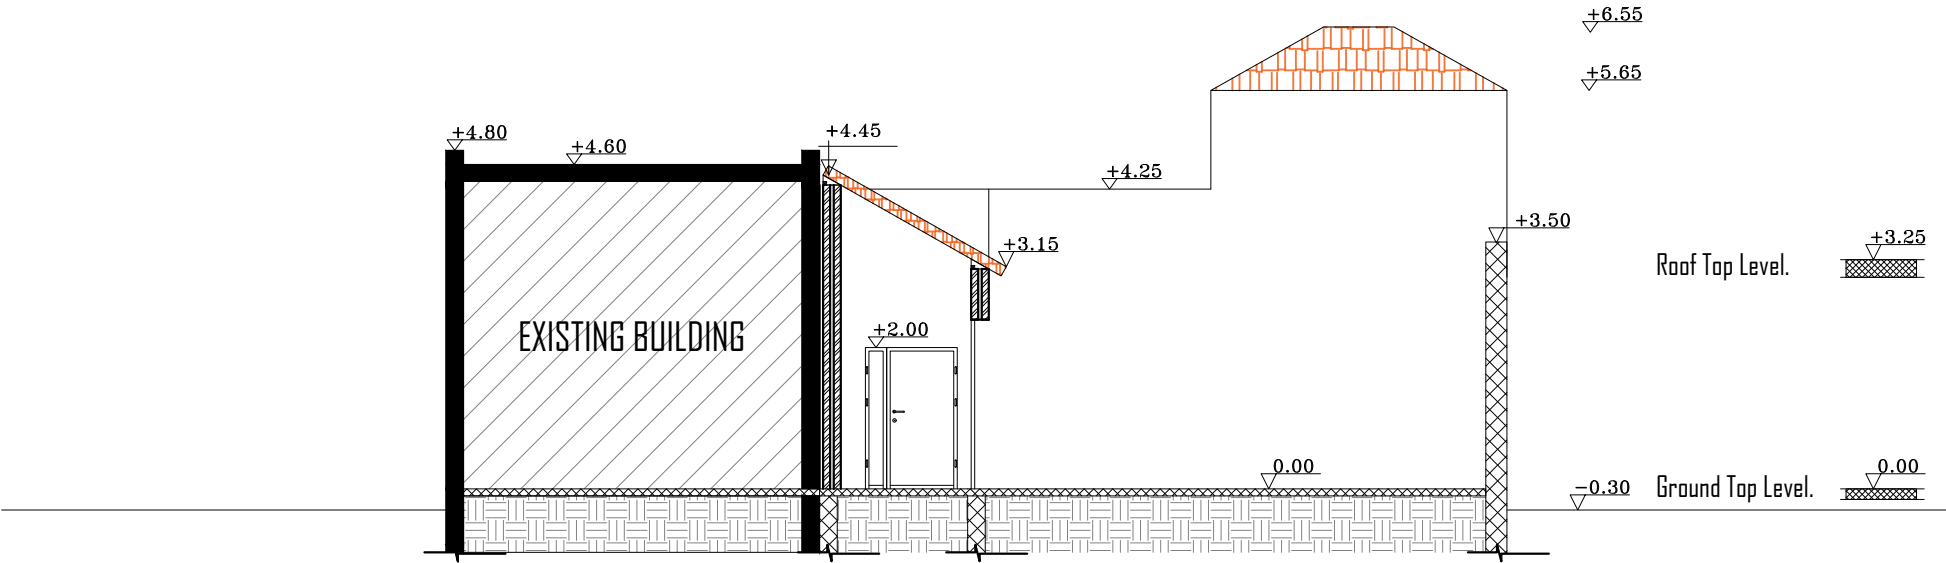

LEGEND

1- EXISTING EXTERNAL WALL	
2- REINFORCED CONCRETE	
3- CONCRETE BLOCK WALL	
4- EXTERIOR PAVING	

NOTES

Rev.:	Date:	Description:	Approved:
-------	-------	--------------	-----------

All information in this document is the property of PALESTINIAN CIVIL POLICE and cannot be copied anywhere but in this project without prior written consent of PALESTINIAN CIVIL POLICE.

Partners:

The Independent Commission
For Human Rights (ICHR)

PALESTINIAN CIVIL POLICE

Funded by:

Kingdom of Norway

Design & Implementation:

QURIE
ARCHITECTURE

Project Name:

Detention Centers Rehabilitation
Project in the West Bank
(Norwegian Grant)

Title:

Al-Qalaa Detention Center

Drawings Title:

Section A-A

Project No.:	Phase:	Discipline:	Date:	Drawing No.:
000000	01	A	11.2021	A14
Drawn:	Checked:	Approved:	Size:	Scale:
			A3	

LIST OF DRAWINGS

ARCHITECTURAL DRAWINGS

NO.	DRAWING TITLE
S00	LIST OF DRAWINGS
S01	DESIGN PARAMETERS
S02	FOUNDATION PLAN
S03	FOOTING RC DETAILS
S04	FOOTING RC DETAILS
S05	FOOTING RC DETAILS
S06	COLUMNS RC DETAILS
S07	SLAB REINFORCEMENT
S08	BEAM RC DETAILS (1)
S09	BEAM RC DETAILS (2)
S10	STAIRS RC DETAIL (1)
S11	STAIRS RC DETAIL (1)

LEGEND

1- EXISTING EXTERNAL WALL

2- REINFORCED CONCRETE

3- CONCRETE BLOCK WALL

4- EXTERIOR PAVING

NOTES

Rev.:

Date:

Description:

Approved:

All information in this document is the property of PALESTINIAN CIVIL POLICE and cannot be copied anywhere but in this project without prior written consent of PALESTINIAN CIVIL POLICE.

Partners:

The Independent Commission For Human Rights (ICHR)

PALESTINIAN CIVIL POLICE

Funded by:

Kingdom of Norway

Design & Implementation:

QURIE
ARCHITECTURE

Project Name:

Detention Centers Rehabilitation Project in the West Bank (Norwegian Grant)

Title:

Al-Qalaa Detention Center

Drawings Title:

List Of Drawings

Project No.:

Phase:

Discipline:

Date:

Drawing No.:

00000

01

A

8.2021

S00

Drawn:

Checked:


Approved:

Size:

Scale:

Rev.:

A3

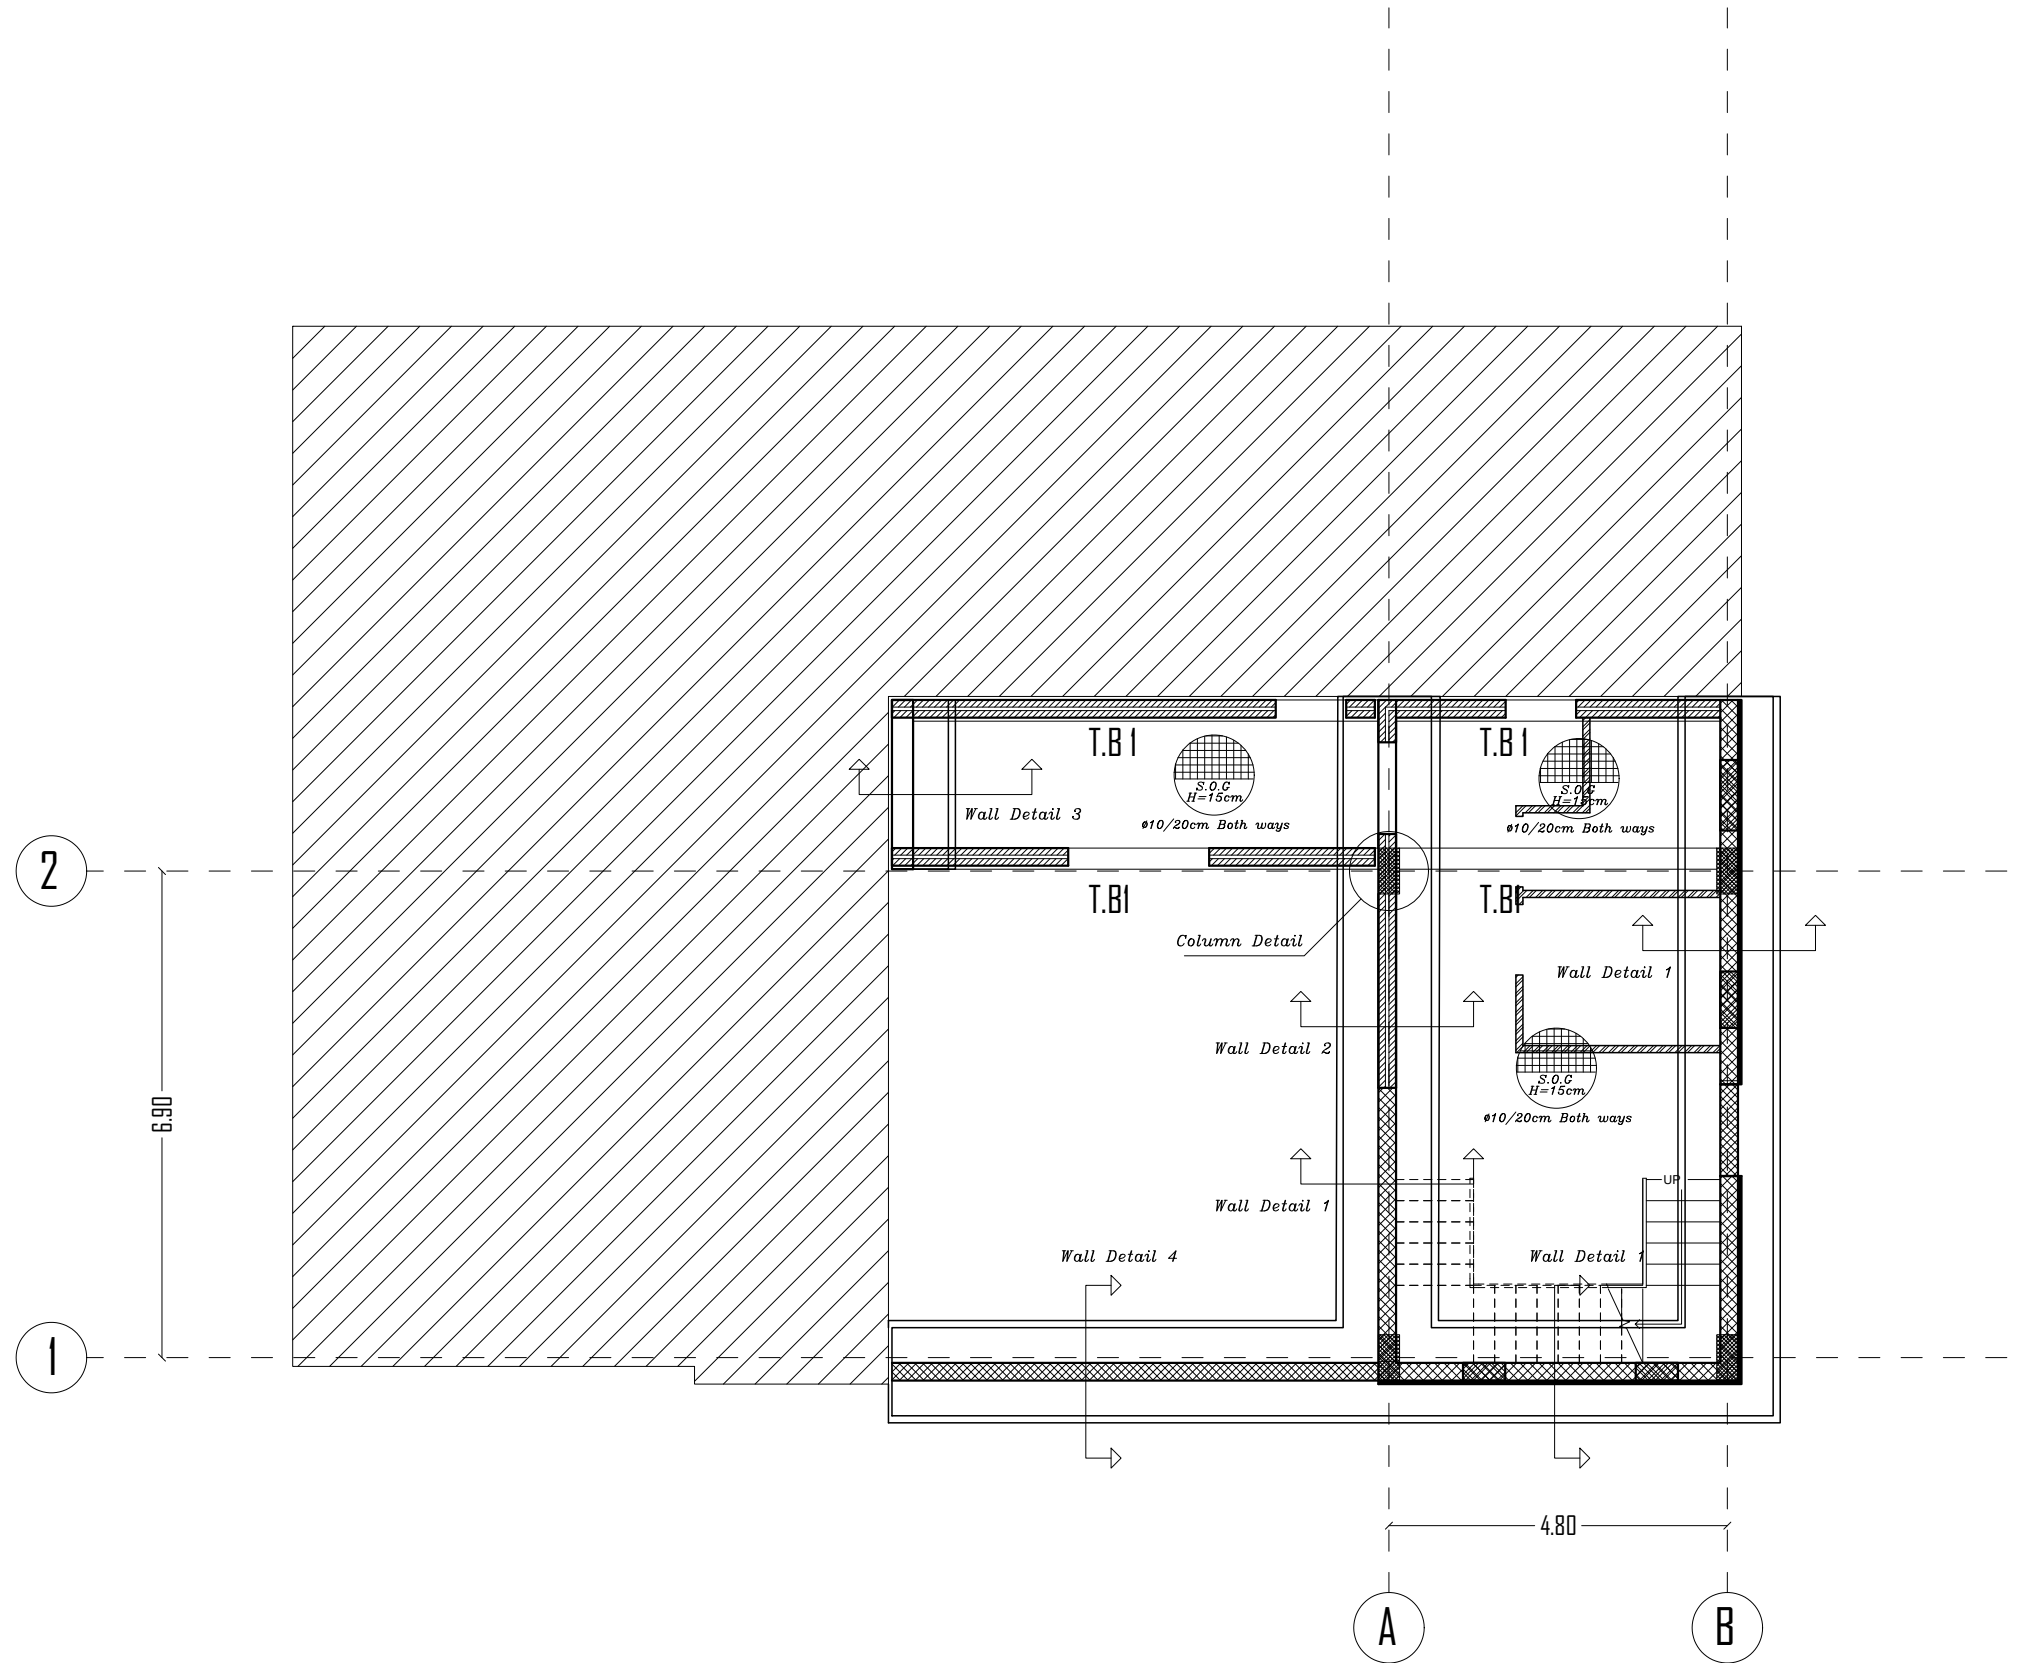


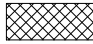






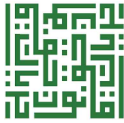



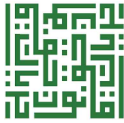



LEGEND




1- EXISTING EXTERNAL WALL	
2- REINFORCED CONCRETE	
3- CONCRETE BLOCK WALL	
4- EXTERIOR PAVING	

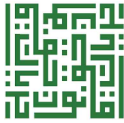NOTES





Rev.:	Date:	Description:	Approved:		
All information in this document is the property of PALESTINIAN CIVIL POLICE and cannot be copied anywhere but in this project without prior written consent of PALESTINIAN CIVIL POLICE.					
Partners:					
The Independent Commission For Human Rights (ICHR)		PALESTINIAN CIVIL POLICE			
Funded by:					
		Kingdom of Norway			
Design & Implementation:					
		QURIE ARCHITECTURE			
Project Name:					
Detention Centers Rehabilitation Project in the West Bank (Norwegian Grant)					
Title:					
Al-Qalaa Detention Center					
Drawings Title:					
Foundation Plan					
Project No.:	Phase:	Discipline:	Date:	Drawing No.:	
00000	01	A	8.2021	S02	
Drawn:	Checked:	Approved:	Size:	Scale:	Rev.:
			A3	1:100	

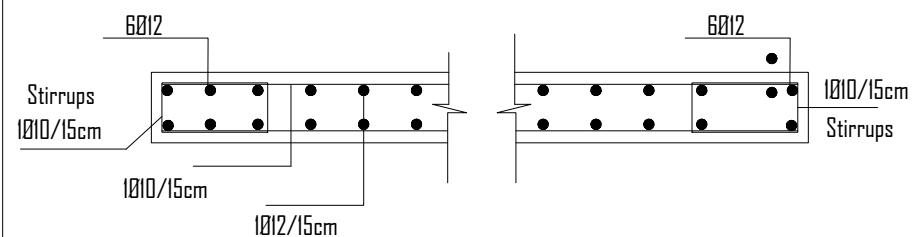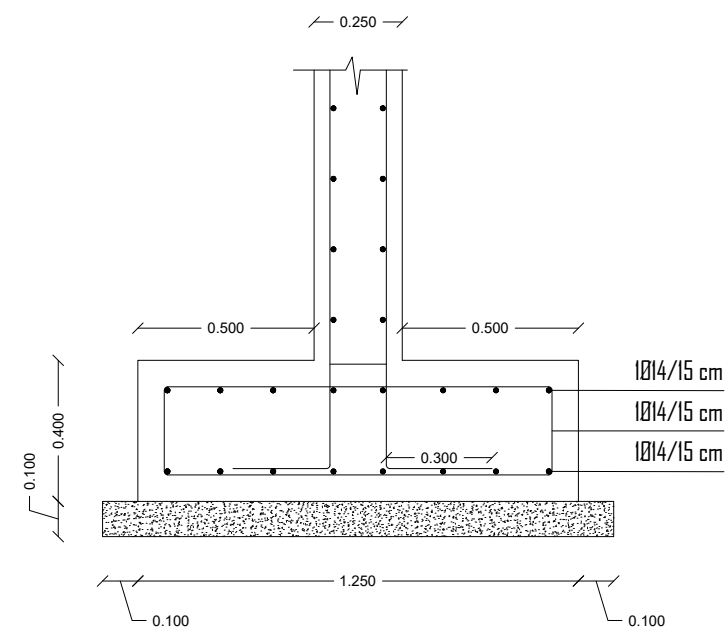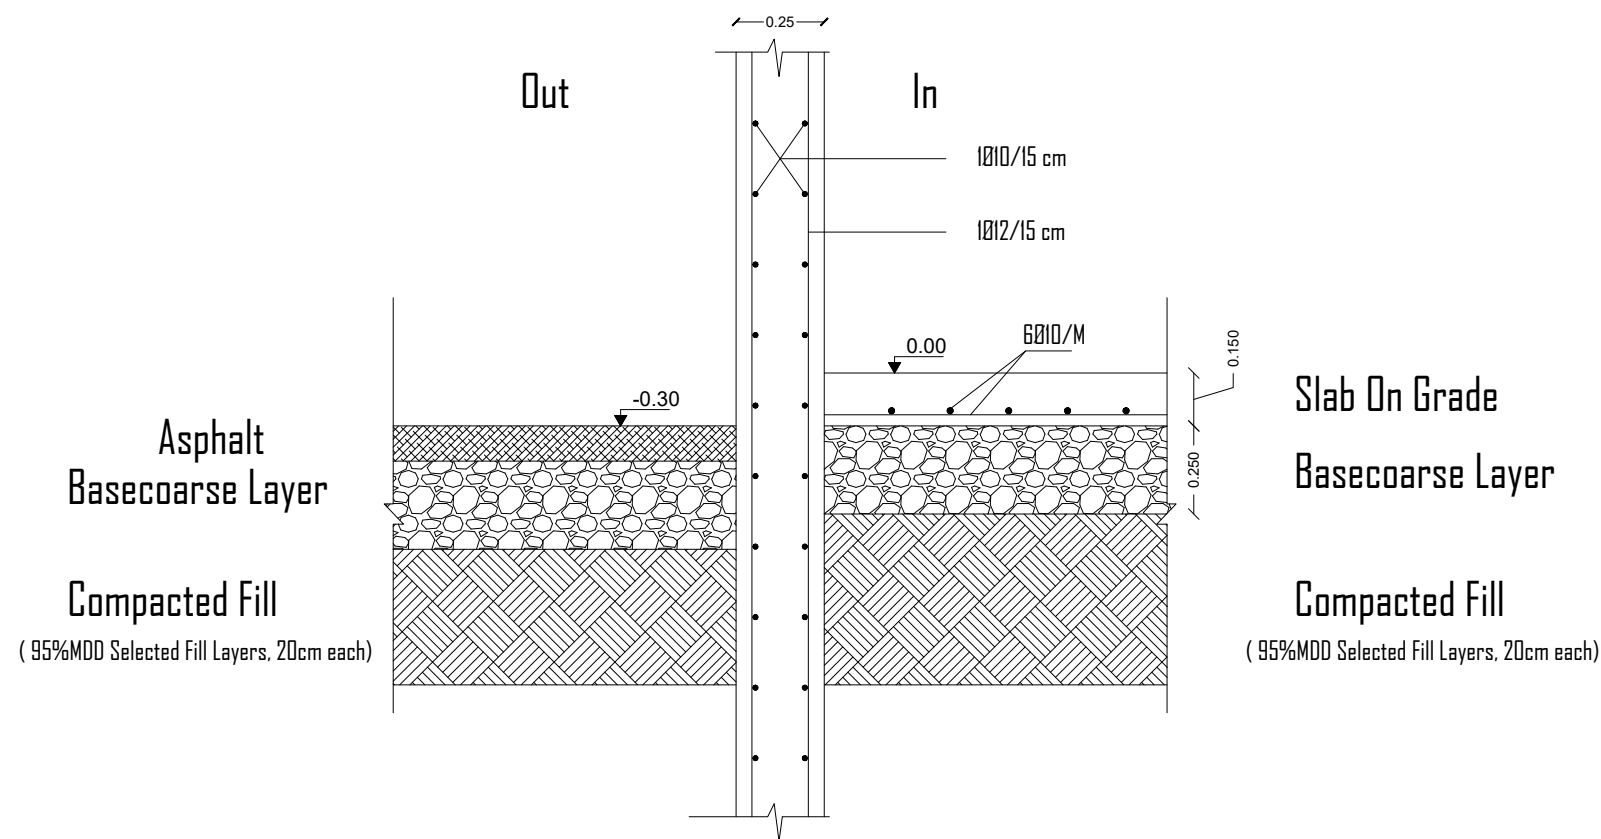

LEGEND	
1- EXISTING EXTERNAL WALL	
2- REINFORCED CONCRETE	
3- CONCRETE BLOCK WALL	
4- EXTERIOR PAVING	
NOTES	
<table border="1"><tr><td></td><td></td><td></td><td></td><td></td><td></td><td></td><td></td><td></td><td></td></tr><tr><td></td><td></td><td></td><td></td><td></td><td></td><td></td><td></td><td></td><td></td></tr><tr><td></td><td></td><td></td><td></td><td></td><td></td><td></td><td></td><td></td><td></td></tr><tr><td></td><td></td><td></td><td></td><td></td><td></td><td></td><td></td><td></td><td></td></tr><tr><td></td><td></td><td></td><td></td><td></td><td></td><td></td><td></td><td></td><td></td></tr><tr><td></td><td></td><td></td><td></td><td></td><td></td><td></td><td></td><td></td><td></td></tr><tr><td>Rev.:</td><td>Date:</td><td colspan="6">Description:</td><td colspan="2">Approved:</td></tr><tr><td colspan="10">All information in this document is the property of PALESTINIAN CIVIL POLICE and cannot be copied anywhere but in this project without prior written consent of PALESTINIAN CIVIL POLICE.</td></tr><tr><td colspan="10">Partners:</td></tr><tr><td colspan="5">The Independent Commission For Human Rights (ICHR)</td><td colspan="5">PALESTINIAN CIVIL POLICE</td></tr><tr><td colspan="5"></td><td colspan="5"></td></tr><tr><td colspan="10">Funded by:</td></tr><tr><td colspan="5"></td><td colspan="5">Kingdom of Norway</td></tr><tr><td colspan="10">Design & Implementation:</td></tr><tr><td colspan="5"></td><td colspan="5">Q U R I E ARCHITECTURE</td></tr><tr><td colspan="10">Project Name:</td></tr><tr><td colspan="10">Detention Centers Rehabilitation Project in the West Bank (Norwegian Grant)</td></tr><tr><td colspan="10">Title:</td></tr><tr><td colspan="10">Al-Qalaa Detention Center</td></tr><tr><td colspan="10">Drawings Title:</td></tr><tr><td colspan="10">Foundation Detail Typical Column Detail</td></tr><tr><td colspan="2">Project No.:</td><td>Phase:</td><td>Discipline:</td><td colspan="2">Date:</td><td colspan="4">Drawing No.:</td></tr><tr><td colspan="2">000000</td><td>01</td><td>A</td><td colspan="2">8.2021</td><td colspan="4">S03</td></tr><tr><td>Drawn:</td><td>Checked:</td><td>Approved:</td><td>Size:</td><td colspan="2">Scale:</td><td colspan="4">Rev.:</td></tr><tr><td></td><td></td><td></td><td>A3</td><td colspan="2">1:20</td><td></td><td></td><td></td><td></td></tr></table>																																																																						Rev.:	Date:	Description:						Approved:		All information in this document is the property of PALESTINIAN CIVIL POLICE and cannot be copied anywhere but in this project without prior written consent of PALESTINIAN CIVIL POLICE.										Partners:										The Independent Commission For Human Rights (ICHR)					PALESTINIAN CIVIL POLICE															Funded by:															Kingdom of Norway					Design & Implementation:															Q U R I E ARCHITECTURE					Project Name:										Detention Centers Rehabilitation Project in the West Bank (Norwegian Grant)										Title:										Al-Qalaa Detention Center										Drawings Title:										Foundation Detail Typical Column Detail										Project No.:		Phase:	Discipline:	Date:		Drawing No.:				000000		01	A	8.2021		S03				Drawn:	Checked:	Approved:	Size:	Scale:		Rev.:							A3	1:20					
Rev.:	Date:	Description:						Approved:	
All information in this document is the property of PALESTINIAN CIVIL POLICE and cannot be copied anywhere but in this project without prior written consent of PALESTINIAN CIVIL POLICE.	
Partners:	
The Independent Commission For Human Rights (ICHR)					PALESTINIAN CIVIL POLICE	
	
Funded by:	
					Kingdom of Norway	
Design & Implementation:	
					Q U R I E ARCHITECTURE	
Project Name:	
Detention Centers Rehabilitation Project in the West Bank (Norwegian Grant)	
Title:	
Al-Qalaa Detention Center	
Drawings Title:	
Foundation Detail Typical Column Detail	
Project No.:		Phase:	Discipline:	Date:		Drawing No.:	
000000		01	A	8.2021		S03	
Drawn:	Checked:	Approved:	Size:	Scale:		Rev.:	
			A3	1:20	



LEGEND

1- EXISTING EXTERNAL WALL	
2- REINFORCED CONCRETE	
3- CONCRETE BLOCK WALL	
4- EXTERIOR PAVING	

NOTES


Rev.:	Date:	Description:	Approved:
-------	-------	--------------	-----------

All information in this document is the property of PALESTINIAN CIVIL POLICE and cannot be copied anywhere but in this project without prior written consent of PALESTINIAN CIVIL POLICE.

Partners:

<p>The Independent Commission For Human Rights (ICHR)</p> 	<p>PALESTINIAN CIVIL POLICE</p> 
---	---

Funded by:



Kingdom of Norway

Design & Implementation:

Project Name:

Detention Centers Rehabilitation
Project in the West Bank
(Norwegian Grant)



Title:

Al-Qalaa Detention Center


Drawings Title:

Foundation Detail
Wall Detail (1)

Project No.:		Phase:	Discipline:	Date:	Drawing No.:	
000000		01	A	8.2021	S04	
Drawn:	Checked:	Approved:	Size:	Scale:	Rev.:	
			A3	1:20		

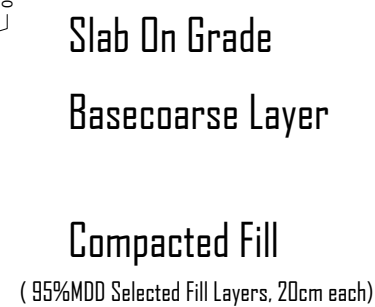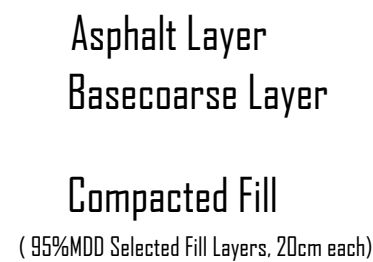


Typical Wall Detail (Not to Scale)

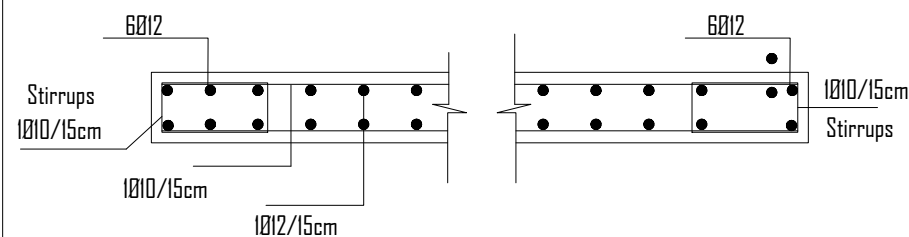

Project No.:		Phase:	Discipline:	Date:	Drawing No.:		
000000		01	A	8.2021	S05		
Drawn:	Checked:	Approved:	Size:	Scale:	Rev.:		
			A3	1:20			



Existing Building

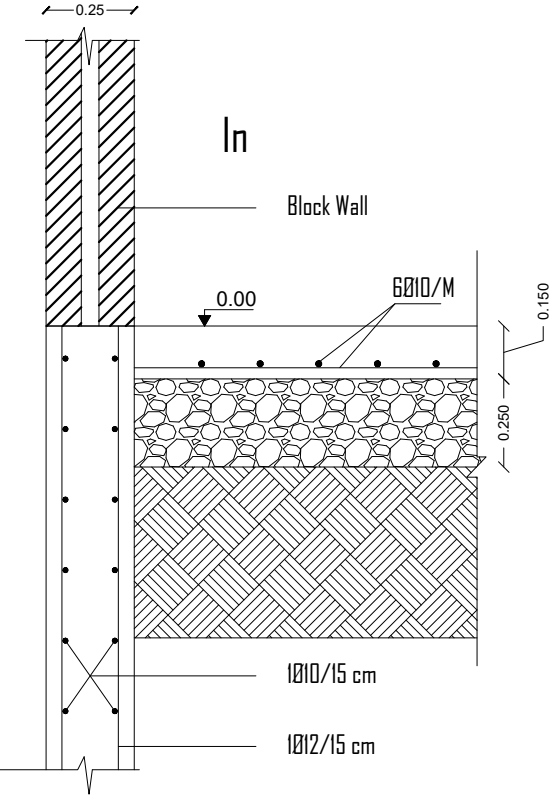

Slab On Grade
Basecourse Layer

Compacted Fill
(95%MDD Selected Fill Layers, 20cm each)

Typical Wall Detail (Not to Scale)

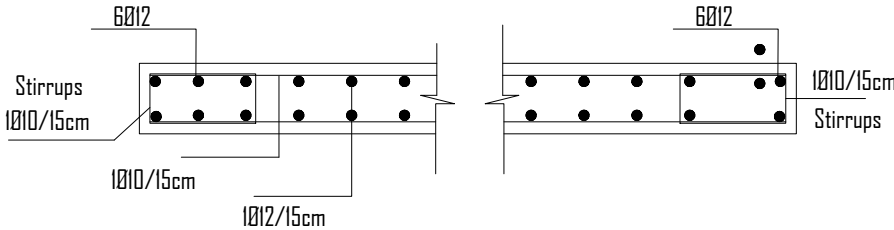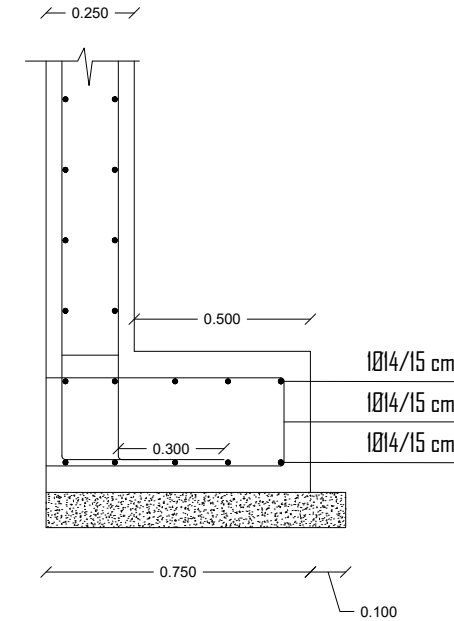

LEGEND

1- EXISTING EXTERNAL WALL	
2- REINFORCED CONCRETE	
3- CONCRETE BLOCK WALL	
4- EXTERIOR PAVING	

NOTES

Rev.:	Date:	Description:	Approved:
-------	-------	--------------	-----------

All information in this document is the property of PALESTINIAN CIVIL POLICE and cannot be copied anywhere but in this project without prior written consent of PALESTINIAN CIVIL POLICE.

Partners:

The Independent Commission For Human Rights (ICHR)	PALESTINIAN CIVIL POLICE

Funded by:

	Kingdom of Norway
--	-------------------

Design & Implementation:

	QURIE ARCHITECTURE
--	-----------------------

Project Name:

Detention Centers Rehabilitation
Project in the West Bank
(Norwegian Grant)

Title:




Al-Qalaa Detention Center

Drawings Title:

Foundation Detail
Wall Detail (3)

Project No.:	Phase:	Discipline:	Date:	Drawing No.:
000000	01	A	8.2021	S06
Drawn:	Checked:	Approved:	Size:	Scale:
			A3	1:20

Typical Wall Detail (Not to Scale)

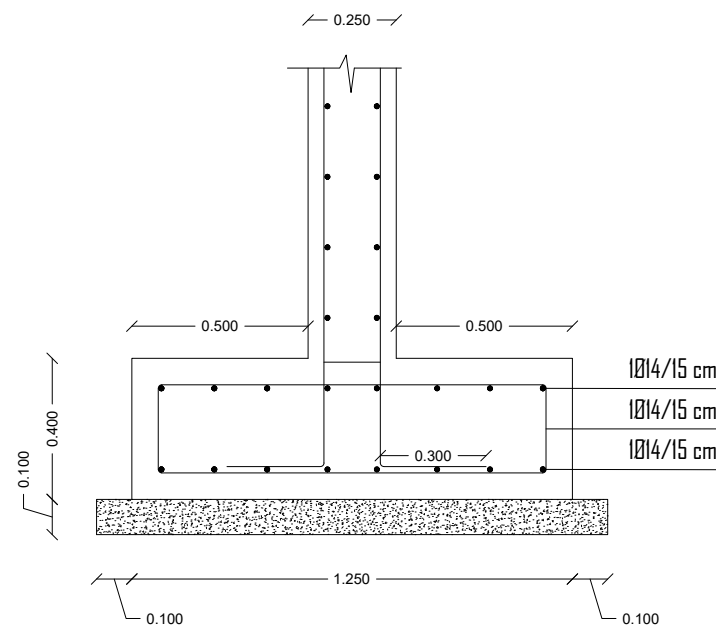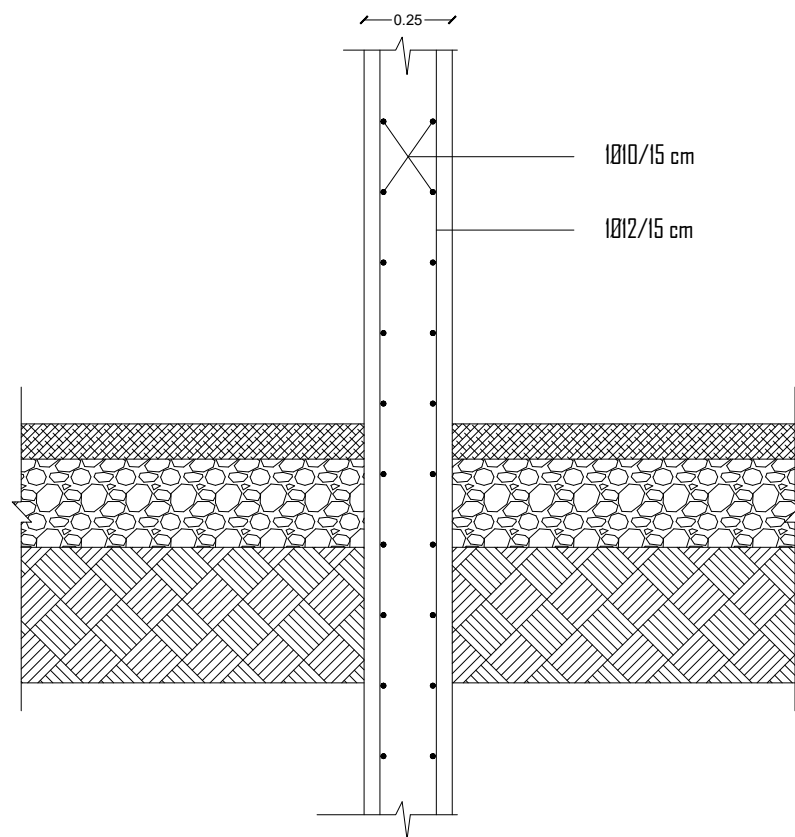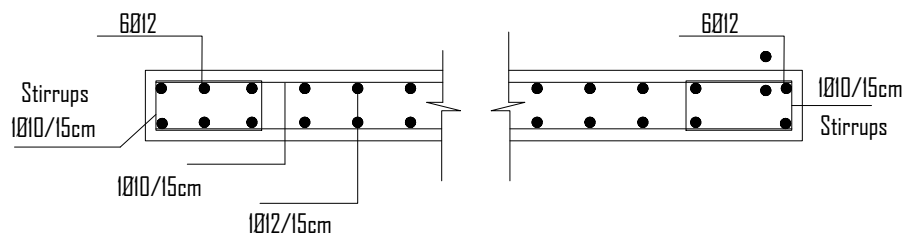

LEGEND

- 1- EXISTING EXTERNAL WALL
- 2- REINFORCED CONCRETE
- 3- CONCRETE BLOCK WALL
- 4- EXTERIOR PAVING

NOTES

Rev.: Date: Description: Approved:

All information in this document is the property of PALESTINIAN CIVIL POLICE and cannot be copied anywhere but in this project without prior written consent of PALESTINIAN CIVIL POLICE.

Partners:

The Independent Commission For Human Rights (ICHR)

PALESTINIAN CIVIL POLICE



Funded by:



Kingdom of Norway

Design & Implementation:



QURIE
ARCHITECTURE

Project Name:

Detention Centers Rehabilitation Project in the West Bank (Norwegian Grant)


Title:

Al-Qalaa Detention Center


Drawings Title:

Foundation Detail
Wall Detail (4)


Project No.:	Phase:	Discipline:	Date:	Drawing No.:
000000	01	A	8.2021	S07
Drawn:	Checked:	Approved:	Size:	Scale:
			A3	1:20

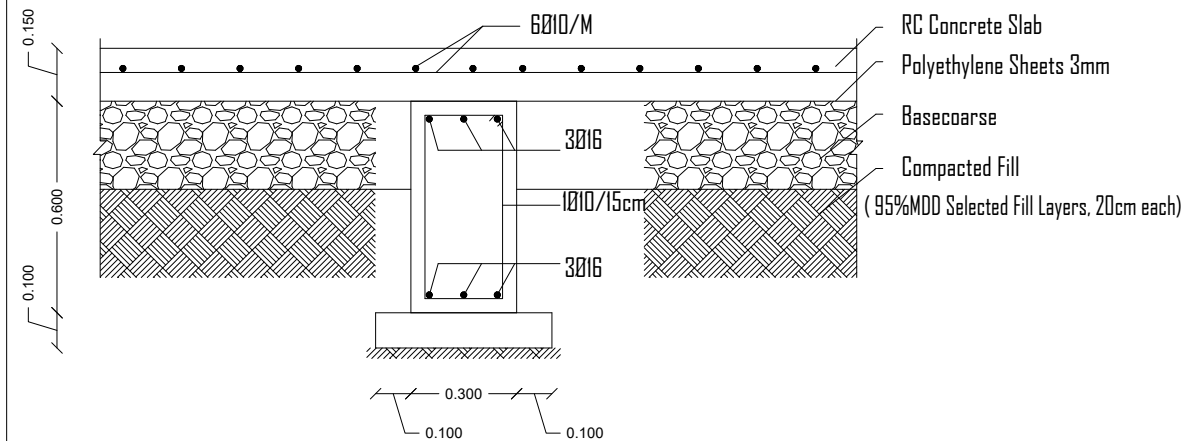

Typical Slab on Grade Detail

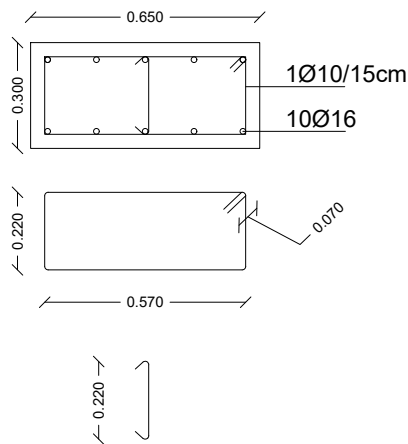

Column Section

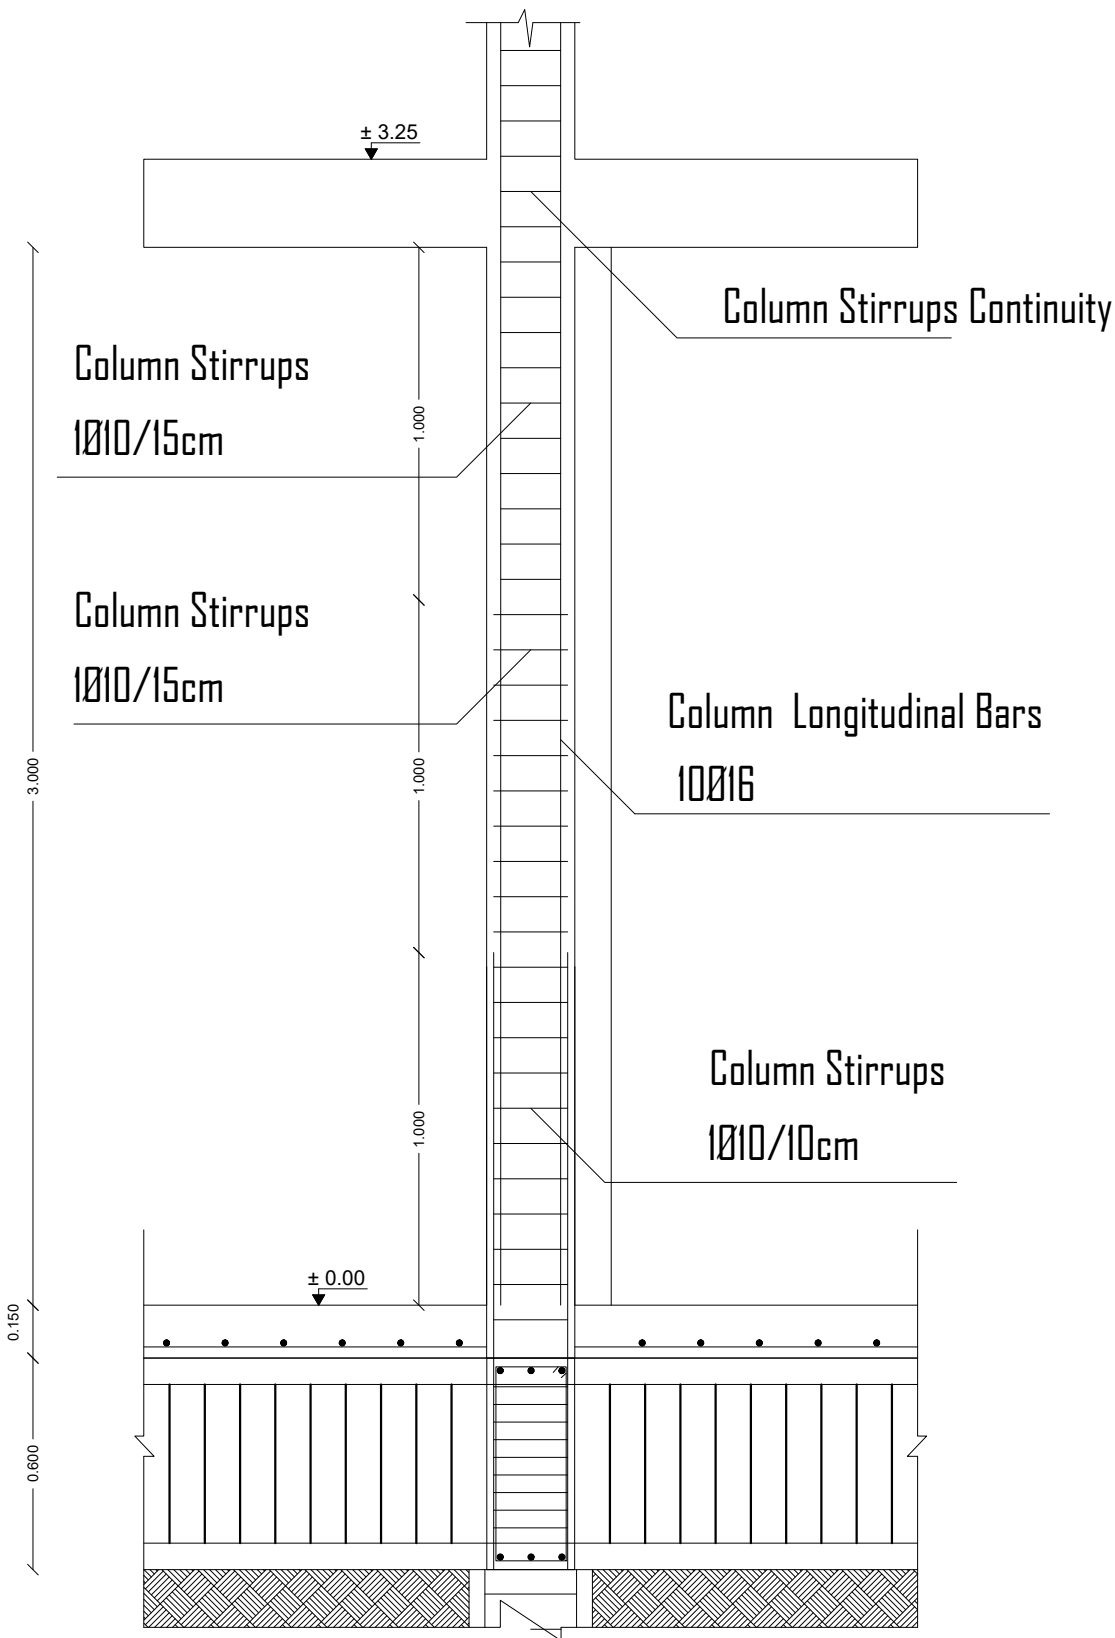

Column Section
Not to Scale

LEGEND

1- EXISTING EXTERNAL WALL


2- REINFORCED CONCRETE

3- CONCRETE BLOCK WALL


4- EXTERIOR PAVING

NOTES


Rev.:	Date:	Description:	Approved:
All information in this document is the property of PALESTINIAN CIVIL POLICE and cannot be copied anywhere but in this project without prior written consent of PALESTINIAN CIVIL POLICE.			
Partners:			
The Independent Commission For Human Rights (ICHR)		PALESTINIAN CIVIL POLICE	
Funded by:			
		Kingdom of Norway	
Design & Implementation:			
		QURIE ARCHITECTURE	
Project Name:			
Detention Centers Rehabilitation Project in the West Bank (Norwegian Grant)			
Title:			
Al-Qalaa Detention Center			
Drawings Title:			
Tie Beam & Column Detail			
Project No.:	Phase:	Discipline:	Date:
000000	01	A	8.2021
Drawn:	Checked:	Approved:	Size:
			A3
			1:20

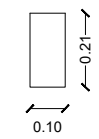

Stirrups

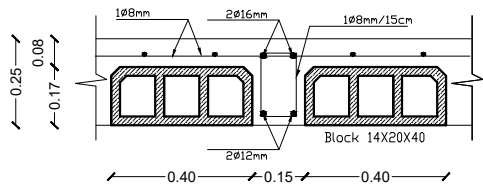

TYPICAL SECTION IN RIB SLAB

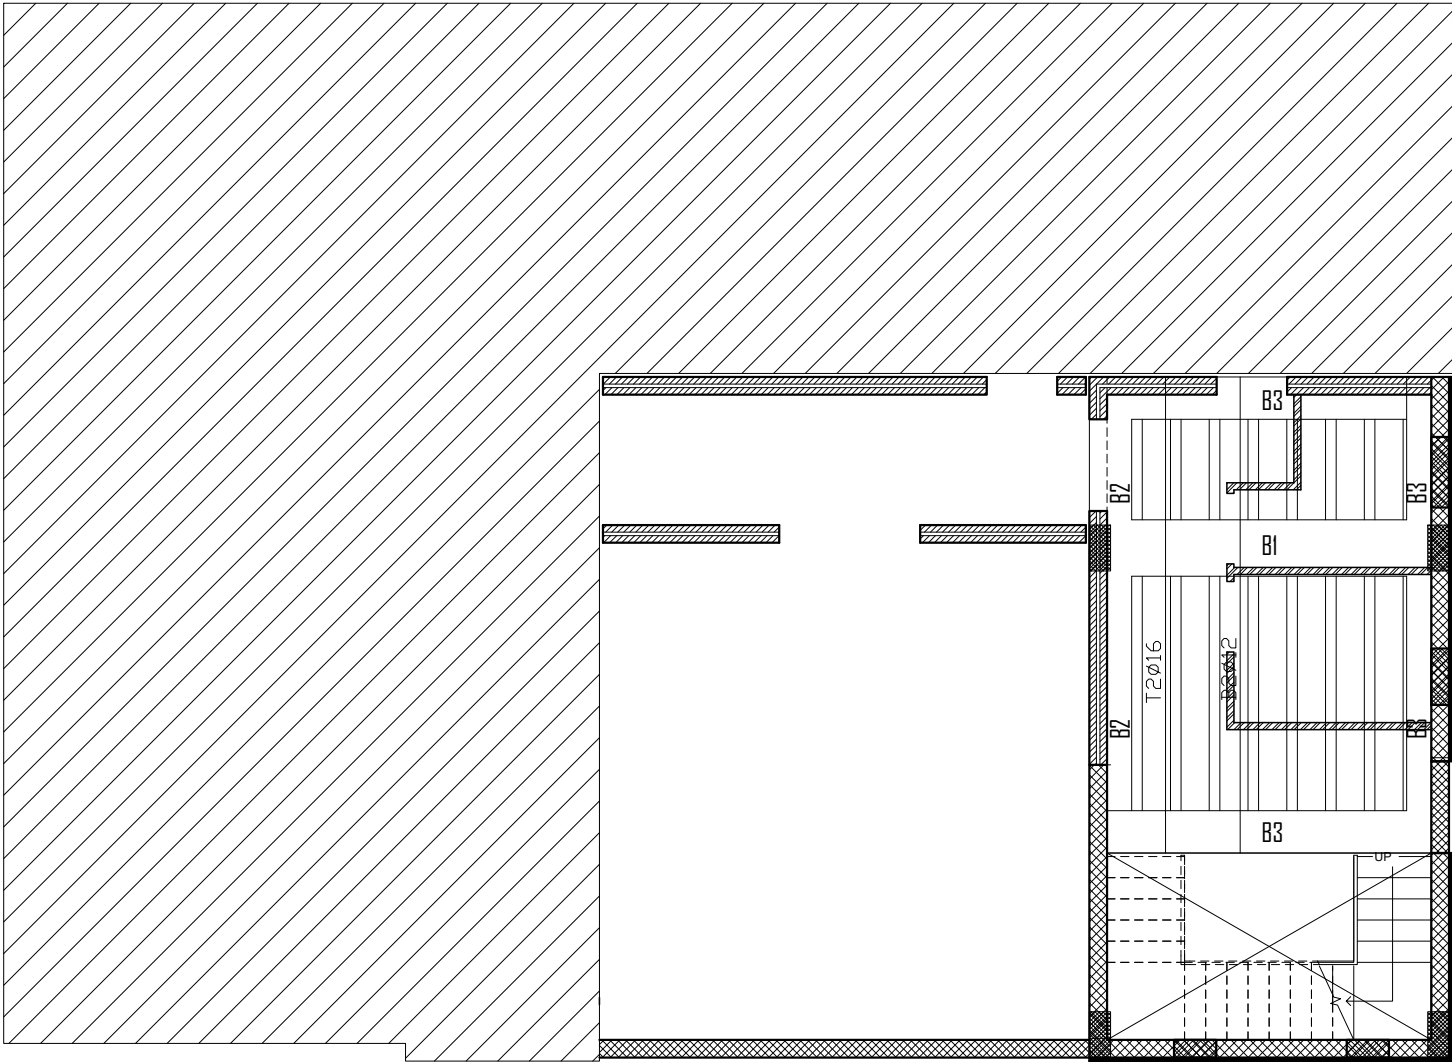

No.	Width	Depth	Top Bars	Bottom Bars	Stirrups
B1	80	25	8Ø14	8Ø16	2Ø10/10cm
B2	As Detail				2Ø10/10cm
B3	60	25	6Ø12	6Ø12	1Ø10/10cm

LEGEND

1- EXISTING EXTERNAL WALL	
2- REINFORCED CONCRETE	
3- CONCRETE BLOCK WALL	
4- EXTERIOR PAVING	

NOTES

Rev.:	Date:	Description:	Approved:
-------	-------	--------------	-----------

All information in this document is the property of PALESTINIAN CIVIL POLICE and cannot be copied anywhere but in this project without prior written consent of PALESTINIAN CIVIL POLICE.

Partners:

The Independent Commission For Human Rights (ICHR)	PALESTINIAN CIVIL POLICE

Funded by:

	Kingdom of Norway
--	-------------------

Design & Implementation:

	QURIE ARCHITECTURE
--	-----------------------

Project Name:


Detention Centers Rehabilitation
Project in the West Bank
(Norwegian Grant)

Title:



Al-Qalaa Detention Center

Drawings Title:



Project No.:	Phase:	Discipline:	Date:	Drawing No.:
00000	01	A	8.2021	S9
Drawn:	Checked:	Approved:	Size:	Scale:
			A3	1:100

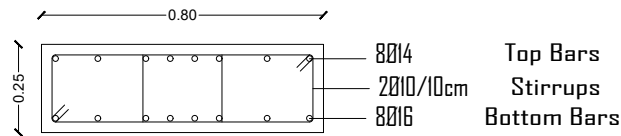


B1

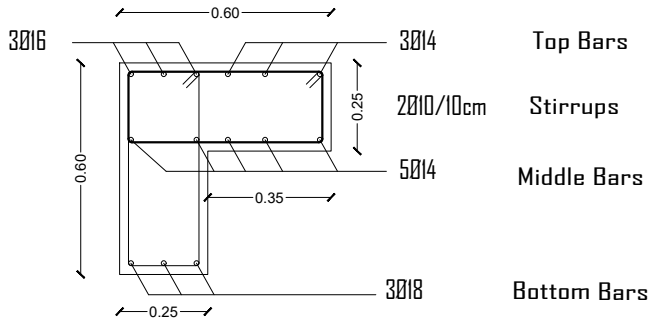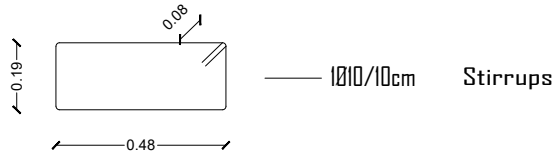

B2

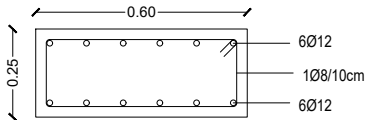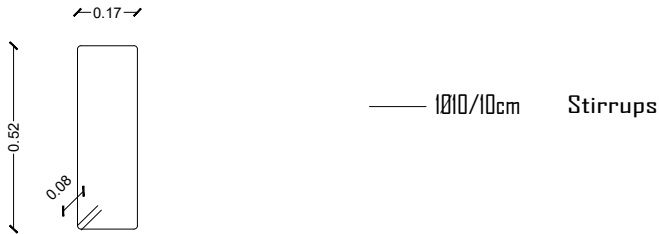

B3

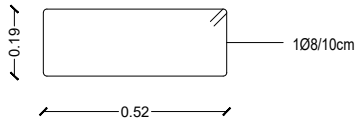

LEGEND

1- EXISTING EXTERNAL WALL	
2- REINFORCED CONCRETE	
3- CONCRETE BLOCK WALL	
4- EXTERIOR PAVING	

NOTES

Rev.:	Date:	Description:	Approved:
-------	-------	--------------	-----------

All information in this document is the property of PALESTINIAN CIVIL POLICE and cannot be copied anywhere but in this project without prior written consent of PALESTINIAN CIVIL POLICE.

Partners:	
The Independent Commission For Human Rights (ICHR)	PALESTINIAN CIVIL POLICE

Funded by:	
	Kingdom of Norway


Design & Implementation:	
	QURIE ARCHITECTURE

Project Name:	
Detention Centers Rehabilitation Project in the West Bank (Norwegian Grant)	


Title:	
Al-Qalaa Detention Center	

Drawings Title:	

Project No.:	Phase:	Discipline:	Date:	Drawing No.:
000000	01	A	8.2021	S10
Drawn:	Checked:	Approved:	Size:	Scale:
			A3	1:100

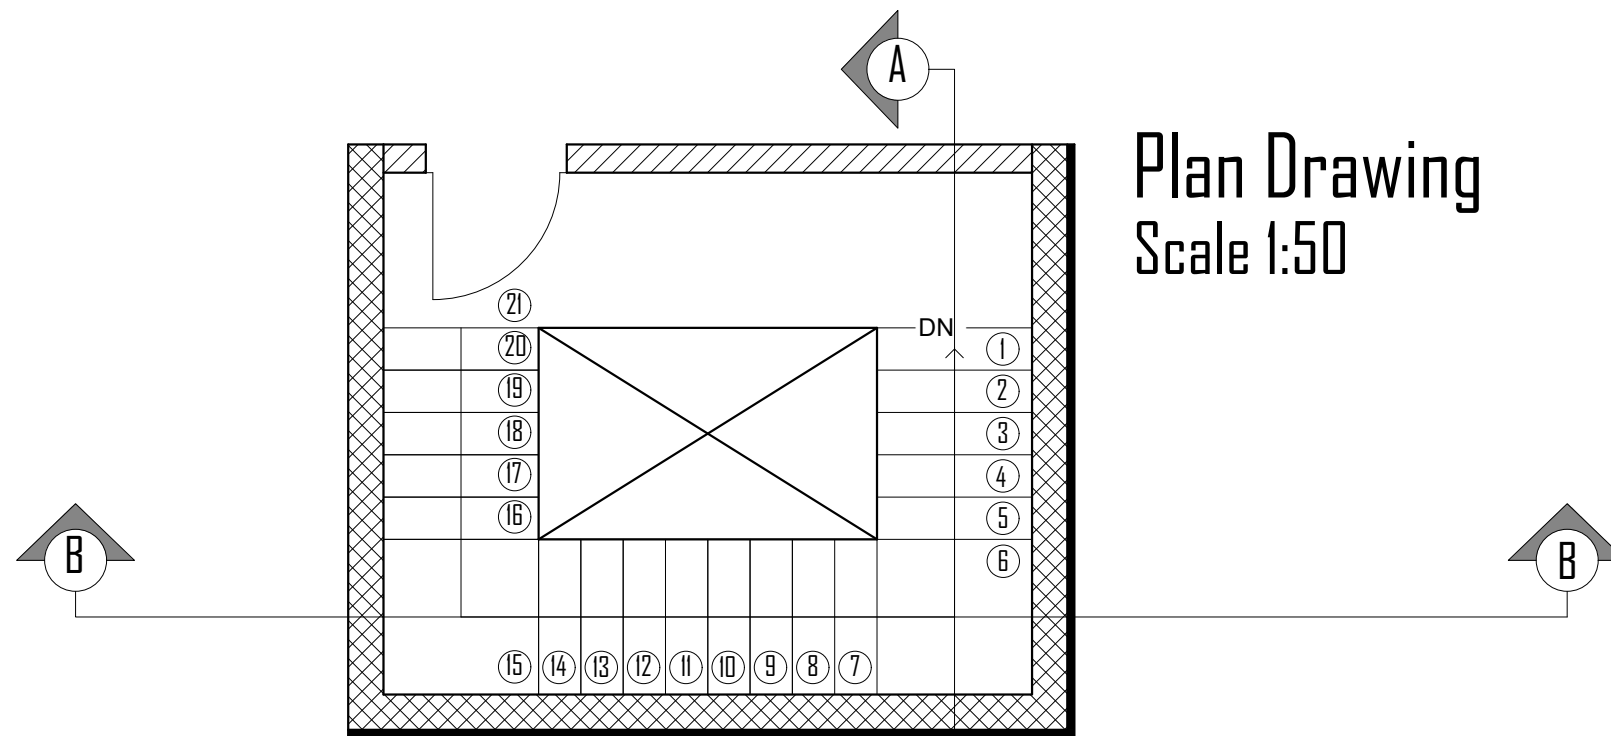

Plan Drawing
Scale 1:50

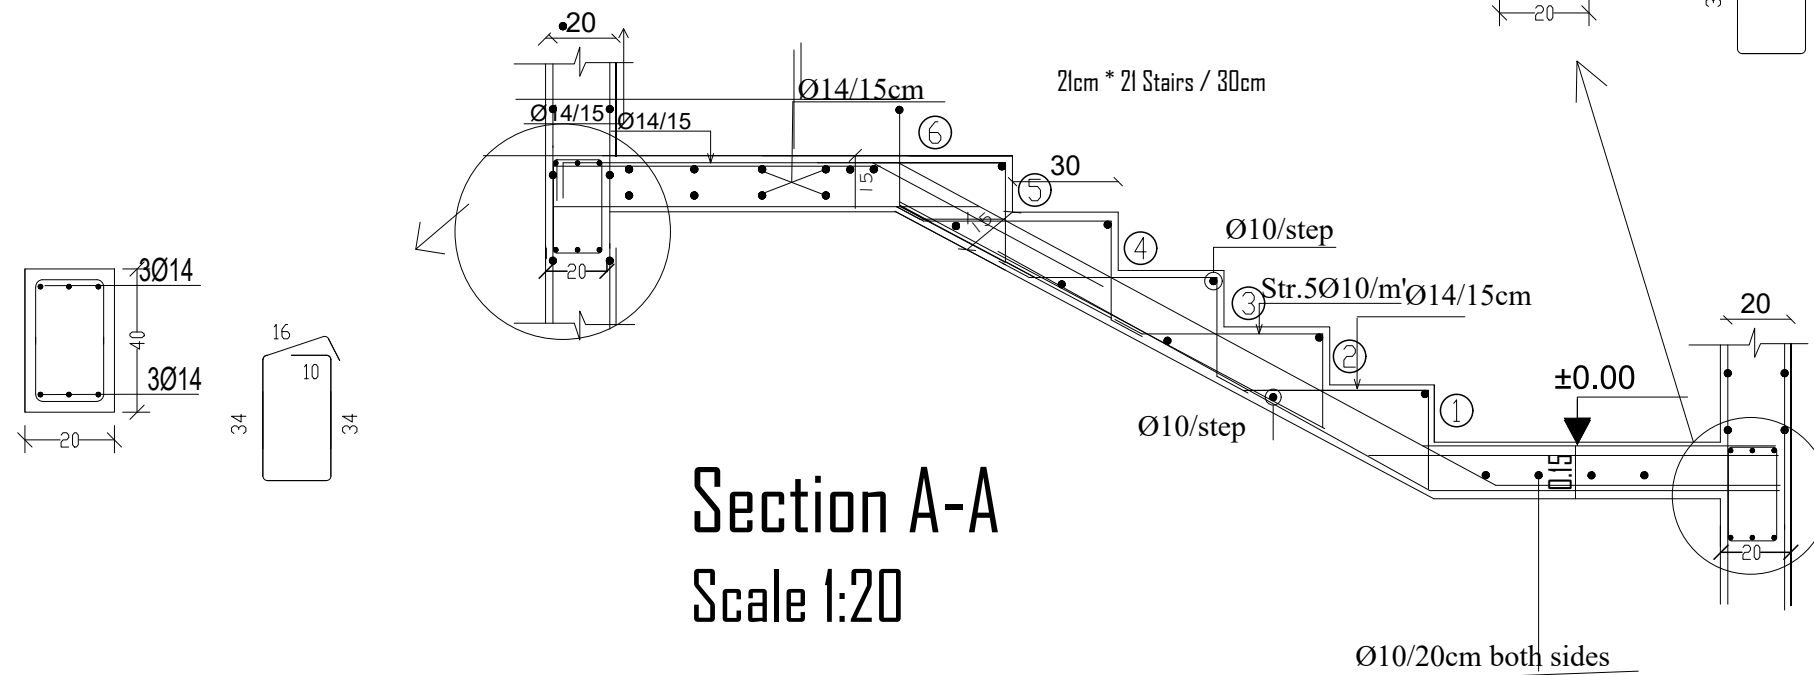

Section A-A
Scale 1:20

LEGEND

1- EXISTING EXTERNAL WALL	
2- REINFORCED CONCRETE	
3- CONCRETE BLOCK WALL	
4- EXTERIOR PAVING	

NOTES


Rev.:	Date:	Description:	Approved:
-------	-------	--------------	-----------

All information in this document is the property of PALESTINIAN CIVIL POLICE and cannot be copied anywhere but in this project without prior written consent of PALESTINIAN CIVIL POLICE.

Partners:

The Independent Commission
For Human Rights (ICHR)

PALESTINIAN CIVIL POLICE

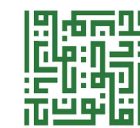

Funded by:



Kingdom of Norway

Design & Implementation:



QURIE
ARCHITECTURE

Project Name:

Detention Centers Rehabilitation
Project in the West Bank
(Norwegian Grant)


Title:

Al-Qalaa Detention Center

Drawings Title:

Northern Elevation

Project No.:	Phase:	Discipline:	Date:	Drawing No.:
000000	01	A	11.2021	S11
Drawn:	Checked:	Approved:	Size:	Scale:
			A3	Var

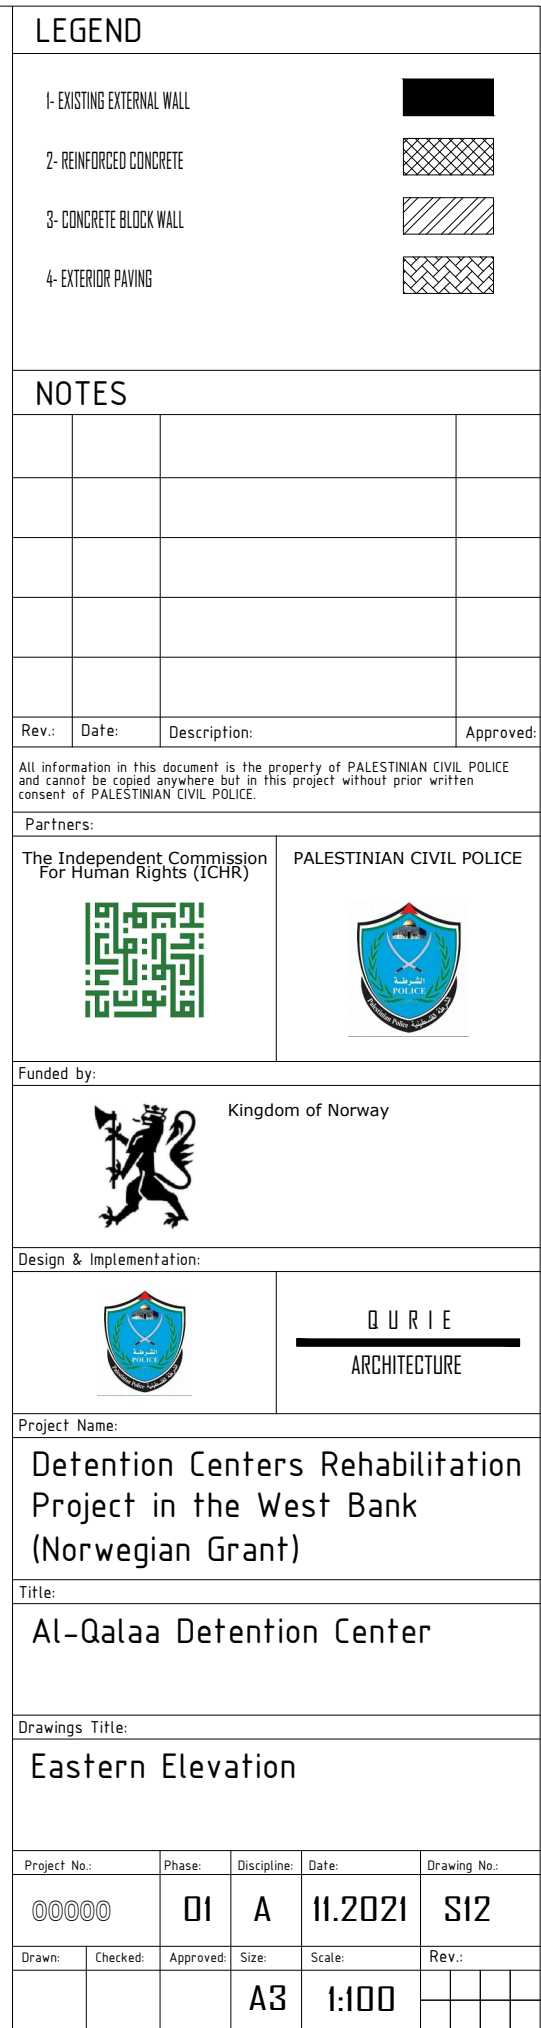

POLICE DETENTION CENTERS REHABILITATION PROJECT

CENTER NO (2):

YATTA DETENTION CENTER

LIST OF DRAWINGS

ARCHITECTURAL DRAWINGS

NO.	DRAWING TITLE
A00	List Of Drawings
A01	Existing Plan
A02	Proposed Plan

LEGEND

1- EXISTING EXTERNAL WALL

2- REINFORCED CONCRETE

3- CONCRETE BLOCK WALL

4- EXTERIOR PAVING

NOTES

Rev.:

Date:

Description:

Approved:

All information in this document is the property of PALESTINIAN CIVIL POLICE and cannot be copied anywhere but in this project without prior written consent of PALESTINIAN CIVIL POLICE.

Partners:

The Independent Commission For Human Rights (ICHR)

PALESTINIAN CIVIL POLICE

Funded by:

Kingdom of Norway

Design & Implementation:

QURIE ARCHITECTURE

Project Name:

Detention Centers Rehabilitation Project in the West Bank (Norwegian Grant)

Title:

Al-Qalaa Detention Center

Drawings Title:

List Of Drawings

Project No.:

Phase:

Discipline:

Date:

Drawing No.:

000000

01

A

8.2021

A00

Drawn:

Checked:


Approved:

Size:

Scale:

Rev.:

A3

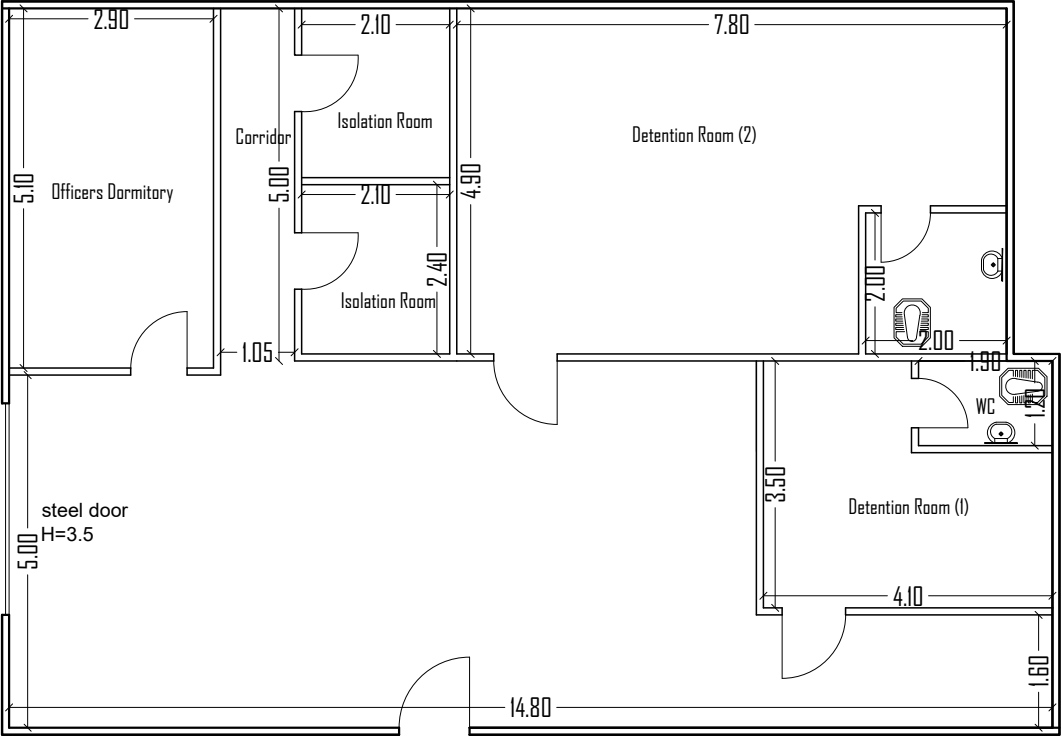

Story Clear Height = 3.50m

LEGEND





1- EXISTING EXTERNAL WALL


2- REINFORCED CONCRETE

3- CONCRETE BLOCK WALL

4- EXTERIOR PAVING

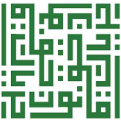NOTES

Rev.:	Date:	Description:	Approved:		
All information in this document is the property of PALESTINIAN CIVIL POLICE and cannot be copied anywhere but in this project without prior written consent of PALESTINIAN CIVIL POLICE.					
Partners:					
The Independent Commission For Human Rights (ICHR)		PALESTINIAN CIVIL POLICE			
					
Funded by:					
		Kingdom of Norway			
Design & Implementation:					
		QURIE ARCHITECTURE			
Project Name:					
Detention Centers Rehabilitation Project in the West Bank (Norwegian Grant)					
Title:					
Al-Qalaa Detention Center					
Drawings Title:					
Existing Plan					
Project No.:	Phase:	Discipline:	Date:	Drawing No.:	
000000	01	A	8.2021	A01	
Drawn:	Checked:	Approved:	Size:	Scale:	Rev.:
			A3	1:100	

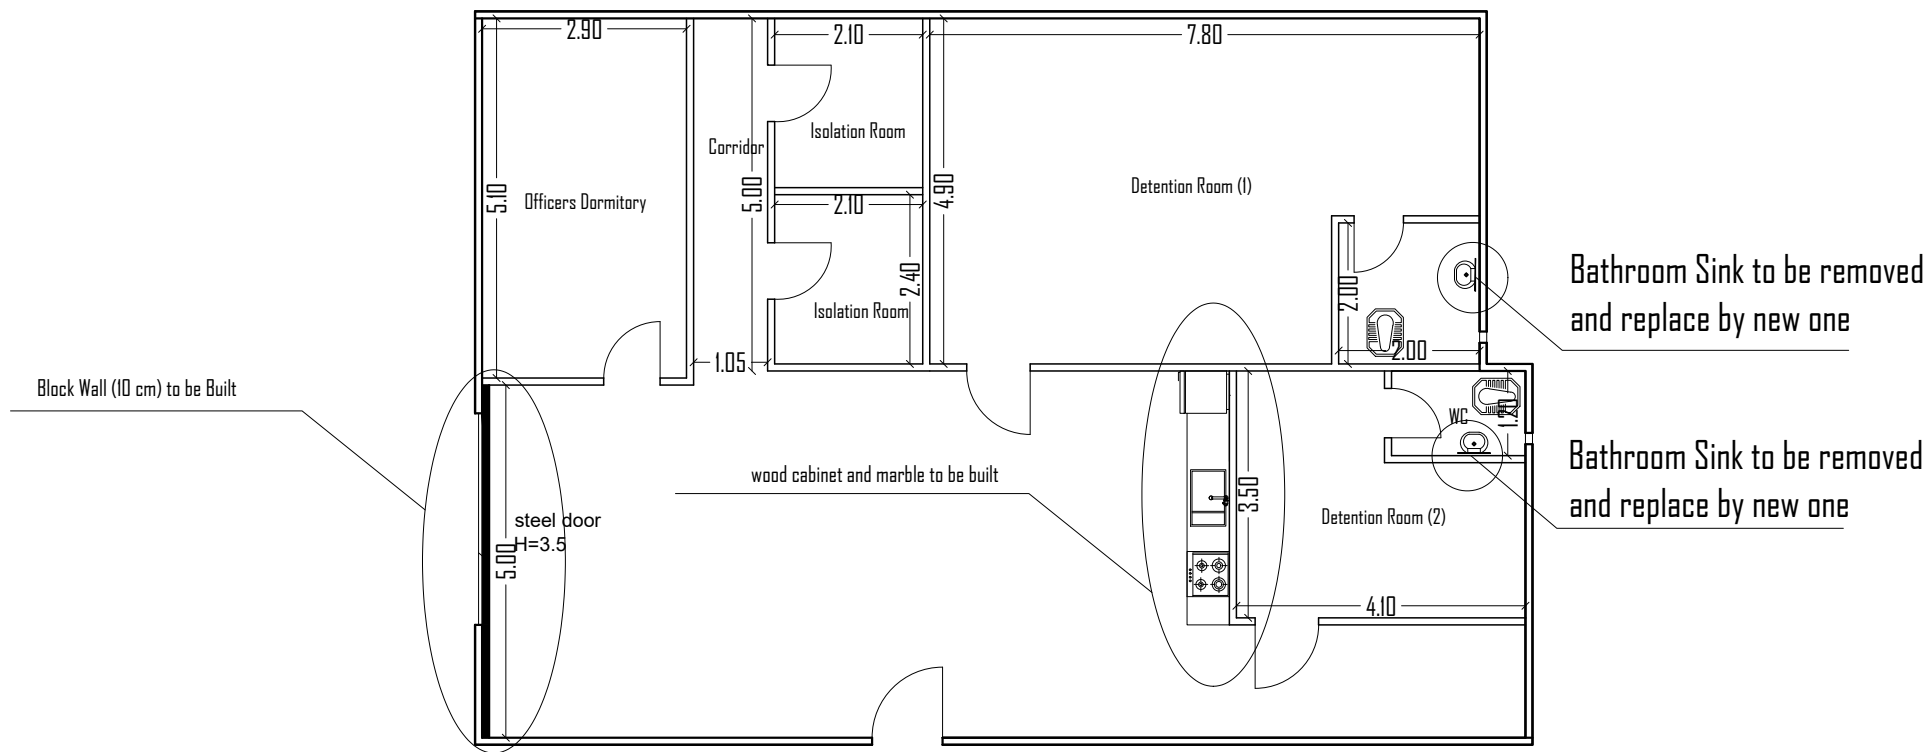

LEGEND

1- EXISTING EXTERNAL WALL	
2- REINFORCED CONCRETE	
3- CONCRETE BLOCK WALL	
4- EXTERIOR PAVING	

NOTES

		Height = 3.50m	

Rev.:	Date:	Description:	Approved:
-------	-------	--------------	-----------

All information in this document is the property of PALESTINIAN CIVIL POLICE and cannot be copied anywhere but in this project without prior written consent of PALESTINIAN CIVIL POLICE.

Partners:	
The Independent Commission For Human Rights (ICHR)	PALESTINIAN CIVIL POLICE

Funded by:	
	Kingdom of Norway

Design & Implementation:	
	QURIE ARCHITECTURE

Project Name:	Detention Centers Rehabilitation Project in the West Bank (Norwegian Grant)
---------------	---

Title:	Al-Qalaa Detention Center
--------	---------------------------

Drawings Title:	Proposed Plan
-----------------	---------------

Project No.:	Phase:	Discipline:	Date:	Drawing No.:
000000	01	A	8.2021	A02
Drawn:	Checked:	Approved:	Size:	Scale:
			A3	1:100

POLICE DETENTION CENTERS REHABILITATION PROJECT

CENTER NO (3):

HALHOUL DETENTION CENTER

LIST OF DRAWINGS

[illegible]

LEGEND


1- EXISTING EXTERNAL WALL	
2- REINFORCED CONCRETE	
3- CONCRETE BLOCK WALL	
4- EXTERIOR PAVING	

NOTES

All information in this document is the property of PALESTINIAN CIVIL POLICE and cannot be copied anywhere but in this project without prior written consent of PALESTINIAN CIVIL POLICE.

Partners

The Independent Commission For Human Rights (ICHR)

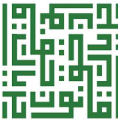

PALESTINIAN CIVIL POLICE



unded by



Kingdom of Norway

Design & Implementation:



Q U R I E

ARCHITECTURE

Project Name

Detention Centers Rehabilitation Project in the West Bank (Norwegian Grant)


itle

Al-Qalaa Detention Center

Drawings Title

List Of Drawings

Project No.:		Phase:	Discipline:	Date:	Drawing No.:		
000000		01	A	8.2021	A00		
Drawn:	Checked:	Approved:	Size:	Scale:	Rev.:		
			A3				

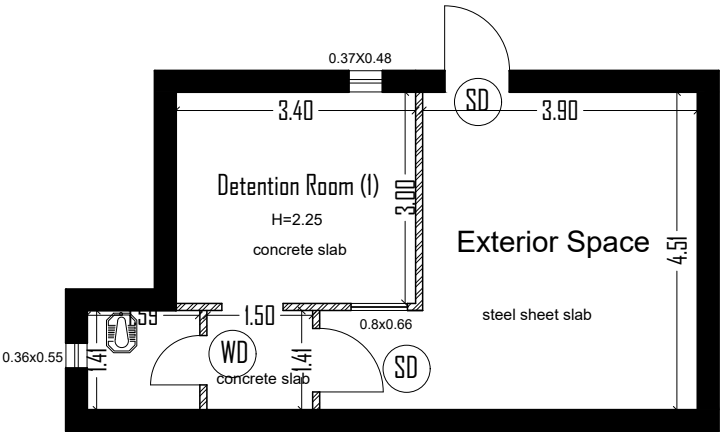

LEGEND

1- EXISTING EXTERNAL WALL	
2- REINFORCED CONCRETE	
3- CONCRETE BLOCK WALL	
4- EXTERIOR PAVING	

NOTES

Rev.:	Date:	Description:	Approved:
-------	-------	--------------	-----------

All information in this document is the property of PALESTINIAN CIVIL POLICE and cannot be copied anywhere but in this project without prior written consent of PALESTINIAN CIVIL POLICE.

Partners:

The Independent Commission For Human Rights (ICHR)

PALESTINIAN CIVIL POLICE

Funded by:

Kingdom of Norway

Design & Implementation:

QURIE

ARCHITECTURE

Project Name:

Detention Centers Rehabilitation Project in the West Bank (Norwegian Grant)


Title:

Al-Qalaa Detention Center

Drawings Title:

Existing Plan

Project No.:	Phase:	Discipline:	Date:	Drawing No.:
000000	01	A	8.2021	A01
Drawn:	Checked:	Approved:	Size:	Scale:
			A3	1:100

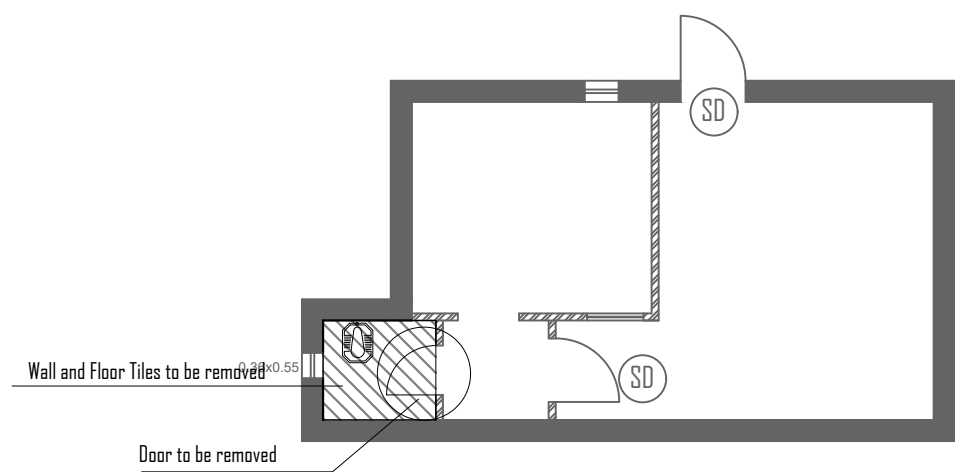

LEGEND

1- EXISTING EXTERNAL WALL

2- REINFORCED CONCRETE

3- CONCRETE BLOCK WALL

4- EXTERIOR PAVING

NOTES

Rev.:	Date:	Description:	Approved:

All information in this document is the property of PALESTINIAN CIVIL POLICE and cannot be copied anywhere but in this project without prior written consent of PALESTINIAN CIVIL POLICE.

Partners:

The Independent Commission For Human Rights (ICHR)

PALESTINIAN CIVIL POLICE

Funded by:

Kingdom of Norway

Design & Implementation:

QURIE ARCHITECTURE

Project Name:

Detention Centers Rehabilitation Project in the West Bank (Norwegian Grant)

Title:


Al-Qalaa Detention Center

Drawings Title:

Demolition Plan

Project No.:	Phase:	Discipline:	Date:	Drawing No.:
000000	01	A	8.2021	A02
Drawn:	Checked:	Approved:	Size:	Scale:
			A3	1:100

Rev.:				

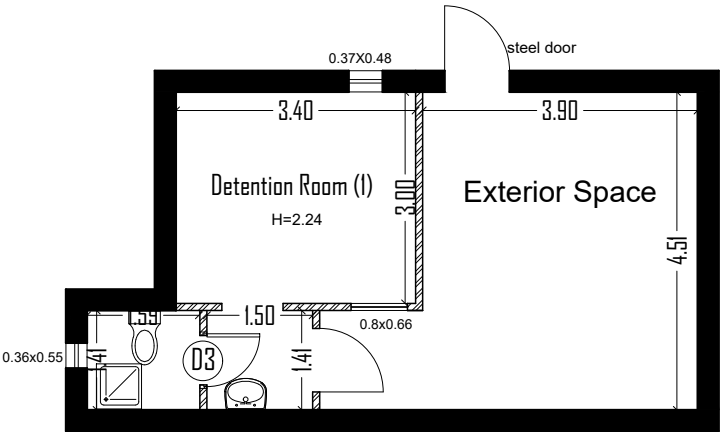

LEGEND

1- EXISTING EXTERNAL WALL	
2- REINFORCED CONCRETE	
3- CONCRETE BLOCK WALL	
4- EXTERIOR PAVING	

NOTES

		Height = 3.50m	

Rev.:	Date:	Description:	Approved:
-------	-------	--------------	-----------

All information in this document is the property of PALESTINIAN CIVIL POLICE and cannot be copied anywhere but in this project without prior written consent of PALESTINIAN CIVIL POLICE.

Partners:

The Independent Commission For Human Rights (ICHR)	PALESTINIAN CIVIL POLICE

Funded by:

	Kingdom of Norway
--	-------------------

Design & Implementation:

	QURIE ARCHITECTURE
--	-----------------------

Project Name:

Detention Centers Rehabilitation Project in the West Bank (Norwegian Grant)

Title:

Al-Qalaa Detention Center

Drawings Title:

Proposed Plan

Project No.:	Phase:	Discipline:	Date:	Drawing No.:
000000	01	A	8.2021	A03
Drawn:	Checked:	Approved:	Size:	Scale:
			A3	1:100

POLICE DETENTION CENTERS REHABILITATION PROJECT

CENTER NO (4):

Hebron Juvenile Detention Center

LIST OF DRAWINGS

ARCHITECTURAL DRAWINGS

NO.	DRAWING TITLE
A00	List Of Drawings
A01	Existing Plan
A02	Demolition Plan
A03	To Be Built Walls Plan
A04	Proposed Furniture Plan
A05	Proposed Dimensional Plan

LEGEND

1- EXISTING EXTERNAL WALL

2- REINFORCED CONCRETE

3- CONCRETE BLOCK WALL

4- EXTERIOR PAVING

NOTES

Rev.:

Date:

Description:

Approved:

All information in this document is the property of PALESTINIAN CIVIL POLICE and cannot be copied anywhere but in this project without prior written consent of PALESTINIAN CIVIL POLICE.

Partners:

The Independent Commission For Human Rights (ICHR)

PALESTINIAN CIVIL POLICE

Funded by:

Kingdom of Norway

Design & Implementation:

QURIE
ARCHITECTURE

Project Name:

Detention Centers Rehabilitation
Project in the West Bank
(Norwegian Grant)

Title:

Al-Qalaa Detention Center

Drawings Title:

List Of Drawings

Project No.:

Phase:

Discipline:

Date:

Drawing No.:

000000

01

A

8.2021

A00

Drawn:

Checked:


Approved:

Size:

Scale:

Rev.:

A3

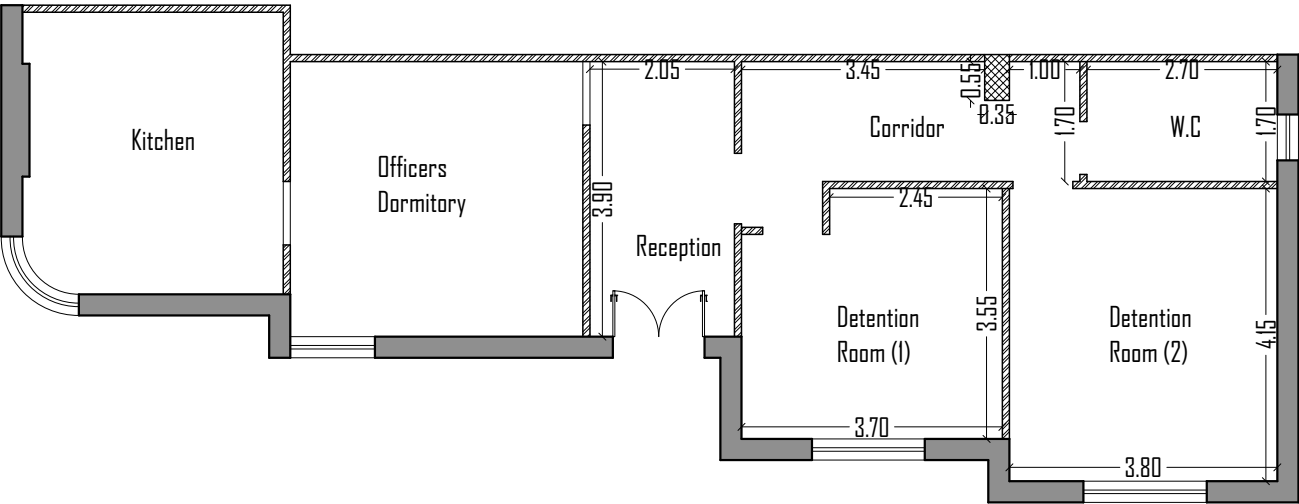

Story Clear Height = 2.60m

LEGEND

1- EXISTING EXTERNAL WALL	
2- REINFORCED CONCRETE	
3- CONCRETE BLOCK WALL	
4- EXTERIOR PAVING	

NOTES

Rev.:	Date:	Description:	Approved:
-------	-------	--------------	-----------

All information in this document is the property of PALESTINIAN CIVIL POLICE and cannot be copied anywhere but in this project without prior written consent of PALESTINIAN CIVIL POLICE.

Partners:

The Independent Commission For Human Rights (ICHR)	PALESTINIAN CIVIL POLICE

Funded by:



Design & Implementation:

	QURIE ARCHITECTURE
--	-----------------------

Project Name:

Detention Centers Rehabilitation Project in the West Bank (Norwegian Grant)


Title:

Al-Qalaa Detention Center

Drawings Title:

Existing Plan

Project No.:	Phase:	Discipline:	Date:	Drawing No.:
000000	01	A	8.2021	A01
Drawn:	Checked:	Approved:	Size:	Scale:
			A3	1:100

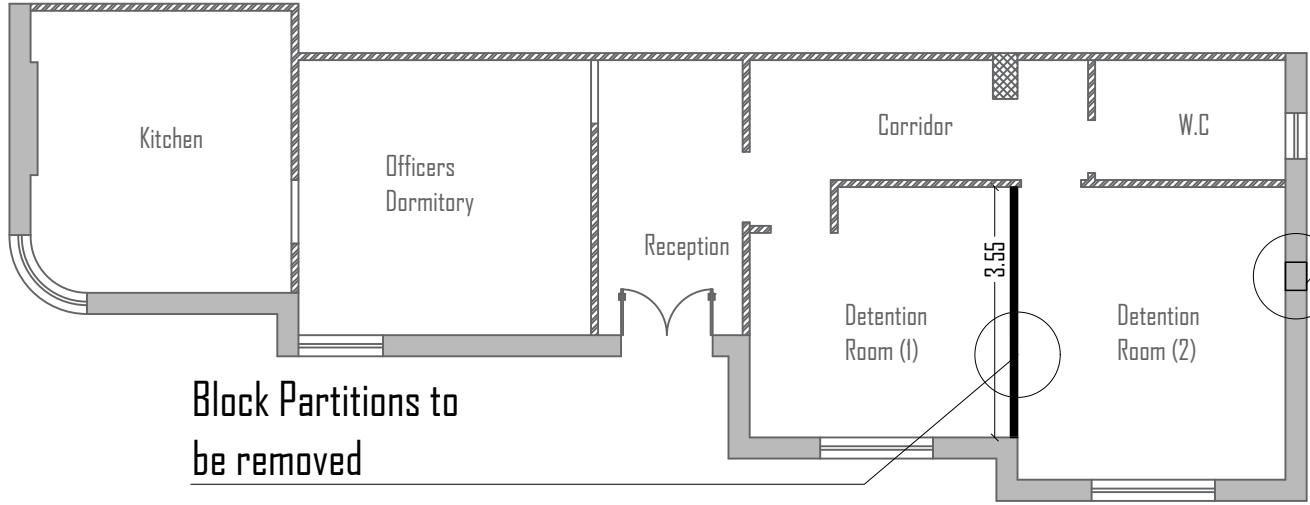

LEGEND

1- EXISTING EXTERNAL WALL	
2- REINFORCED CONCRETE	
3- CONCRETE BLOCK WALL	
4- EXTERIOR PAVING	

NOTES

Rev.:	Date:	Description:	Approved:
-------	-------	--------------	-----------

All information in this document is the property of PALESTINIAN CIVIL POLICE and cannot be copied anywhere but in this project without prior written consent of PALESTINIAN CIVIL POLICE.

Partners:

The Independent Commission
For Human Rights (ICHR)

PALESTINIAN CIVIL POLICE

Funded by:

Kingdom of Norway

Design & Implementation:

QURIE

ARCHITECTURE

Project Name:

Detention Centers Rehabilitation
Project in the West Bank
(Norwegian Grant)


Title:

Al-Qalaa Detention Center

Drawings Title:

Demolition Plan

Project No.:	Phase:	Discipline:	Date:	Drawing No.:
000000	01	A	8.2021	A02
Drawn:	Checked:	Approved:	Size:	Scale:
			A3	1:100

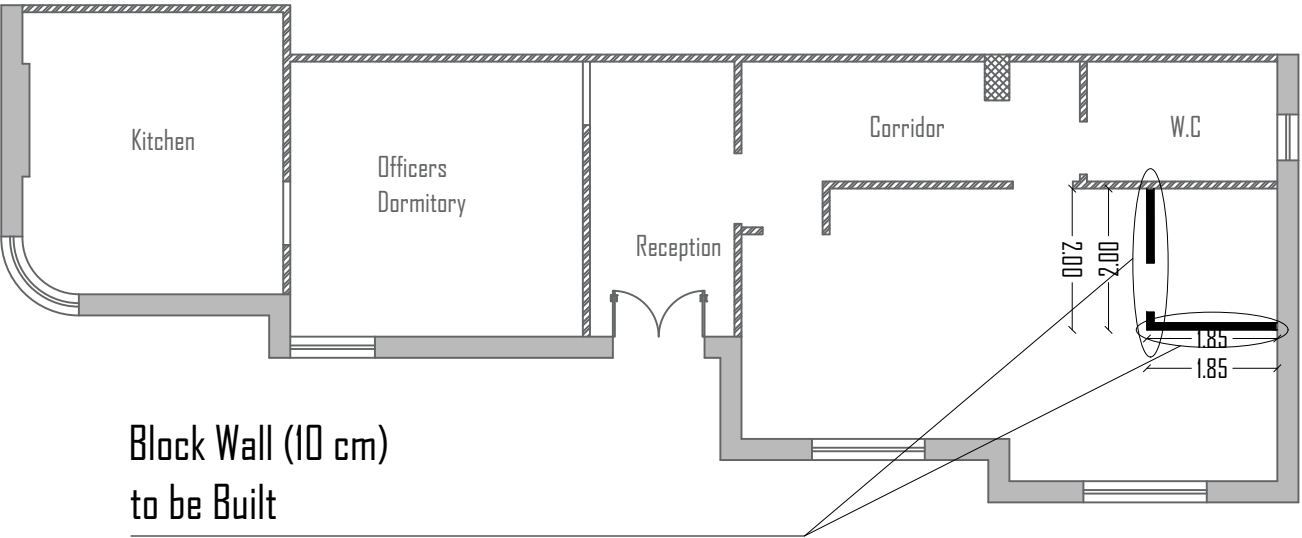

LEGEND

1- EXISTING EXTERNAL WALL	
2- REINFORCED CONCRETE	
3- CONCRETE BLOCK WALL	
4- EXTERIOR PAVING	

NOTES

Rev.:	Date:	Description:	Approved:
-------	-------	--------------	-----------

All information in this document is the property of PALESTINIAN CIVIL POLICE and cannot be copied anywhere but in this project without prior written consent of PALESTINIAN CIVIL POLICE.

Partners:

The Independent Commission For Human Rights (ICHR)	PALESTINIAN CIVIL POLICE

Funded by:

	Kingdom of Norway
--	-------------------

Design & Implementation:

	QURIE ARCHITECTURE
--	--------------------

Project Name:

Detention Centers Rehabilitation Project in the West Bank (Norwegian Grant)


Title:


Al-Qalaa Detention Center

Drawings Title:

To Be Built Walls Plan

Project No.:	Phase:	Discipline:	Date:	Drawing No.:
000000	01	A	8.2021	A03
Drawn:	Checked:	Approved:	Size:	Scale:
			A3	1:100

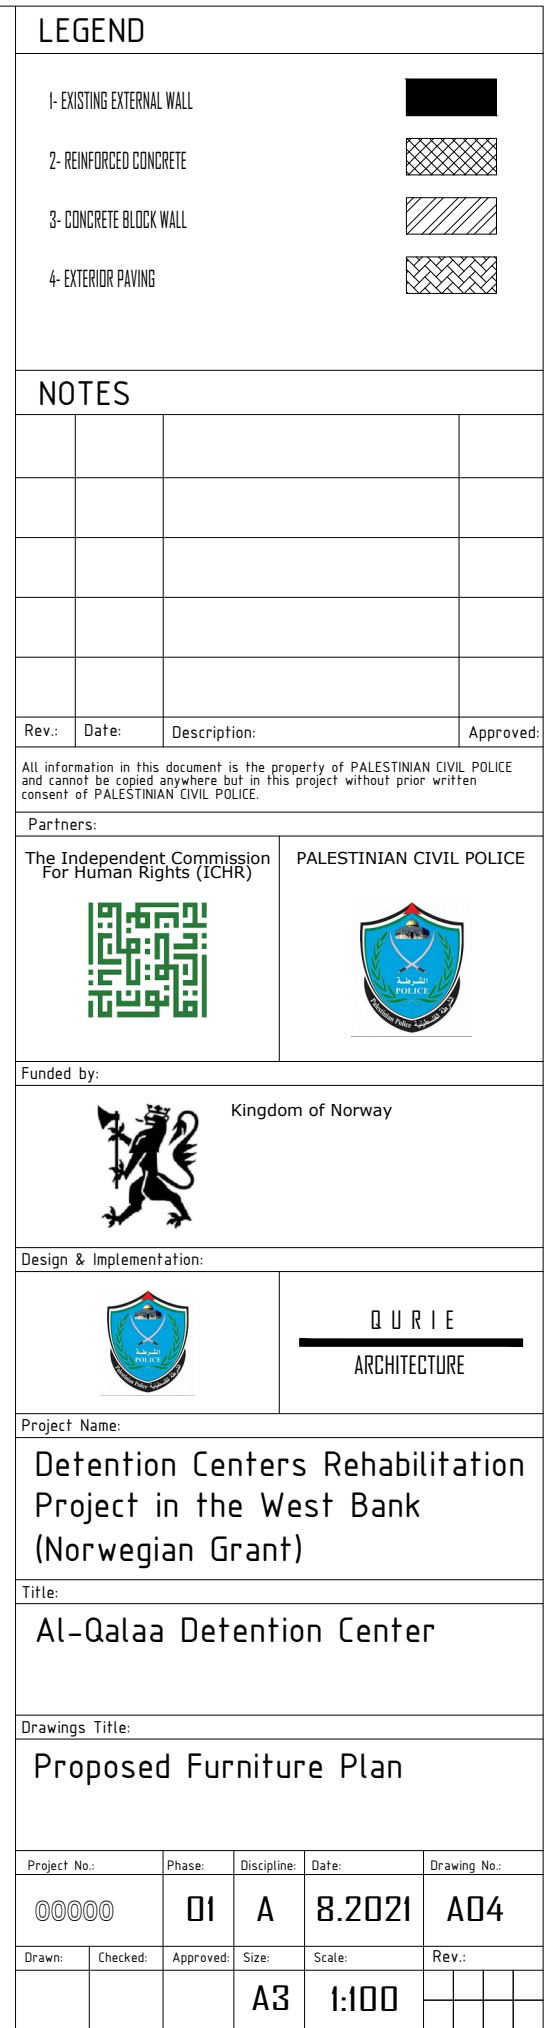

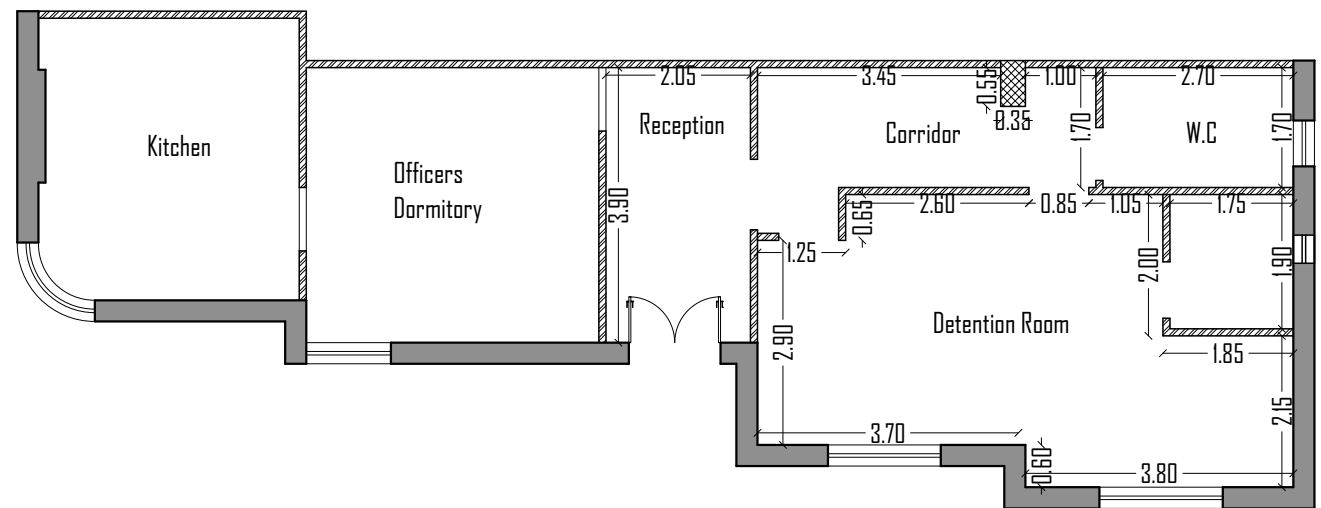



LEGEND

1- EXISTING EXTERNAL WALL	
2- REINFORCED CONCRETE	
3- CONCRETE BLOCK WALL	
4- EXTERIOR PAVING	


NOTES

Rev.:	Date:	Description:	Approved:
-------	-------	--------------	-----------

All information in this document is the property of PALESTINIAN CIVIL POLICE and cannot be copied anywhere but in this project without prior written consent of PALESTINIAN CIVIL POLICE.

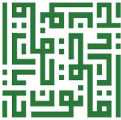Partners:	
The Independent Commission For Human Rights (ICHR)	PALESTINIAN CIVIL POLICE
	

Funded by:	
	Kingdom of Norway

Design & Implementation:	
	QURIE ARCHITECTURE

Project Name:
Detention Centers Rehabilitation Project in the West Bank (Norwegian Grant)

Title:
Al-Qalaa Detention Center

Drawings Title:
Proposed Dimensional Plan

Project No.:	Phase:	Discipline:	Date:	Drawing No.:
000000	01	A	8.2021	A05
Drawn:	Checked:	Approved:	Size:	Scale:
			A3	1:100

POLICE DETENTION CENTERS REHABILITATION PROJECT

CENTER NO (5):

HEBRON WOMEN DETENTION CENTER

LIST OF DRAWINGS

ARCHITECTURAL DRAWINGS

NO.	DRAWING TITLE
A00	List Of Drawings
A01	Existing Plan
A02	Proposed Plan

LEGEND

1- EXISTING EXTERNAL WALL

2- REINFORCED CONCRETE

3- CONCRETE BLOCK WALL

4- EXTERIOR PAVING

NOTES

Rev.:

Date:

Description:

Approved:

All information in this document is the property of PALESTINIAN CIVIL POLICE and cannot be copied anywhere but in this project without prior written consent of PALESTINIAN CIVIL POLICE.

Partners:

The Independent Commission For Human Rights (ICHR)

PALESTINIAN CIVIL POLICE

Funded by:

Kingdom of Norway

Design & Implementation:

QURIE
ARCHITECTURE

Project Name:

Detention Centers Rehabilitation
Project in the West Bank
(Norwegian Grant)

Title:

Al-Qalaa Detention Center

Drawings Title:

List Of Drawings

Project No.:

Phase:

Discipline:

Date:

Drawing No.:

000000

01

A

8.2021

A00

Drawn:

Checked:


Approved:

Size:

Scale:

Rev.:

A3

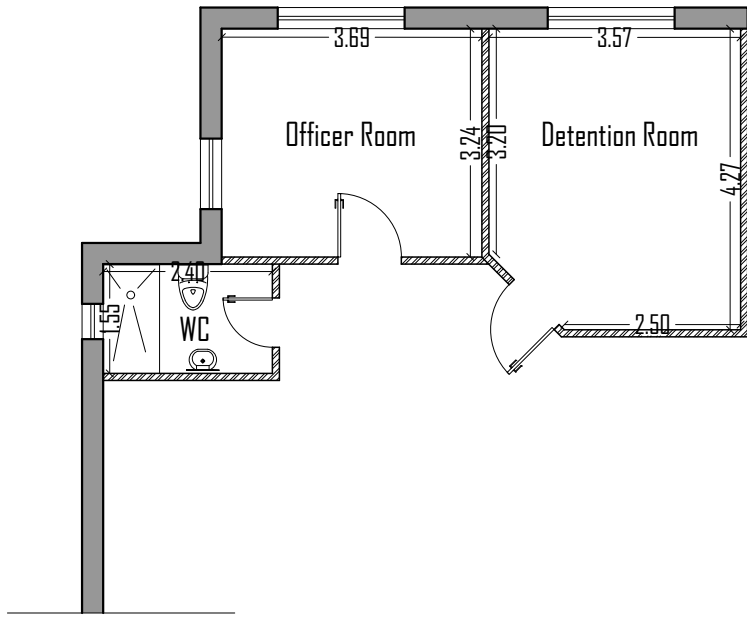

LEGEND


1- EXISTING EXTERNAL WALL	
2- REINFORCED CONCRETE	
3- CONCRETE BLOCK WALL	
4- EXTERIOR PAVING	


NOTES

Rev.:	Date:	Description:	Approved:
-------	-------	--------------	-----------

All information in this document is the property of PALESTINIAN CIVIL POLICE and cannot be copied anywhere but in this project without prior written consent of PALESTINIAN CIVIL POLICE.

Partners:

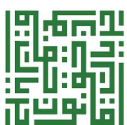
The Independent Commission For Human Rights (ICHR)


PALESTINIAN CIVIL POLICE


Funded by:

 Kingdom of Norway

Design & Implementation:



QURIE
ARCHITECTURE

Project Name:

Detention Centers Rehabilitation Project in the West Bank (Norwegian Grant)


Title:

Al-Qalaa Detention Center

Drawings Title:

Existing Plan

Project No.:	Phase:	Discipline:	Date:	Drawing No.:
000000	01	A	8.2021	A01
Drawn:	Checked:	Approved:	Size:	Scale:
			A3	1:100

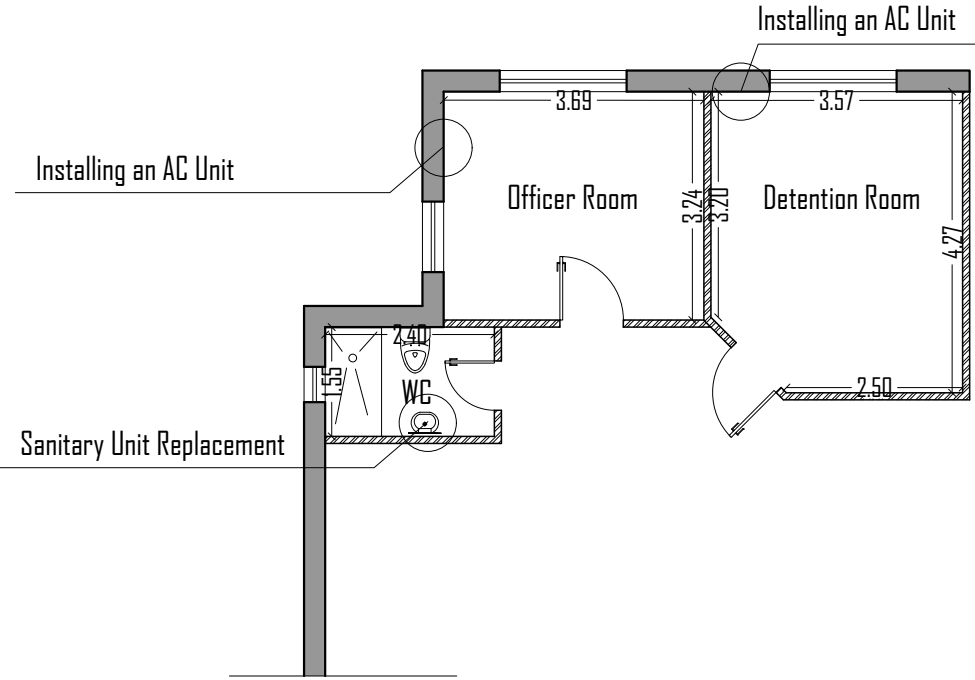

LEGEND

1- EXISTING EXTERNAL WALL	
2- REINFORCED CONCRETE	
3- CONCRETE BLOCK WALL	
4- EXTERIOR PAVING	

NOTES

		Height = 3.50m	

Rev.:	Date:	Description:	Approved:
-------	-------	--------------	-----------

All information in this document is the property of PALESTINIAN CIVIL POLICE and cannot be copied anywhere but in this project without prior written consent of PALESTINIAN CIVIL POLICE.

Partners:

The Independent Commission For Human Rights (ICHR)

PALESTINIAN CIVIL POLICE

Funded by:

Kingdom of Norway

Design & Implementation:

QURIE

ARCHITECTURE

Project Name:

Detention Centers Rehabilitation Project in the West Bank (Norwegian Grant)

Title:

Al-Qalaa Detention Center

Drawings Title:

Proposed Plan

Project No.:	Phase:	Discipline:	Date:	Drawing No.:
000000	01	A	8.2021	A02
Drawn:	Checked:	Approved:	Size:	Scale:
			A3	1:100

POLICE DETENTION CENTERS REHABILITATION PROJECT

CENTER NO (6):

CRIMINAL INVESTIGATION DETENTION CENTER

LIST OF DRAWINGS

ARCHITECTURAL DRAWINGS

NO.	DRAWING TITLE
A00	List Of Drawings
A01	Existing Plan
A02	Demolition Plan
A03	To Be Built Walls Plan
A04	Proposed Dimensional Plan

LEGEND

1- EXISTING EXTERNAL WALL

2- REINFORCED CONCRETE

3- CONCRETE BLOCK WALL

4- EXTERIOR PAVING

NOTES

Rev.:

Date:

Description:

Approved:

All information in this document is the property of PALESTINIAN CIVIL POLICE and cannot be copied anywhere but in this project without prior written consent of PALESTINIAN CIVIL POLICE.

Partners:

The Independent Commission For Human Rights (ICHR)

PALESTINIAN CIVIL POLICE

Funded by:

Kingdom of Norway

Design & Implementation:

QURIE
ARCHITECTURE

Project Name:

Detention Centers Rehabilitation Project in the West Bank (Norwegian Grant)

Title:

Al-Qalaa Detention Center

Drawings Title:

List Of Drawings

Project No.:

Phase:

Discipline:

Date:

Drawing No.:

000000

01

A

8.2021

A00

Drawn:

Checked:


Approved:

Size:

Scale:

Rev.:

A3

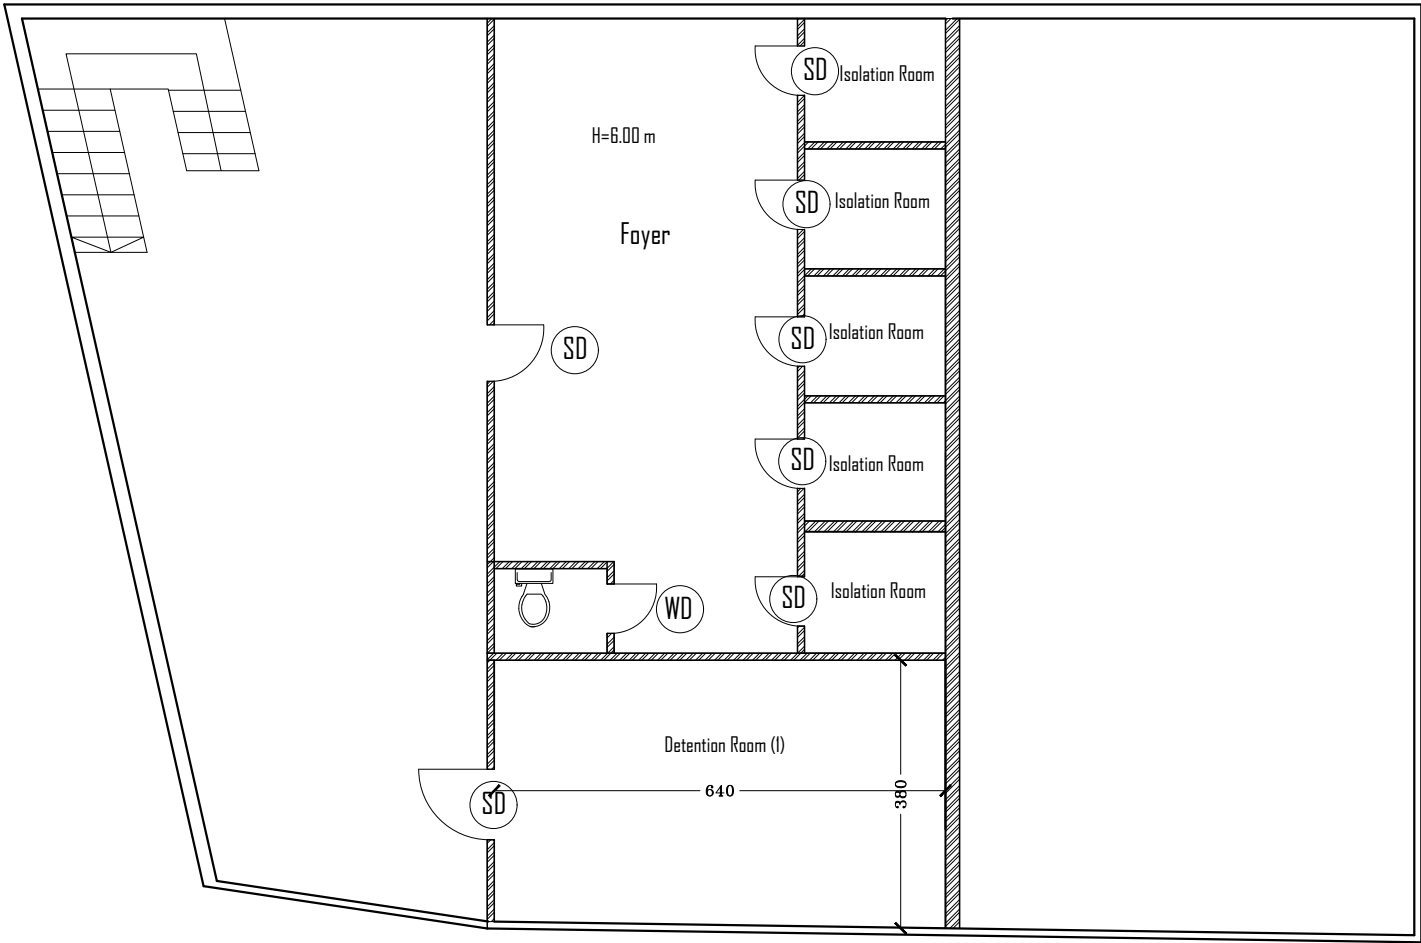

LEGEND

1- EXISTING EXTERNAL WALL	
2- REINFORCED CONCRETE	
3- CONCRETE BLOCK WALL	
4- EXTERIOR PAVING	

NOTES

Rev.:	Date:	Description:	Approved:
-------	-------	--------------	-----------

All information in this document is the property of PALESTINIAN CIVIL POLICE and cannot be copied anywhere but in this project without prior written consent of PALESTINIAN CIVIL POLICE.

Partners:	
The Independent Commission For Human Rights (ICHR)	PALESTINIAN CIVIL POLICE

Funded by:	
	Kingdom of Norway

Design & Implementation:	
	QURIE ARCHITECTURE


Project Name:
Detention Centers Rehabilitation Project in the West Bank (Norwegian Grant)

Title:
Al-Qalaa Detention Center

Drawings Title:
Existing Plan

Project No.:	Phase:	Discipline:	Date:	Drawing No.:
000000	01	A	8.2021	A01
Drawn:	Checked:	Approved:	Size:	Scale:
			A3	1:100

SD Steel Doors

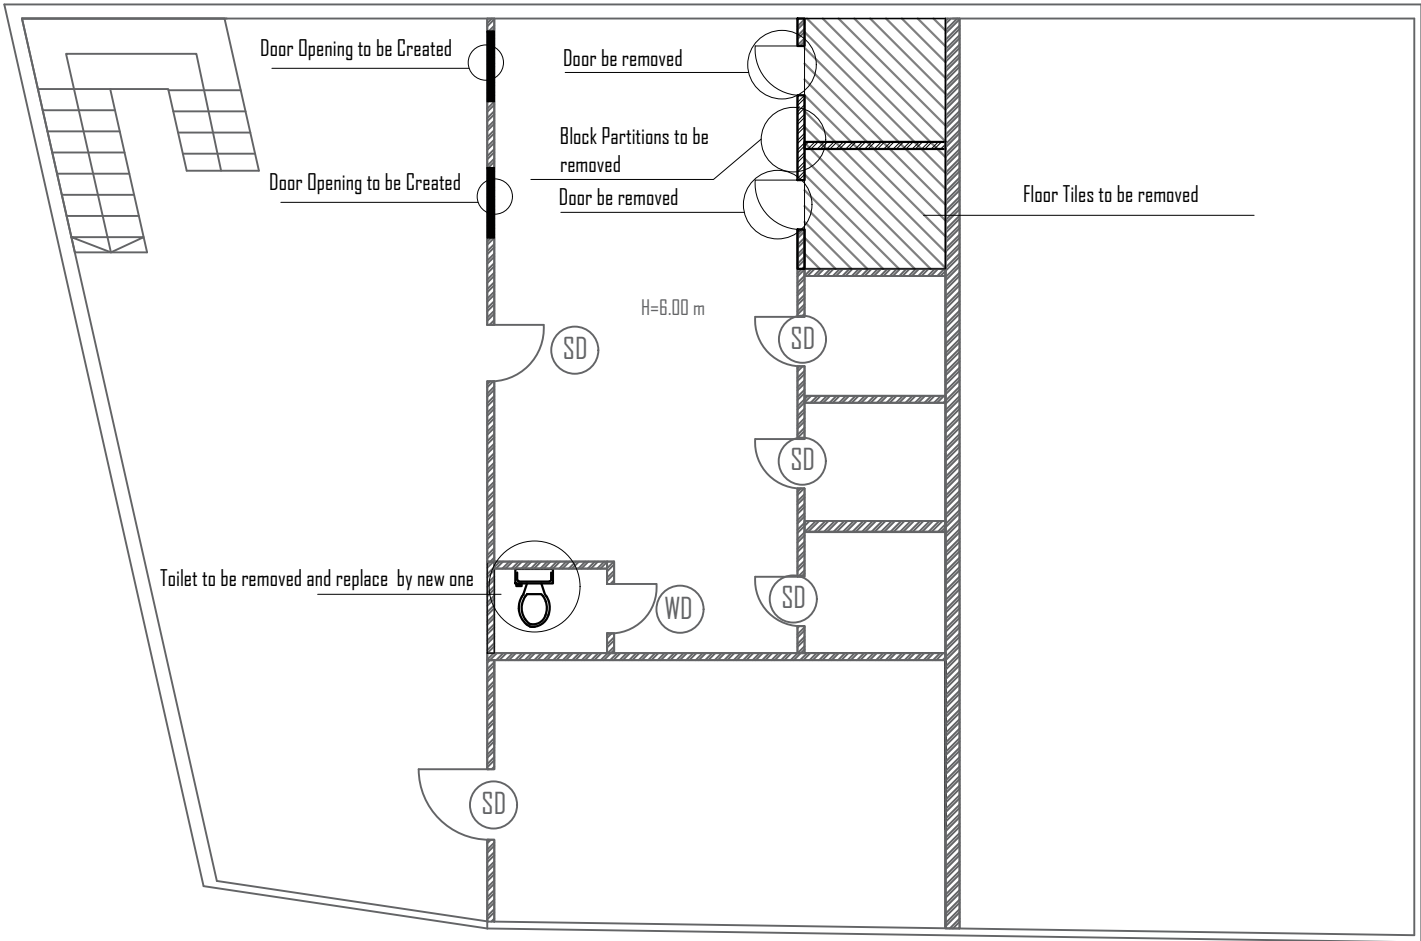

LEGEND

1- EXISTING EXTERNAL WALL	
2- REINFORCED CONCRETE	
3- CONCRETE BLOCK WALL	
4- EXTERIOR PAVING	

NOTES

Rev.:	Date:	Description:	Approved:
-------	-------	--------------	-----------

All information in this document is the property of PALESTINIAN CIVIL POLICE and cannot be copied anywhere but in this project without prior written consent of PALESTINIAN CIVIL POLICE.

Partners:	
The Independent Commission For Human Rights (ICHR)	PALESTINIAN CIVIL POLICE

Funded by:	
	Kingdom of Norway


Design & Implementation:	
	QURIE ARCHITECTURE

Project Name:
Detention Centers Rehabilitation Project in the West Bank (Norwegian Grant)

Title:
Al-Qalaa Detention Center

Drawings Title:
Demolition Plan

Project No.:	Phase:	Discipline:	Date:	Drawing No.:
000000	01	A	8.2021	A02
Drawn:	Checked:	Approved:	Size:	Scale:
			A3	1:100

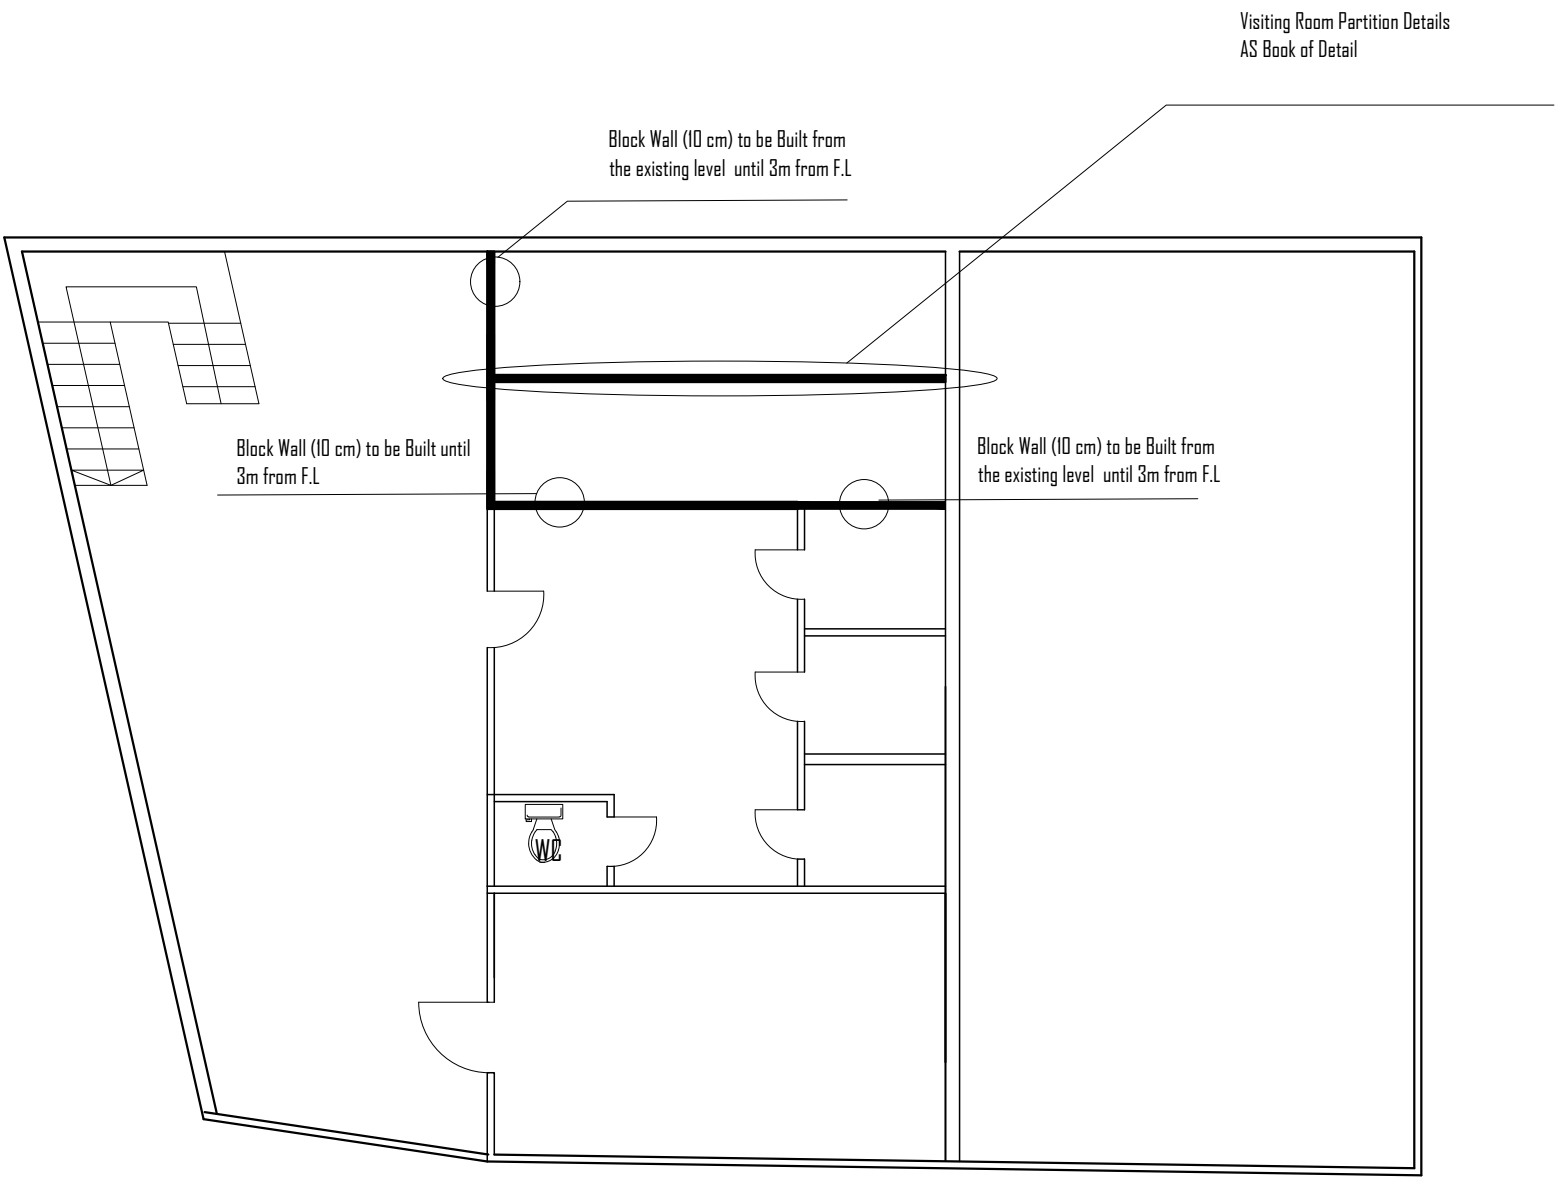

LEGEND



1- EXISTING EXTERNAL WALL	
2- REINFORCED CONCRETE	
3- CONCRETE BLOCK WALL	
4- EXTERIOR PAVING	

NOTES

Rev.:	Date:	Description:	Approved:
-------	-------	--------------	-----------

All information in this document is the property of PALESTINIAN CIVIL POLICE and cannot be copied anywhere but in this project without prior written consent of PALESTINIAN CIVIL POLICE.


Partners:

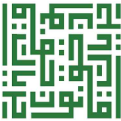The Independent Commission For Human Rights (ICHR)	PALESTINIAN CIVIL POLICE
	

Funded by:

	Kingdom of Norway
---	-------------------

Design & Implementation:

	QURIE ARCHITECTURE
---	-----------------------

Project Name:

Detention Centers Rehabilitation Project in the West Bank (Norwegian Grant)


Title:

Al-Qalaa Detention Center

Drawings Title:

To Be Built Walls Plan

Project No.:	Phase:	Discipline:	Date:	Drawing No.:
000000	01	A	8.2021	A03
Drawn:	Checked:	Approved:	Size:	Scale:
			A3	1:100

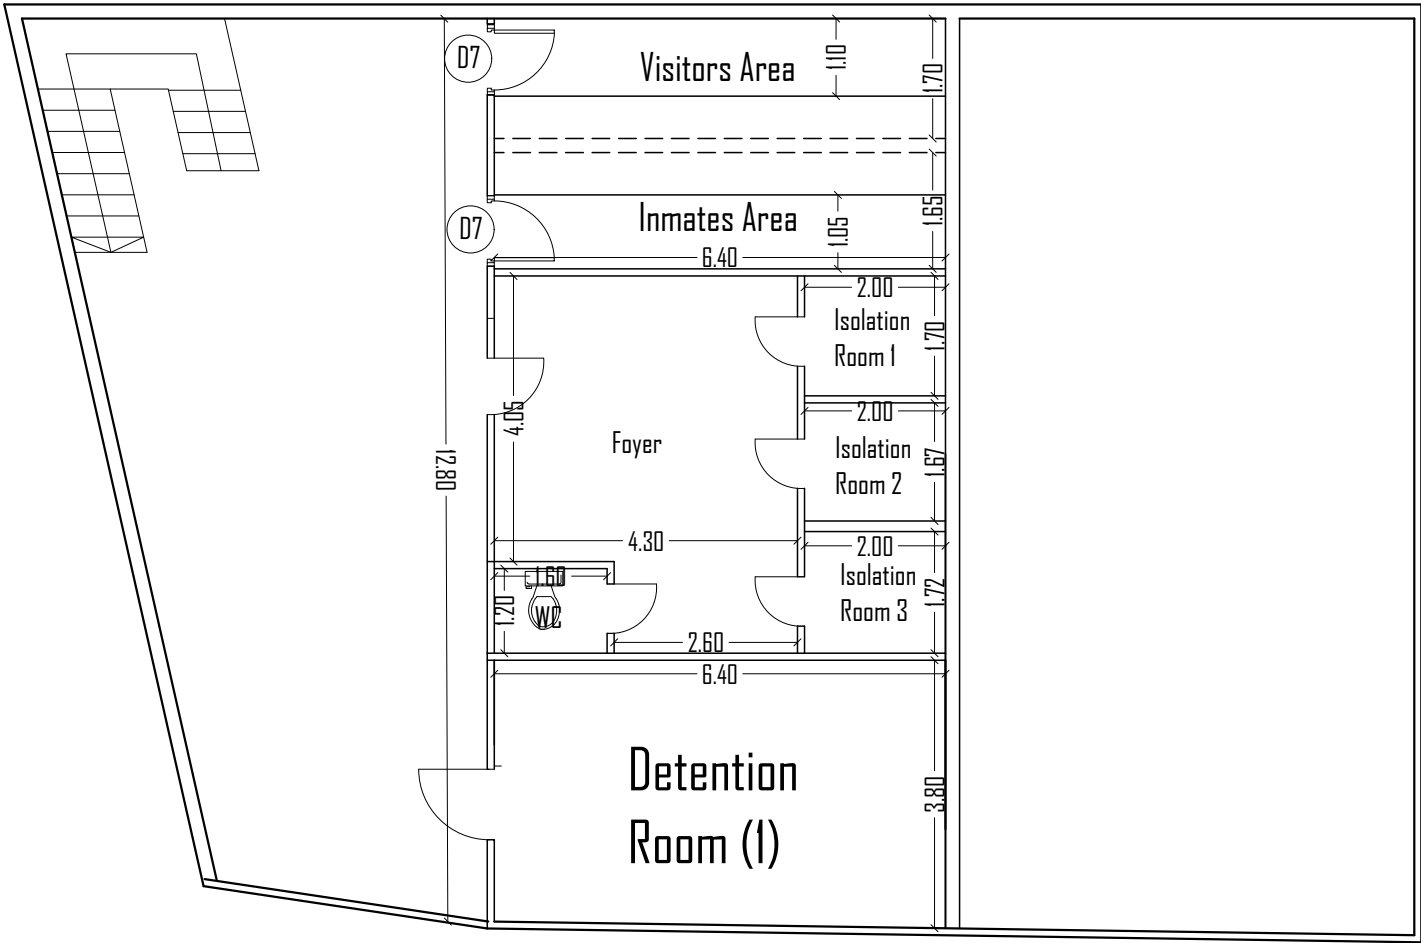

LEGEND

1- EXISTING EXTERNAL WALL	
2- REINFORCED CONCRETE	
3- CONCRETE BLOCK WALL	
4- EXTERIOR PAVING	

NOTES

Rev.:	Date:	Description:	Approved:
-------	-------	--------------	-----------

All information in this document is the property of PALESTINIAN CIVIL POLICE and cannot be copied anywhere but in this project without prior written consent of PALESTINIAN CIVIL POLICE.

Partners:

The Independent Commission For Human Rights (ICHR)

PALESTINIAN CIVIL POLICE

Funded by:

Kingdom of Norway

Design & Implementation:

QURIE

ARCHITECTURE

Project Name:

Detention Centers Rehabilitation Project in the West Bank (Norwegian Grant)


Title:

Al-Qalaa Detention Center

Drawings Title:

Proposed Dimensional Plan

Project No.:	Phase:	Discipline:	Date:	Drawing No.:
000000	01	A	8.2021	A04
Drawn:	Checked:	Approved:	Size:	Scale:
			A3	1:100

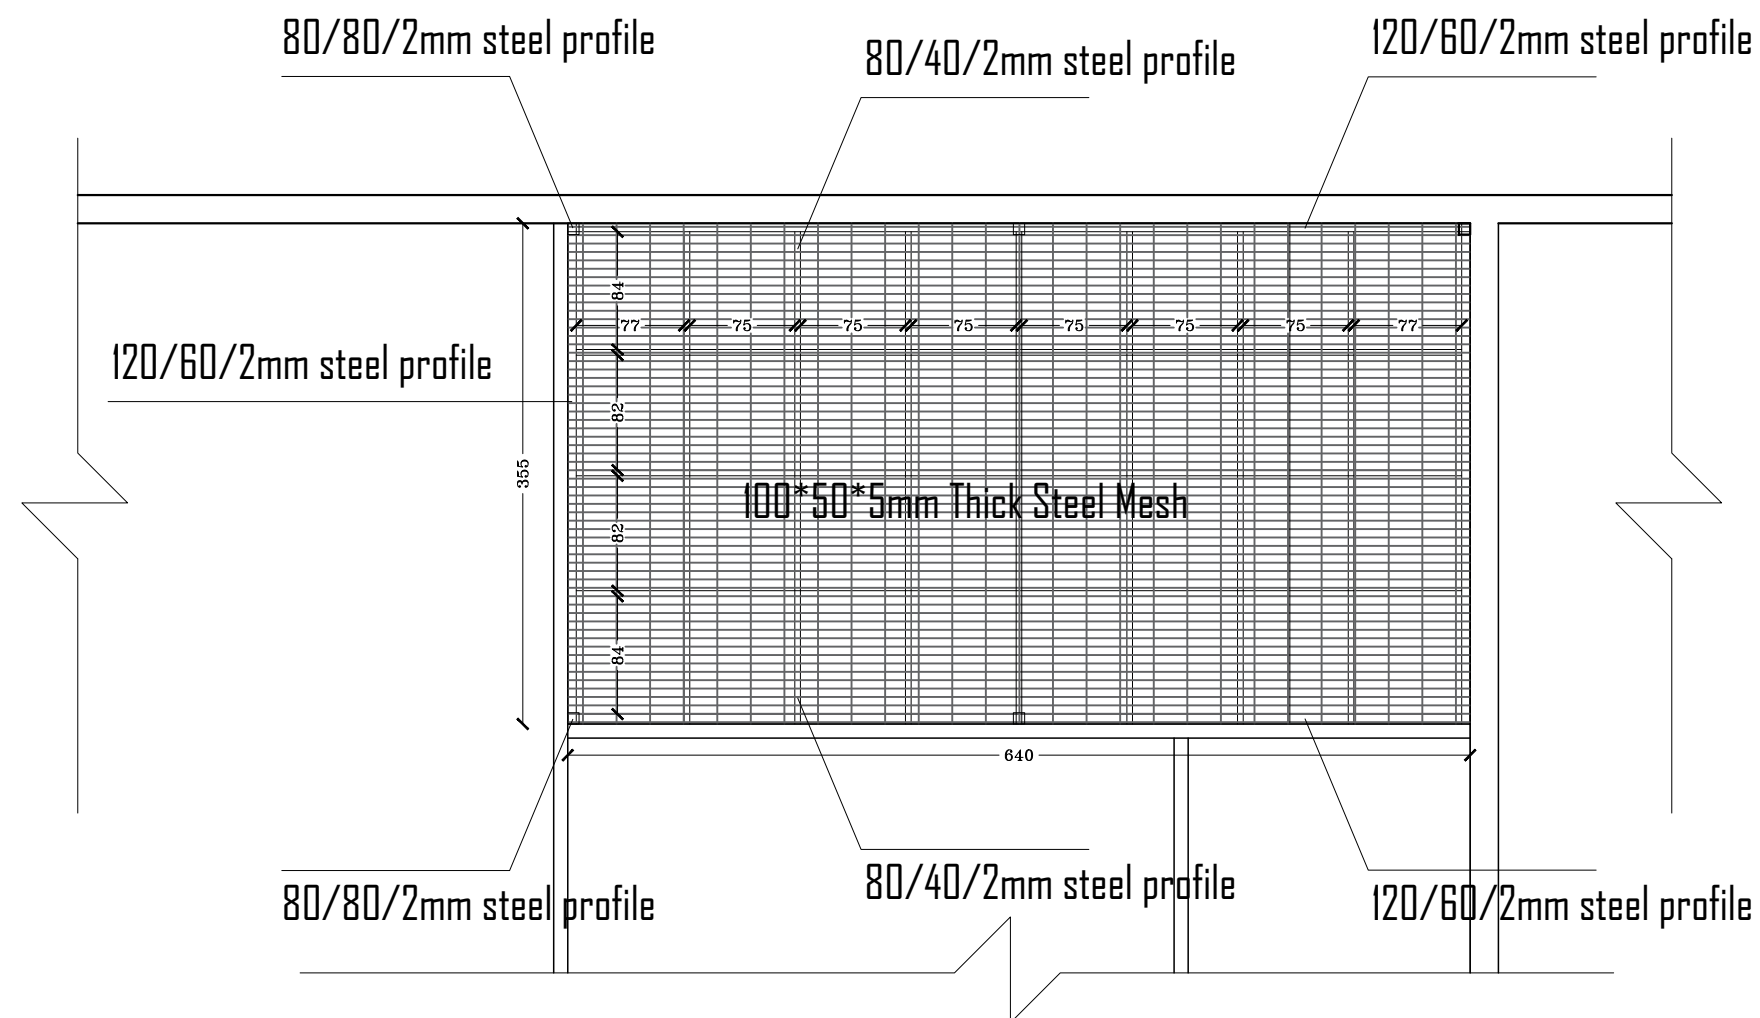

LEGEND

1- EXISTING EXTERNAL WALL	
2- REINFORCED CONCRETE	
3- CONCRETE BLOCK WALL	
4- EXTERIOR PAVING	


NOTES

Rev.:	Date:	Description:	Approved:		
All information in this document is the property of PALESTINIAN CIVIL POLICE and cannot be copied anywhere but in this project without prior written consent of PALESTINIAN CIVIL POLICE.					
Partners:					
The Independent Commission For Human Rights (ICHR)		PALESTINIAN CIVIL POLICE			
Funded by:					
		Kingdom of Norway			
Design & Implementation:					
		QURIE ARCHITECTURE			
Project Name:					
Detention Centers Rehabilitation Project in the West Bank (Norwegian Grant)					
Title:					
Al-Qalaa Detention Center					
Drawings Title:					
Proposed Ceiling for Visiting Room					
Project No.:	Phase:	Discipline:	Date:	Drawing No.:	
000000	01	A	8.2021	A05	
Drawn:	Checked:	Approved:	Size:	Scale:	Rev.:
			A3	1:50	


POLICE DETENTION CENTERS REHABILITATION PROJECT

CENTER NO (7):


Bethlehem Detention Center

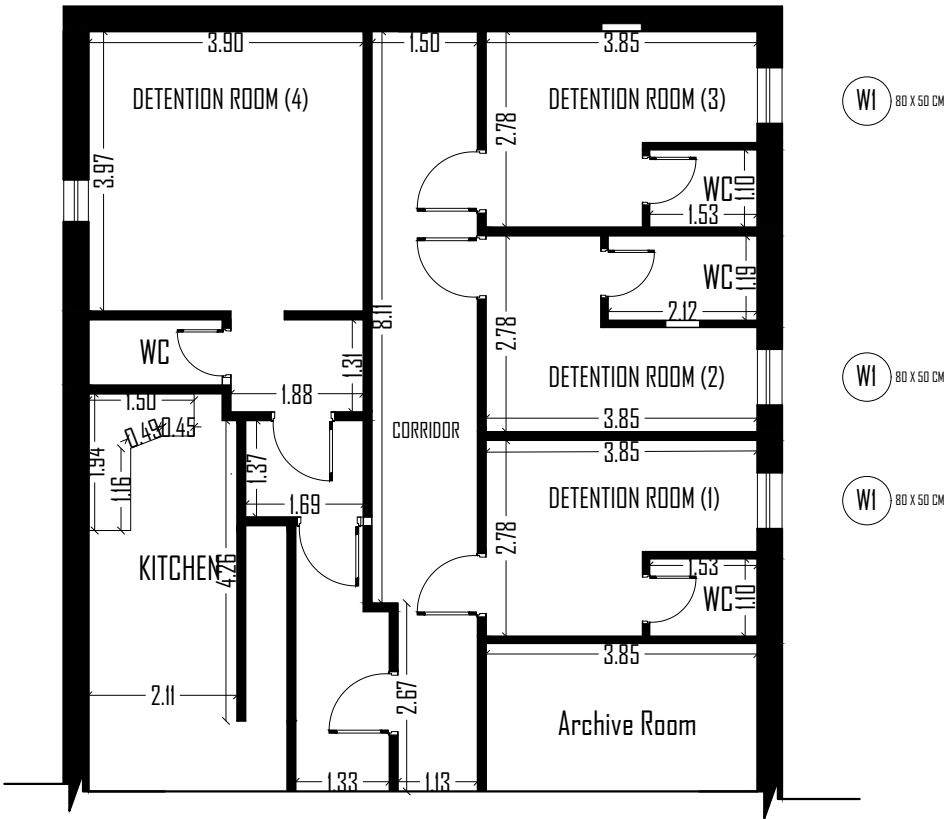

Bethlehem Detention Center

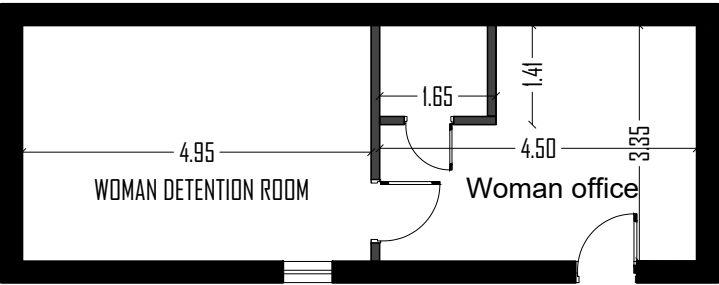

Bethlehem Detention Center for Woman

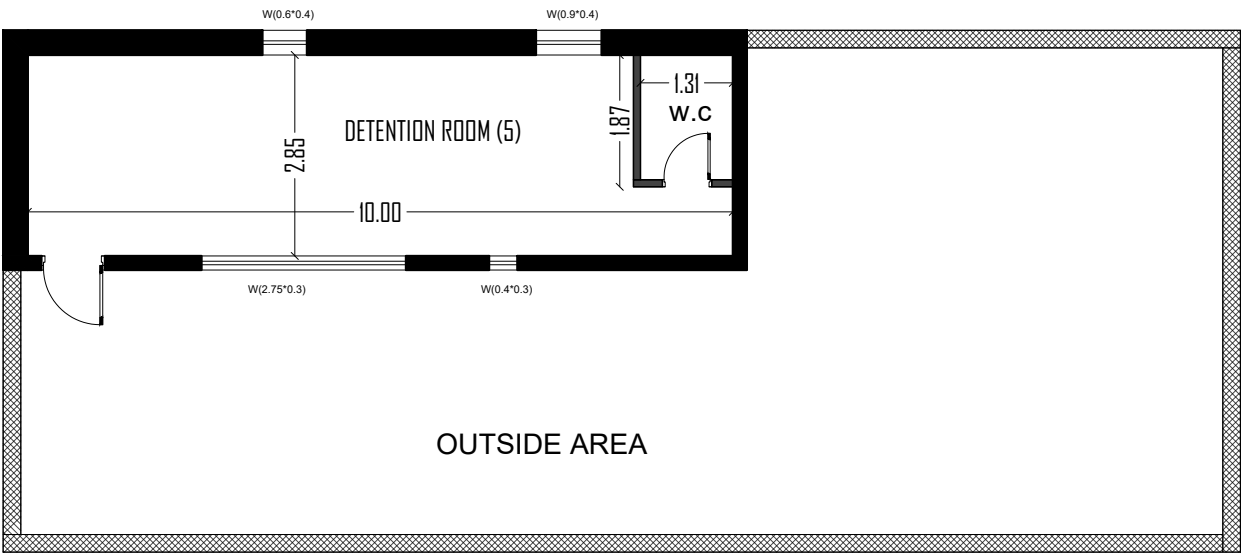

Cell 5 in Bethlehem Detention Center

LEGEND

1- EXISTING EXTERNAL WALL

2- REINFORCED CONCRETE

3- CONCRETE BLOCK WALL

4- EXTERIOR PAVING

NOTES

Rev.:

Date:

Description:

Approved:


All information in this document is the property of PALESTINIAN CIVIL POLICE and cannot be copied anywhere but in this project without prior written consent of PALESTINIAN CIVIL POLICE.

Partners:


The Independent Commission For Human Rights (ICHR)

PALESTINIAN CIVIL POLICE

Funded by:

Kingdom of Norway

Design & Implementation:



QURIE

ARCHITECTURE

Project Name:

Detention Centers Rehabilitation Project in the West Bank (Norwegian Grant)

Title:

Bethlehem DETENTION CENTER

Drawings Title:

As Built Plan

Project No.:

000000

Phase:

01

Discipline:

A

Date:

8.2021

Drawing No.:

A01

Drawn:

Checked:


Approved:

Size:


A3

Scale:


Rev.:

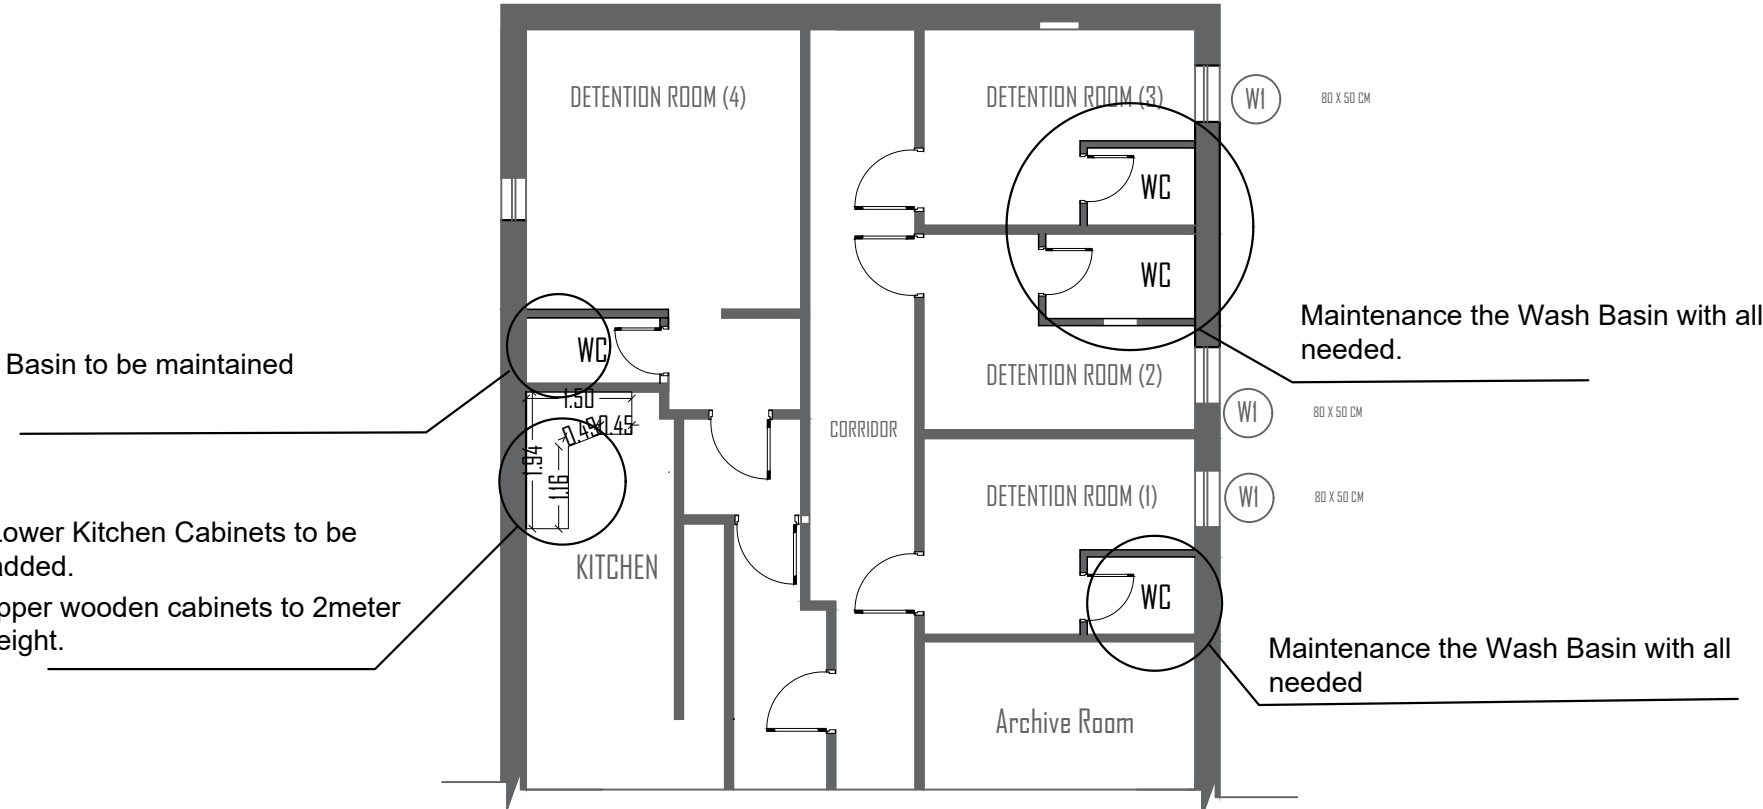

Bethlehem Detention Center

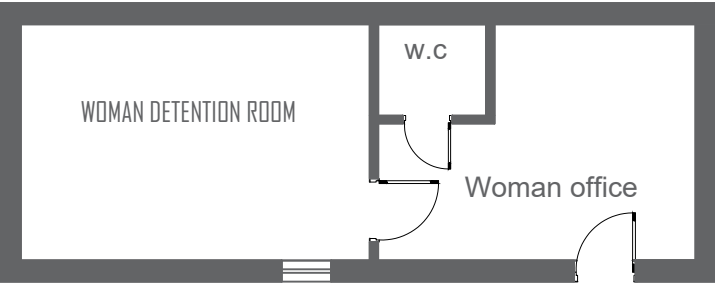

Bethlehem Detention Center for Woman

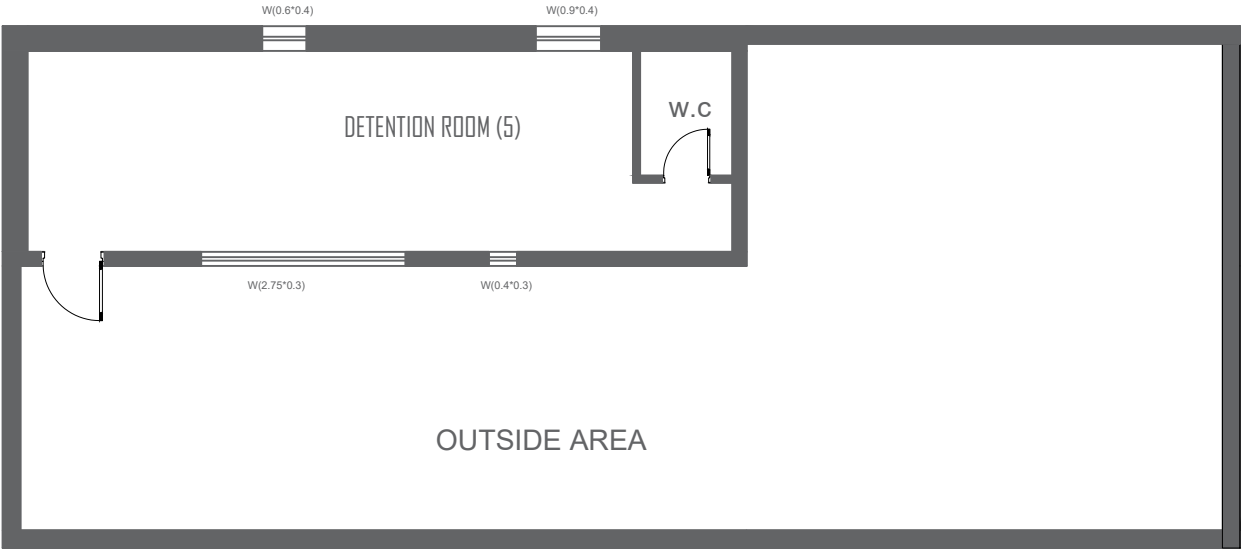

Cell 5 in Bethlehem Detention Center

LEGEND

1- EXISTING EXTERNAL WALL	
2- REINFORCED CONCRETE	
3- CONCRETE BLOCK WALL	
4- EXTERIOR PAVING	

NOTES

Rev.:	Date:	Description:	Approved:
-------	-------	--------------	-----------

All information in this document is the property of PALESTINIAN CIVIL POLICE and cannot be copied anywhere but in this project without prior written consent of PALESTINIAN CIVIL POLICE.

Partners:

The Independent Commission For Human Rights (ICHR)

PALESTINIAN CIVIL POLICE

Funded by:

Kingdom of Norway

Design & Implementation:

QURIE
ARCHITECTURE

Project Name:

Detention Centers Rehabilitation Project in the West Bank (Norwegian Grant)

Title:

Bethlehem
DETENTION CENTER

Drawings Title:

Proposed Plan

Project No.:	Phase:	Discipline:	Date:	Drawing No.:
000000	01	A	8.2021	A02
Drawn:	Checked:	Approved:	Size:	Scale:
			A3	

POLICE DETENTION CENTERS REHABILITATION PROJECT





CENTER NO (8):

Al-Ebidya Detention Center

LIST OF DRAWINGS



[illegible]


LEGEND

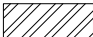
1- EXISTING EXTERNAL WALL	
2- REINFORCED CONCRETE	
3- CONCRETE BLOCK WALL	
4- EXTERIOR PAVING	

NOTES			
Rev.:	Date:	Description:	Approved:

All information in this document is the property of PALESTINIAN CIVIL POLICE and cannot be copied anywhere but in this project without prior written consent of PALESTINIAN CIVIL POLICE.

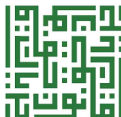Partners:	
The Independent Commission For Human Rights (ICHR)	PALESTINIAN CIVIL POLICE
	

Funded by:	
	Kingdom of Norway


Design & Implementation:	
	<div>QURIE</div> <hr/> <div>ARCHITECTURE</div>

Project Name:				
Detention Centers Rehabilitation Project in the West Bank (Norwegian Grant)				

Title:				
Al-Ebidya DETENTION CENTER				

Drawings Title:				
List Of Drawings				

Project No.:	Phase:	Discipline:	Date:	Drawing No.:
000000	01	A	8.2021	A00
Drawn:	Checked:	Approved:	Size:	Scale:
			A3	

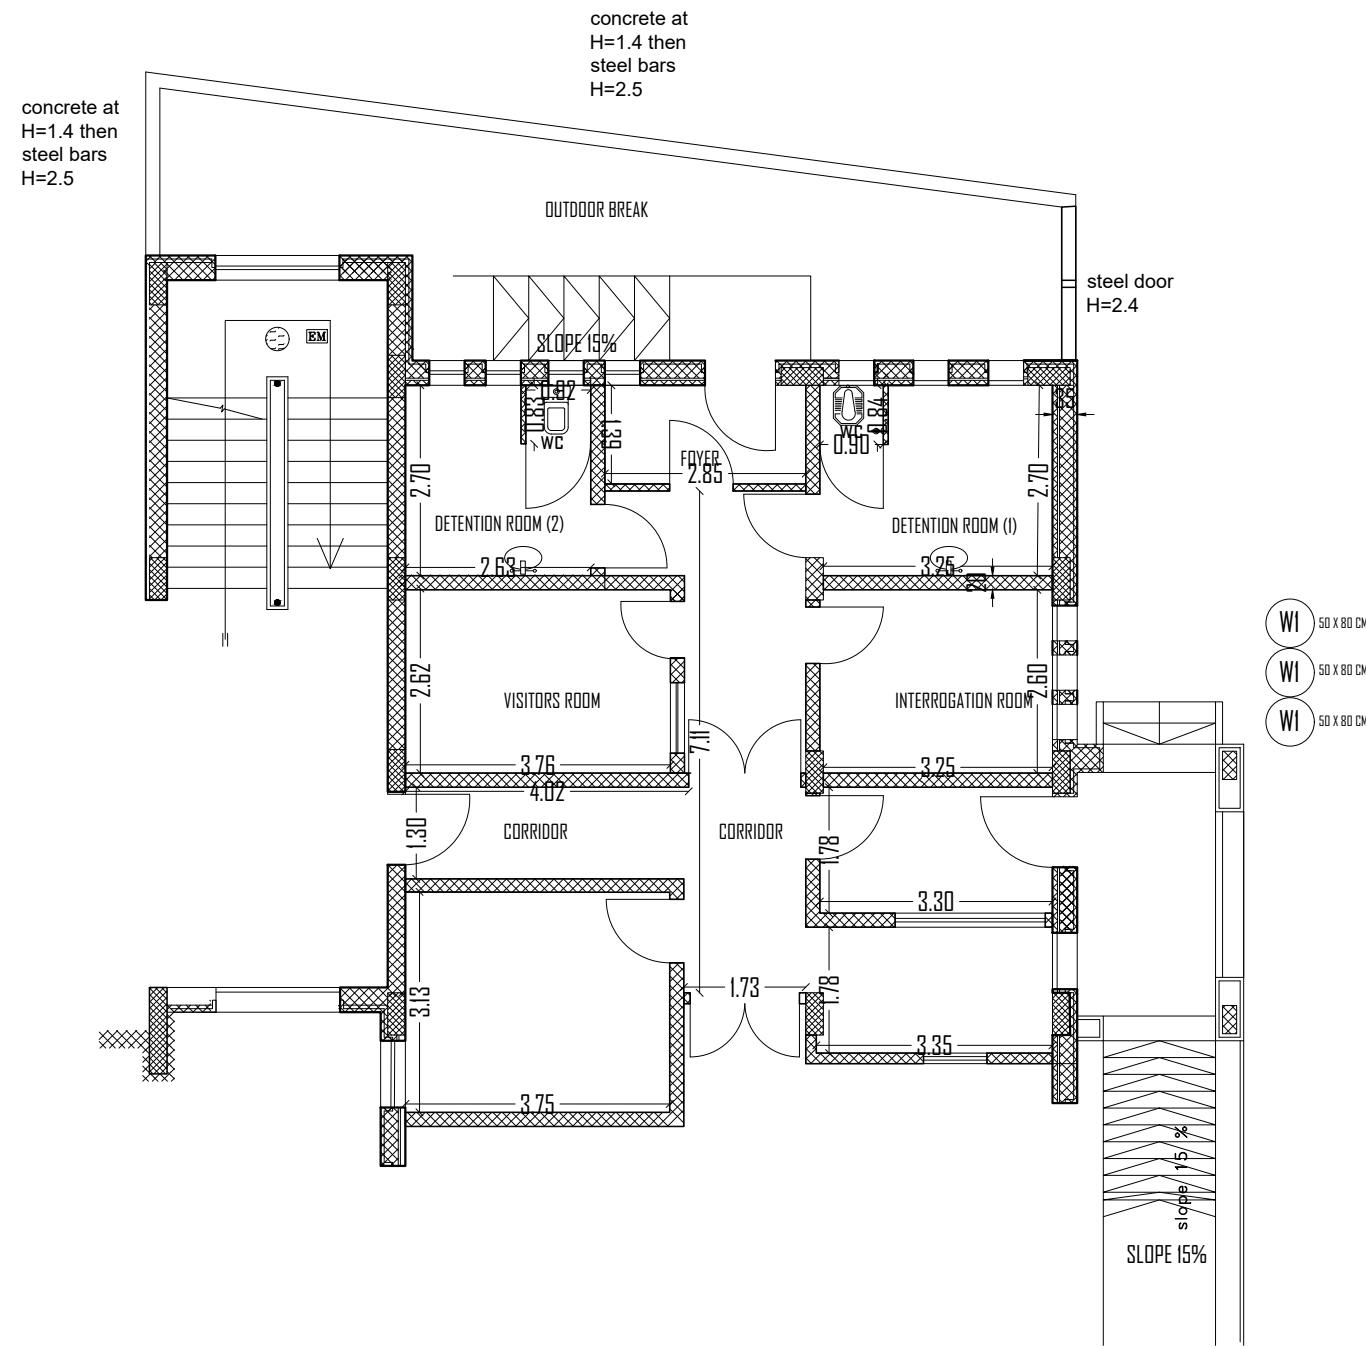


LEGEND

1- EXISTING EXTERNAL WALL	
2- REINFORCED CONCRETE	
3- CONCRETE BLOCK WALL	
4- EXTERIOR PAVING	

NOTES

Rev.:	Date:	Description:	Approved:		
All information in this document is the property of PALESTINIAN CIVIL POLICE and cannot be copied anywhere but in this project without prior written consent of PALESTINIAN CIVIL POLICE.					
Partners:					
The Independent Commission For Human Rights (ICHR)		PALESTINIAN CIVIL POLICE			
Funded by:					
		Kingdom of Norway			
Design & Implementation:					
		QURIE ARCHITECTURE			
Project Name:					
Detention Centers Rehabilitation Project in the West Bank (Norwegian Grant)					
Title:					
Al-Ebidya DETENTION CENTER					
Drawings Title:					
As Built Plan					
Project No.:	Phase:	Discipline:	Date:	Drawing No.:	
00000	01	A	8.2021	A01	
Drawn:	Checked:	Approved:	Size:	Scale:	Rev.:
			A3		

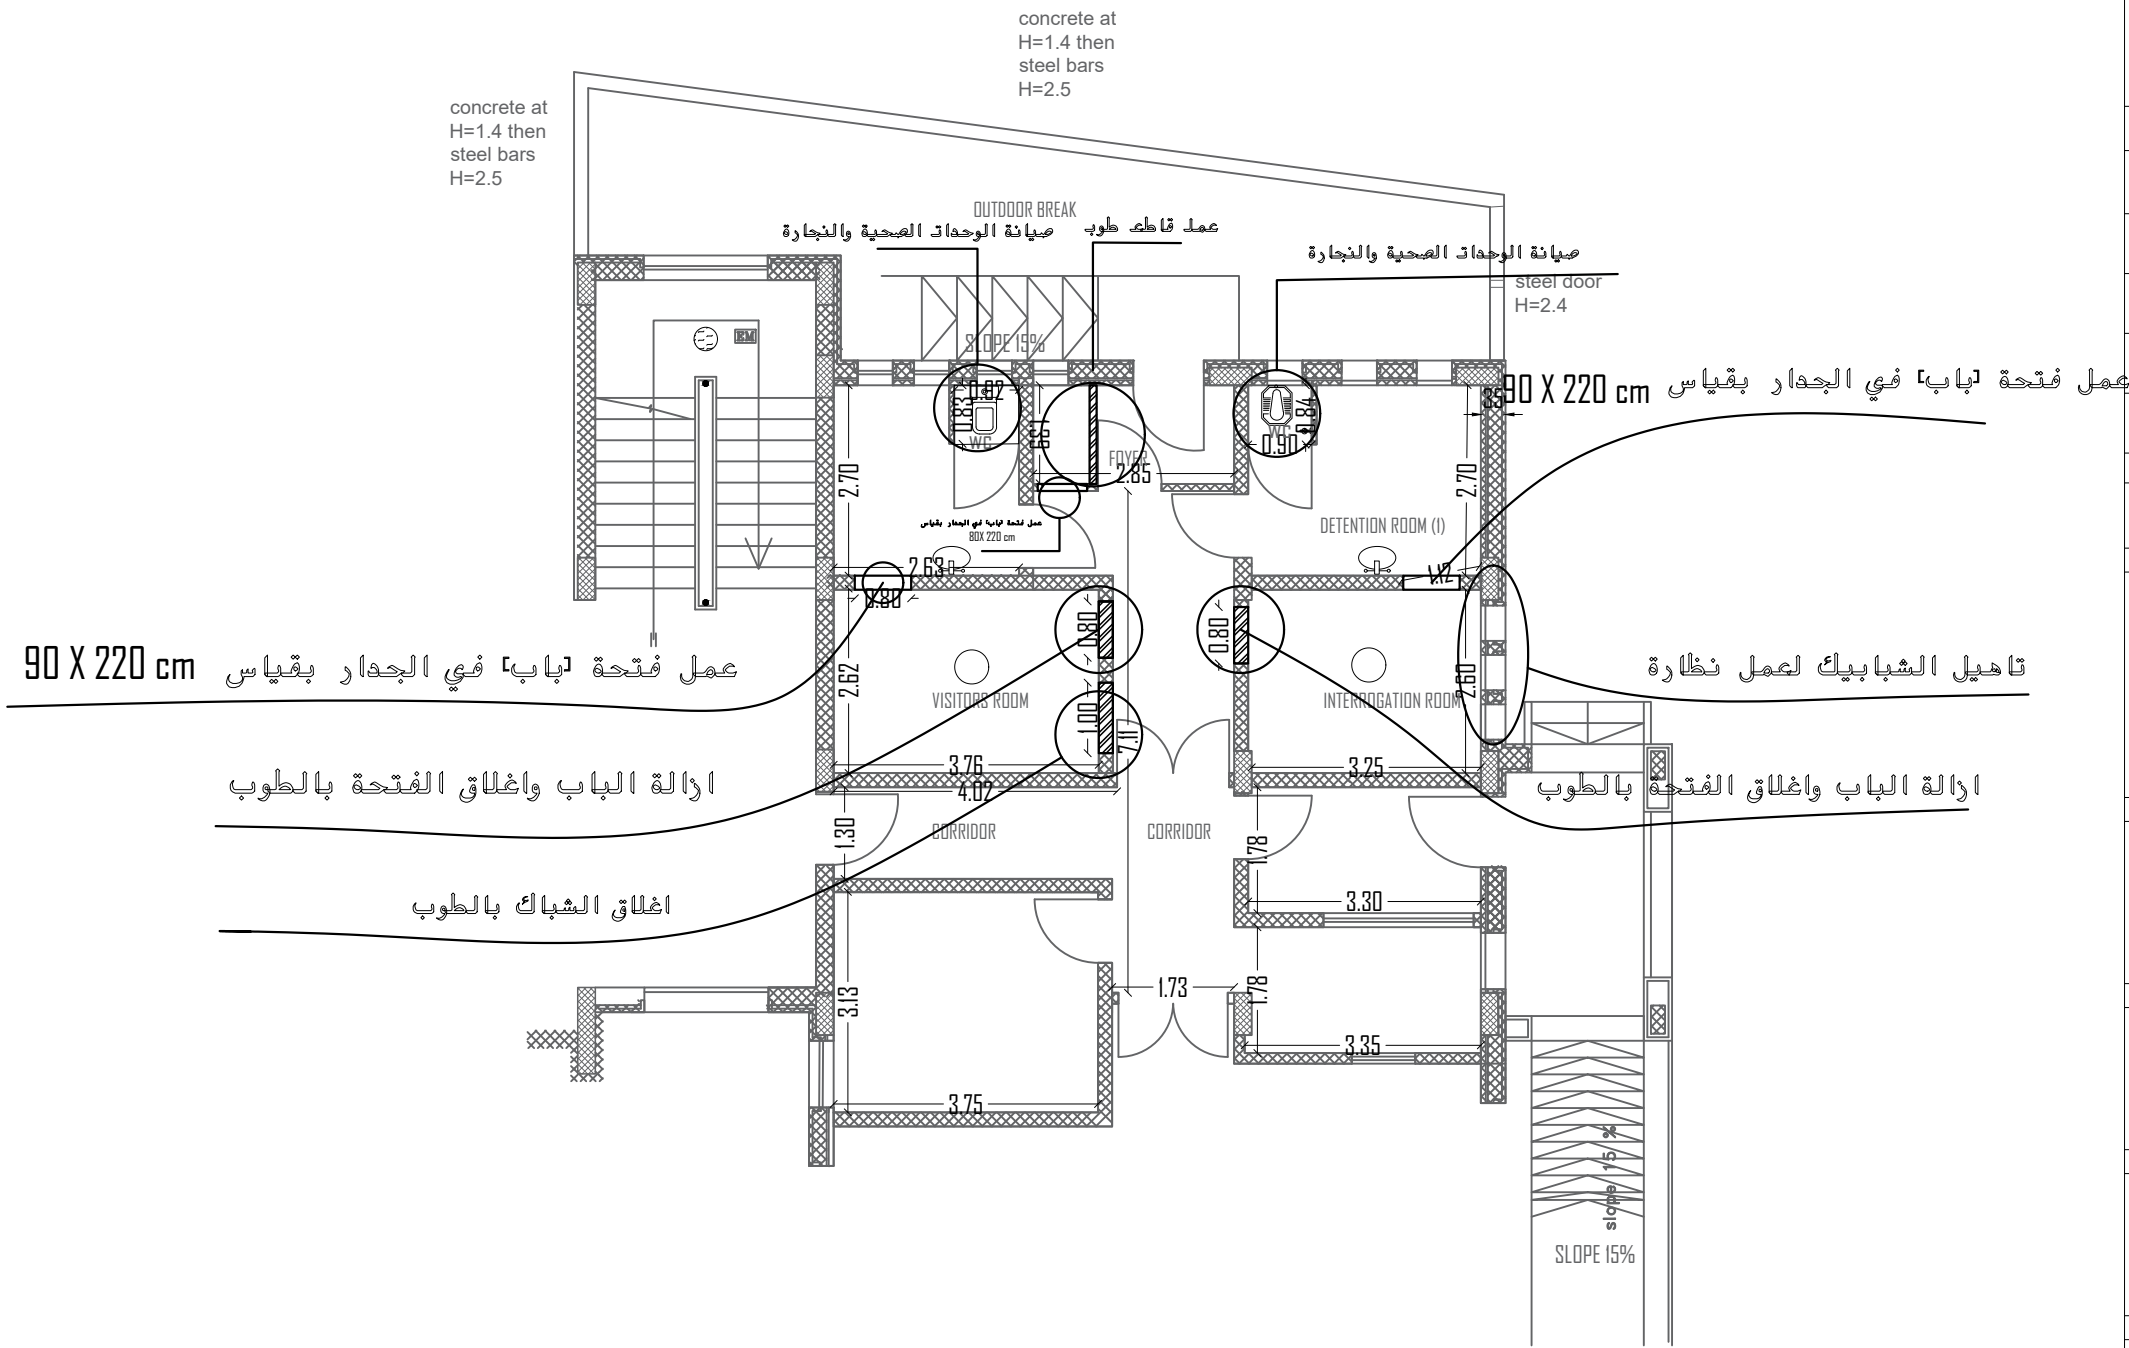


LEGEND

1- EXISTING EXTERNAL WALL	
2- REINFORCED CONCRETE	
3- CONCRETE BLOCK WALL	
4- EXTERIOR PAVING	

NOTES

Rev.:	Date:	Description:	Approved:		
All information in this document is the property of PALESTINIAN CIVIL POLICE and cannot be copied anywhere but in this project without prior written consent of PALESTINIAN CIVIL POLICE.					
Partners:					
The Independent Commission For Human Rights (ICHR)		PALESTINIAN CIVIL POLICE			
Funded by:					
		Kingdom of Norway			
Design & Implementation:					
		QURIE ARCHITECTURE			
Project Name:					
Detention Centers Rehabilitation Project in the West Bank (Norwegian Grant)					
Title:					
Al-Ebidya DETENTION CENTER					
Drawings Title:					
Addition Demolition Plan					
Project No.:	Phase:	Discipline:	Date:	Drawing No.:	
000000	01	A	8.2021	A02	
Drawn:	Checked:	Approved:	Size:	Scale:	Rev.:
			A3		

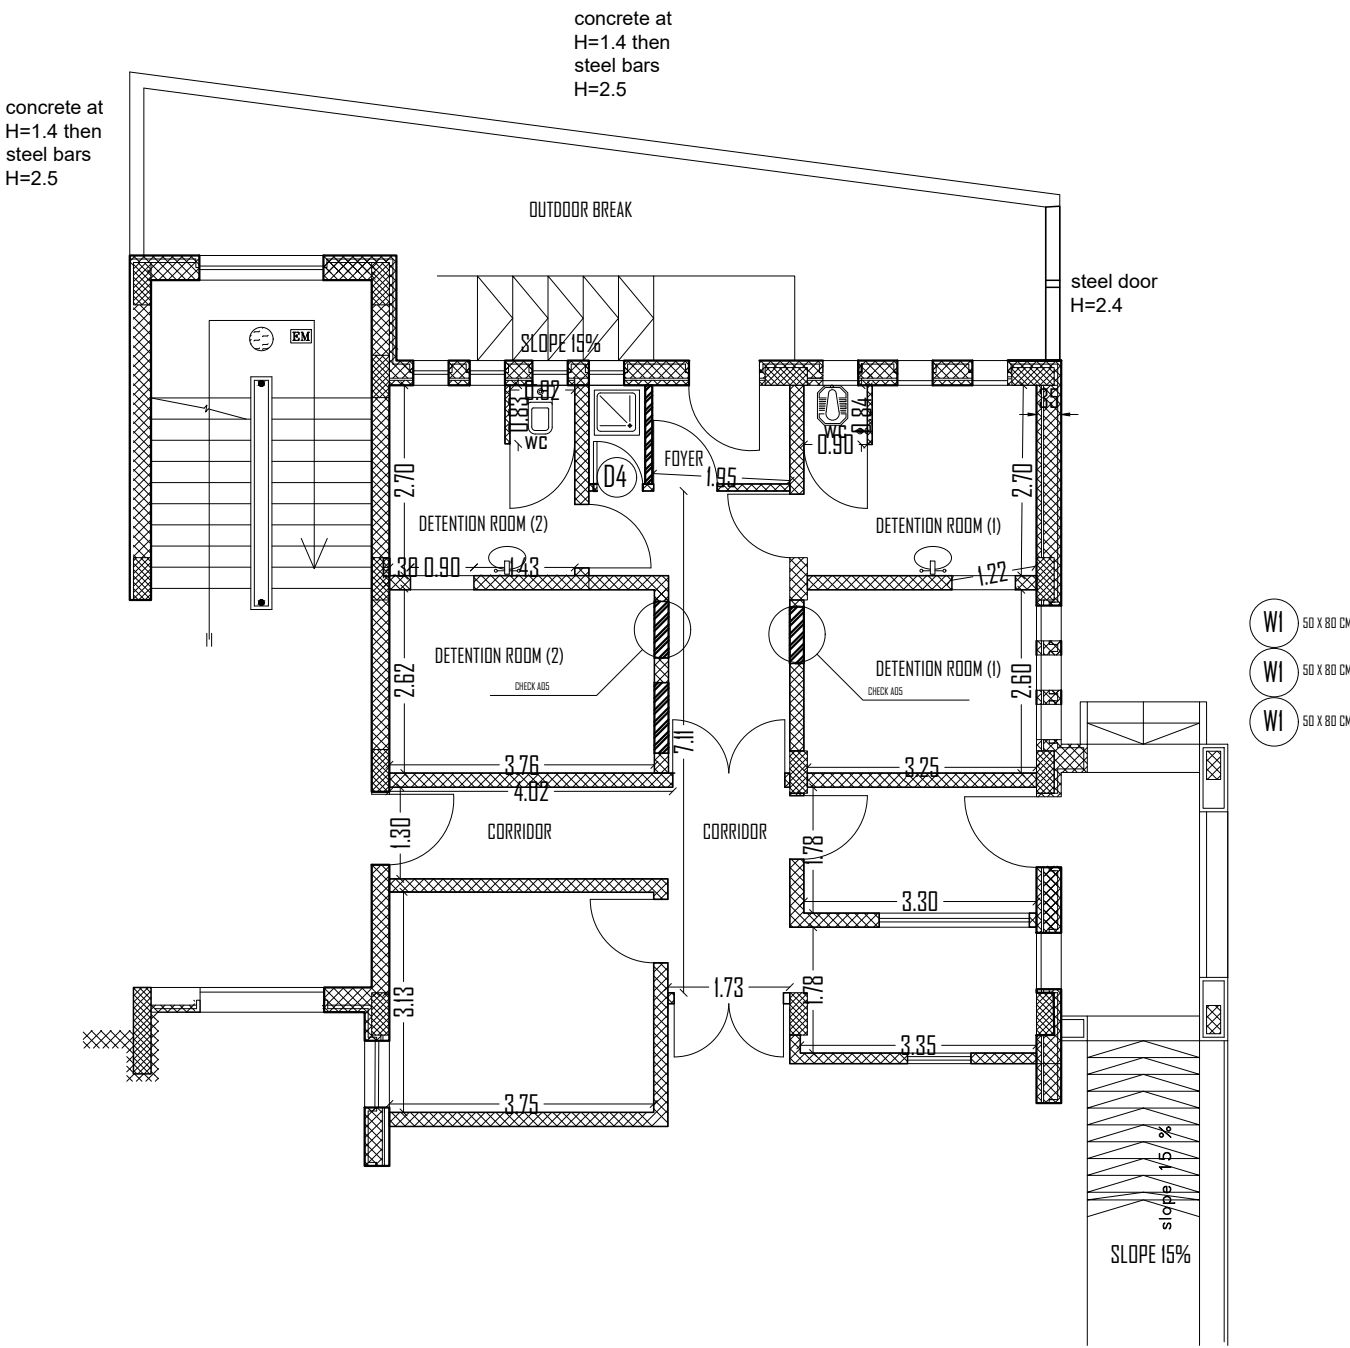

LEGEND

1- EXISTING EXTERNAL WALL	
2- REINFORCED CONCRETE	
3- CONCRETE BLOCK WALL	
4- EXTERIOR PAVING	

NOTES

Rev.:	Date:	Description:	Approved:
-------	-------	--------------	-----------

All information in this document is the property of PALESTINIAN CIVIL POLICE and cannot be copied anywhere but in this project without prior written consent of PALESTINIAN CIVIL POLICE.

Partners:	
The Independent Commission For Human Rights (ICHR)	PALESTINIAN CIVIL POLICE

Funded by:	
	Kingdom of Norway

Design & Implementation:	
	QURIE ARCHITECTURE


Project Name:	
Detention Centers Rehabilitation Project in the West Bank (Norwegian Grant)	

Title:	
Al-Ebidya DETENTION CENTER	

Drawings Title:	
Proposed Dimensional Plan	

Project No.:	Phase:	Discipline:	Date:	Drawing No.:
000000	01	A	8.2021	A03
Drawn:	Checked:	Approved:	Size:	Scale:
			A3	

TYPICAL LINTEL DETAILS
1: 10

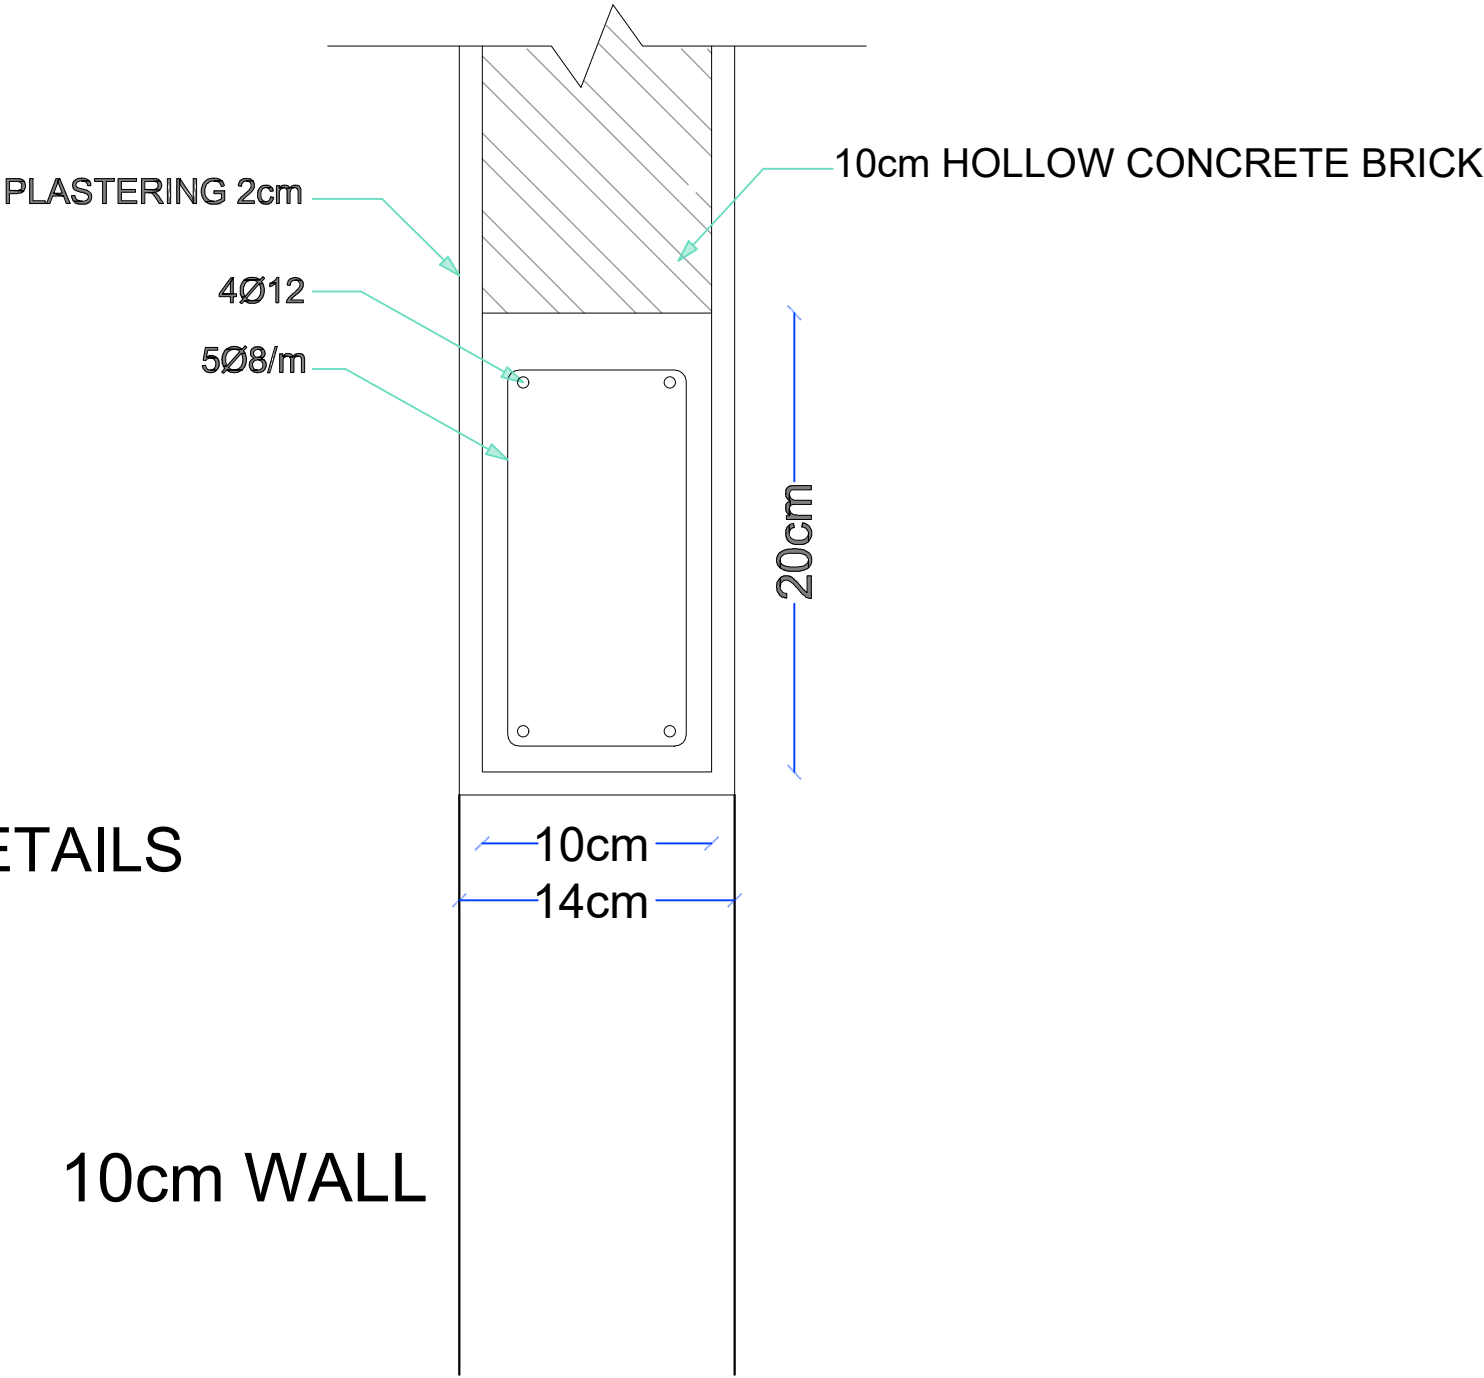

LEGEND





1- EXISTING EXTERNAL WALL


2- REINFORCED CONCRETE

3- CONCRETE BLOCK WALL

4- EXTERIOR PAVING

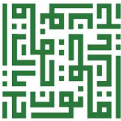NOTES

Rev.:	Date:	Description:	Approved:		
All information in this document is the property of PALESTINIAN CIVIL POLICE and cannot be copied anywhere but in this project without prior written consent of PALESTINIAN CIVIL POLICE.					
Partners:					
The Independent Commission For Human Rights (ICHR)		PALESTINIAN CIVIL POLICE			
					
Funded by:					
		Kingdom of Norway			
Design & Implementation:					
		QURIE ARCHITECTURE			
Project Name:					
Detention Centers Rehabilitation Project in the West Bank (Norwegian Grant)					
Title:					
Al-Ebidya DETENTION CENTER					
Drawings Title:					
Wall Detail (1)					
Project No.:	Phase:	Discipline:	Date:	Drawing No.:	
000000	01	A	8.2021	A04	
Drawn:	Checked:	Approved:	Size:	Scale:	Rev.:
			A3		

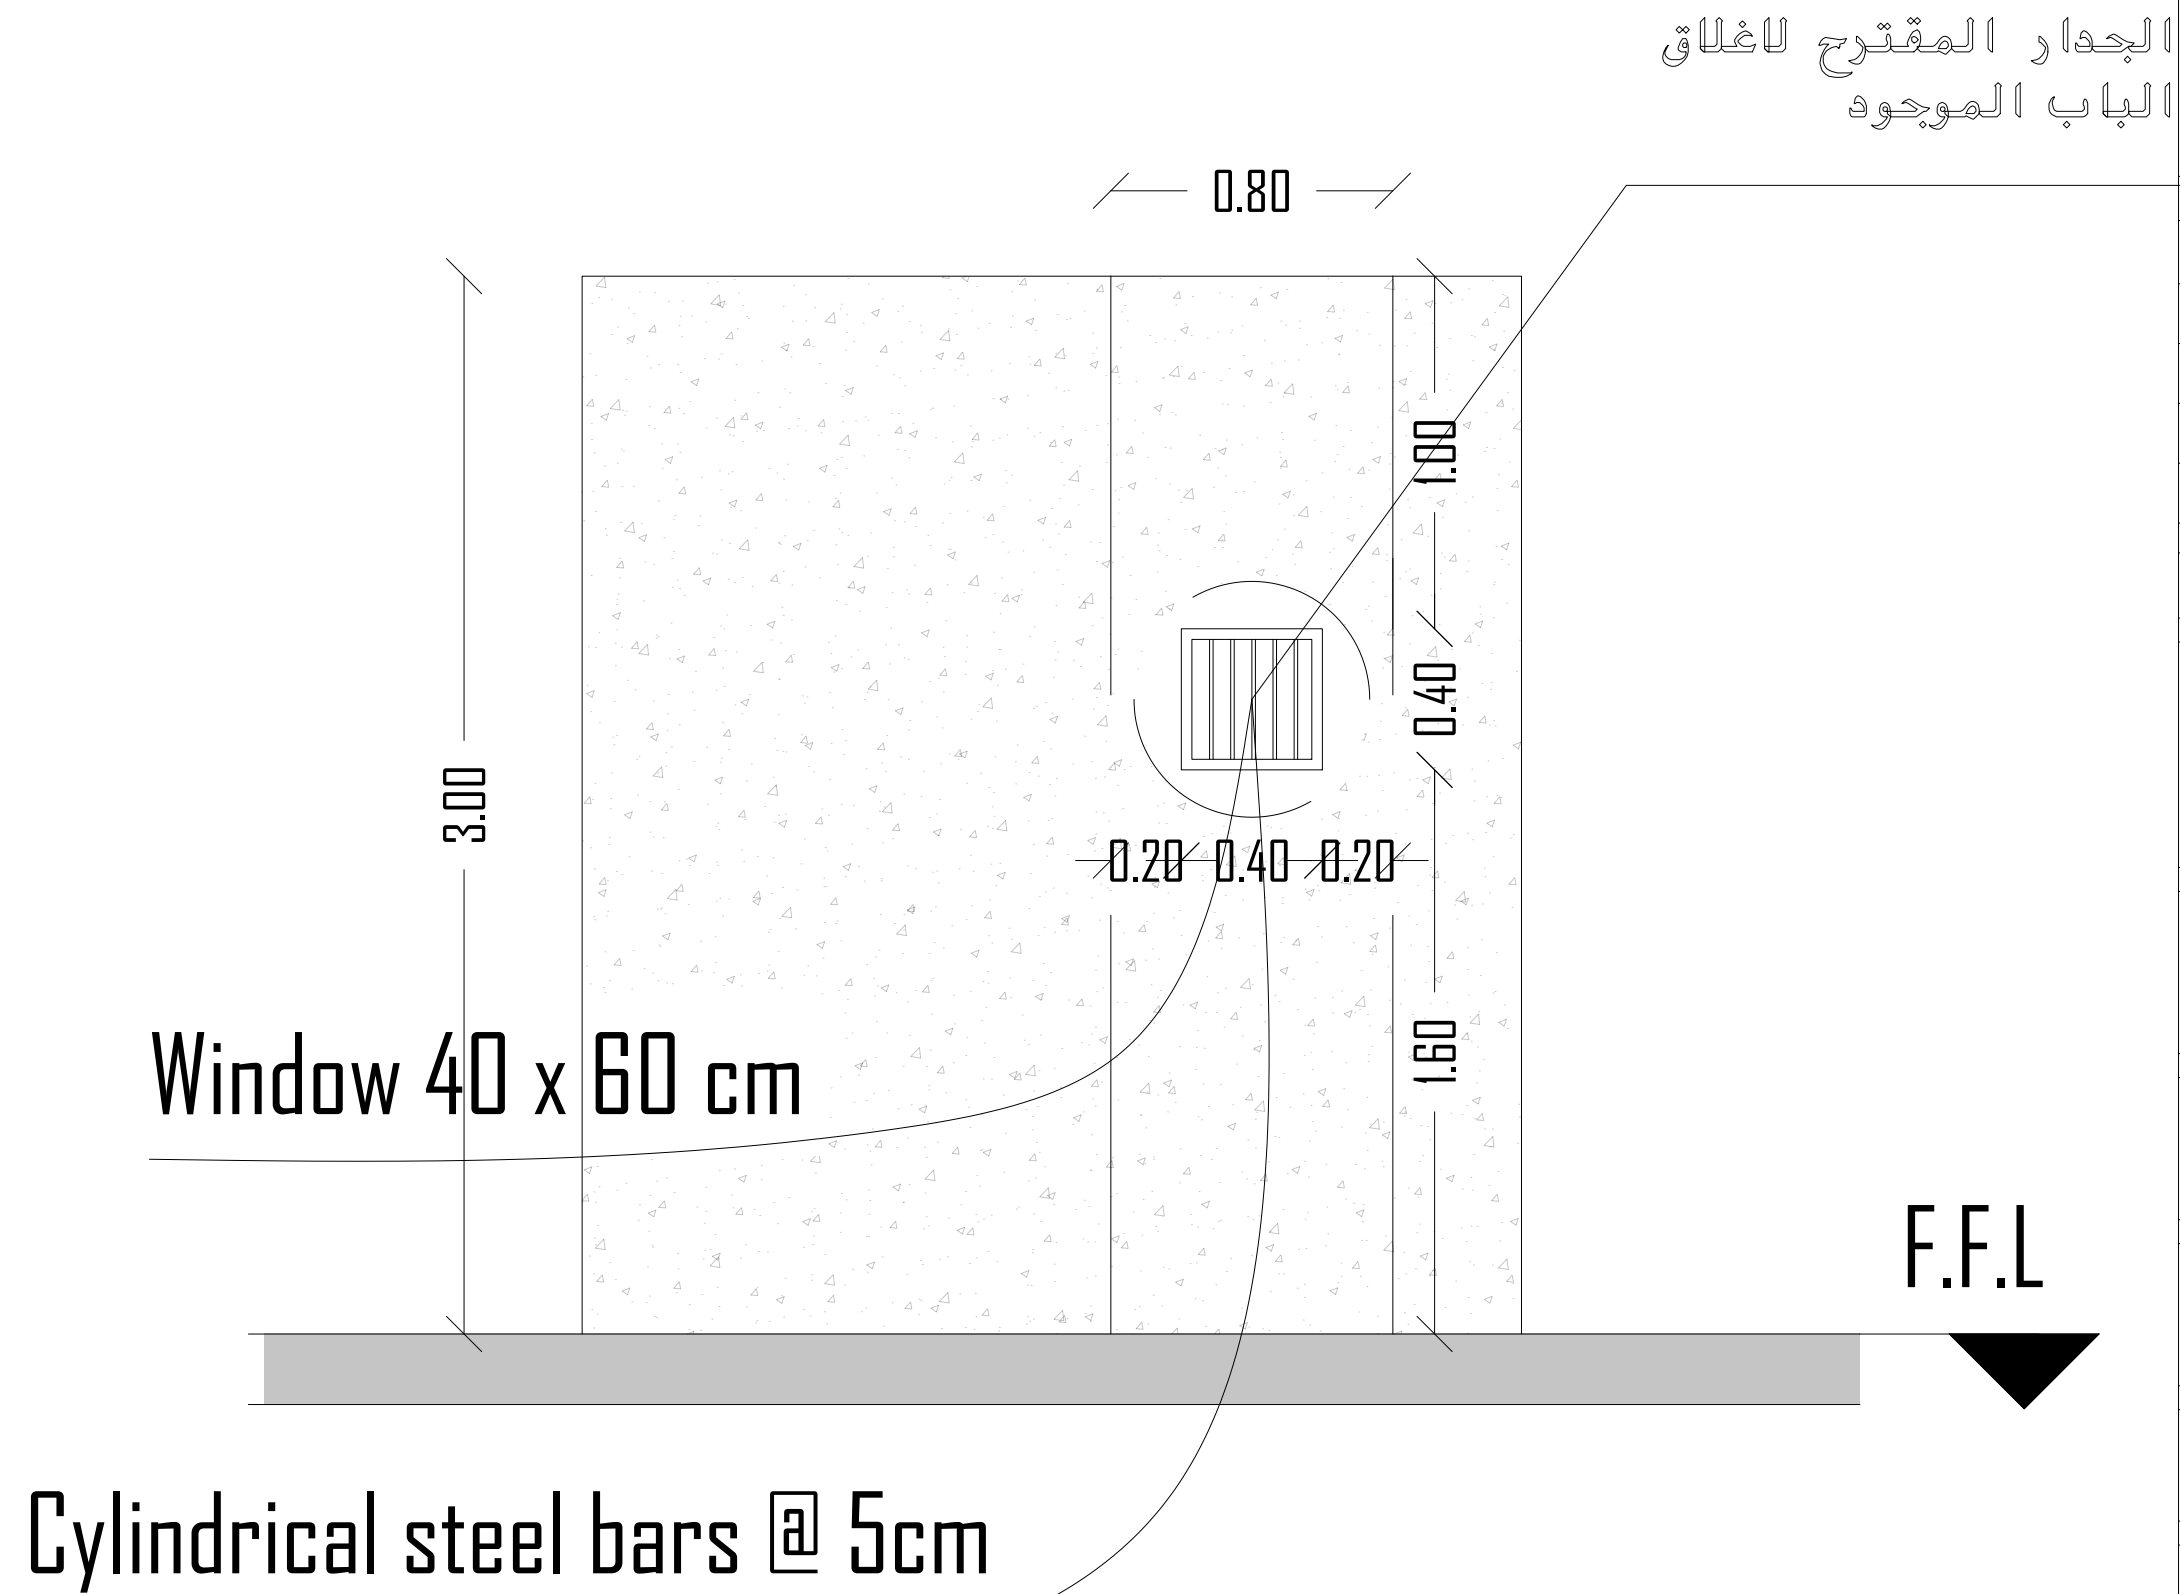

LEGEND

1- EXISTING EXTERNAL WALL

2- REINFORCED CONCRETE

3- CONCRETE BLOCK WALL

4- EXTERIOR PAVING

NOTES

Rev.:

Date:

Description:

Approved:


All information in this document is the property of PALESTINIAN CIVIL POLICE and cannot be copied anywhere but in this project without prior written consent of PALESTINIAN CIVIL POLICE.

Partners:


The Independent Commission For Human Rights (ICHR)

PALESTINIAN CIVIL POLICE

Funded by:

Kingdom of Norway

Design & Implementation:



QURIE

ARCHITECTURE

Project Name:

Detention Centers Rehabilitation Project in the West Bank (Norwegian Grant)

Title:

Al-Ebidya DETENTION CENTER

Drawings Title:

Wall Detail (2)

Project No.:

000000

Phase:

01

Discipline:

A

Date:

8.2021

Drawing No.:

A05

Drawn:

Checked:

Approved:

Size:

A3

Scale:

Rev.:

POLICE DETENTION CENTERS REHABILITATION PROJECT

CENTER NO (9):

Jericho Detention Center

LIST OF DRAWINGS

ARCHITECTURAL DRAWINGS

NO.	DRAWING TITLE	اسم اللوحة	الرقم
A00	LIST OF DRAWINGS	جدول الرسومات	A00
A01	AS BUILT PLAN	مخطط الوضع القائم	A01
A02	Proposed Edits Plan	مخطط الهدم والاضافة	A02
A03	Proposed Dimensional Plan	المخطط المقترح	A03
A04	Structural Opening Expansion Detail	تفاصيل جدران الطوب (1)	A04
A05	Section A-A	تفاصيل جدران الطوب (2)	A05

LEGEND

1- EXISTING EXTERNAL WALL

2- REINFORCED CONCRETE

3- CONCRETE BLOCK WALL

4- EXTERIOR PAVING

NOTES

Rev.:

Date:

Description:

Approved:

All information in this document is the property of PALESTINIAN CIVIL POLICE and cannot be copied anywhere but in this project without prior written consent of PALESTINIAN CIVIL POLICE.

Partners:

The Independent Commission For Human Rights (ICHR)

PALESTINIAN CIVIL POLICE

Funded by:

Kingdom of Norway

Design & Implementation:

QURIE ARCHITECTURE

Project Name:

Detention Centers Rehabilitation Project in the West Bank (Norwegian Grant)

Title:

Jericho Detention Center

Drawings Title:

List Of Drawings

Project No.:

Phase:

Discipline:

Date:

Drawing No.:

000000

01

A

8.2021

A00

Drawn:

Checked:


Approved:

Size:

Scale:

Rev.:

A3

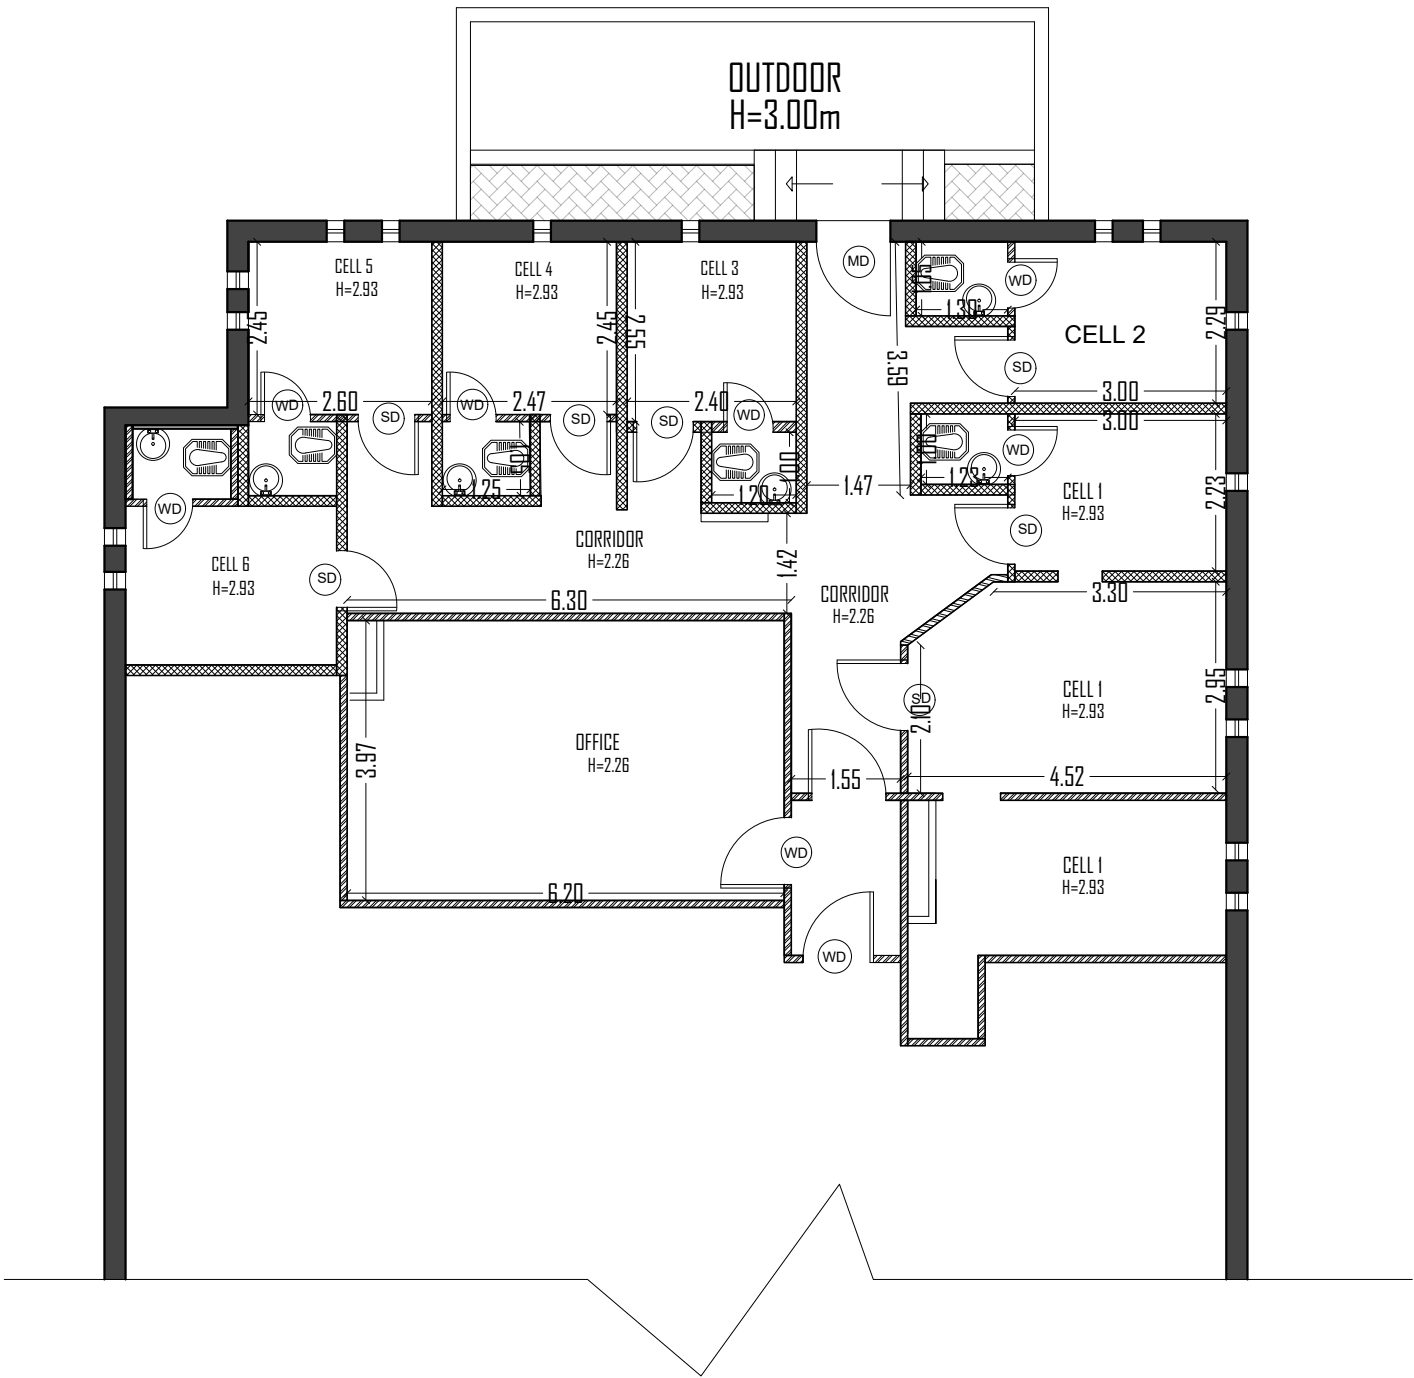

LEGEND

1- EXISTING EXTERNAL WALL	
2- REINFORCED CONCRETE	
3- CONCRETE BLOCK WALL	
4- EXTERIOR PAVING	

NOTES

Rev.:	Date:	Description:	Approved:
-------	-------	--------------	-----------

All information in this document is the property of PALESTINIAN CIVIL POLICE and cannot be copied anywhere but in this project without prior written consent of PALESTINIAN CIVIL POLICE.

Partners:	
The Independent Commission For Human Rights (ICHR)	PALESTINIAN CIVIL POLICE

Funded by:	
	Kingdom of Norway

Design & Implementation:	
	QURIE ARCHITECTURE

Project Name:
Detention Centers Rehabilitation Project in the West Bank (Norwegian Grant)

Title:
Jericho Detention Center

Drawings Title:
As Built Plan

Project No.:	Phase:	Discipline:	Date:	Drawing No.:
000000	01	A	8.2021	A01
Drawn:	Checked:	Approved:	Size:	Scale:
			A3	

صيانة مواسير كامل الحمامات عدد 6
ازالة القفصارة القائمة
70 متر مربع
واعادة قفصارة الحمامات

اعمال دهان لكافة جدران و أسقف النظارة

عمل مدة باطون للساحة الخارجية
15 متر مربع

صيانة الحمام

ازالة النيجارا وتركيب وحدة جديدة

زيادة ارتفاع فتحة باب

هدم قاطع طوب

توسيع الشبابيك و تأهيلهم الى ٥٠ . ٤٠

ازالة باب الخشب القائم
وتركيب باب حديد

LEGEND

1- EXISTING EXTERNAL WALL

2- REINFORCED CONCRETE

3- CONCRETE BLOCK WALL

4- EXTERIOR PAVING

NOTES

Rev.:

Date:

Description:

Approved:


All information in this document is the property of PALESTINIAN CIVIL POLICE and cannot be copied anywhere but in this project without prior written consent of PALESTINIAN CIVIL POLICE.

Partners:


The Independent Commission For Human Rights (ICHR)

PALESTINIAN CIVIL POLICE

Funded by:

Kingdom of Norway

Design & Implementation:



QURIE

ARCHITECTURE

Project Name:

Detention Centers Rehabilitation Project in the West Bank (Norwegian Grant)

Title:

Jericho Detention Center

Drawings Title:

Proposed Edits Plan

Project No.:

000000

Phase:

01

Discipline:

A

Date:

8.2021

Drawing No.:

A02

Drawn:

Checked:


Approved:

Size:

A3

Scale:

Rev.:

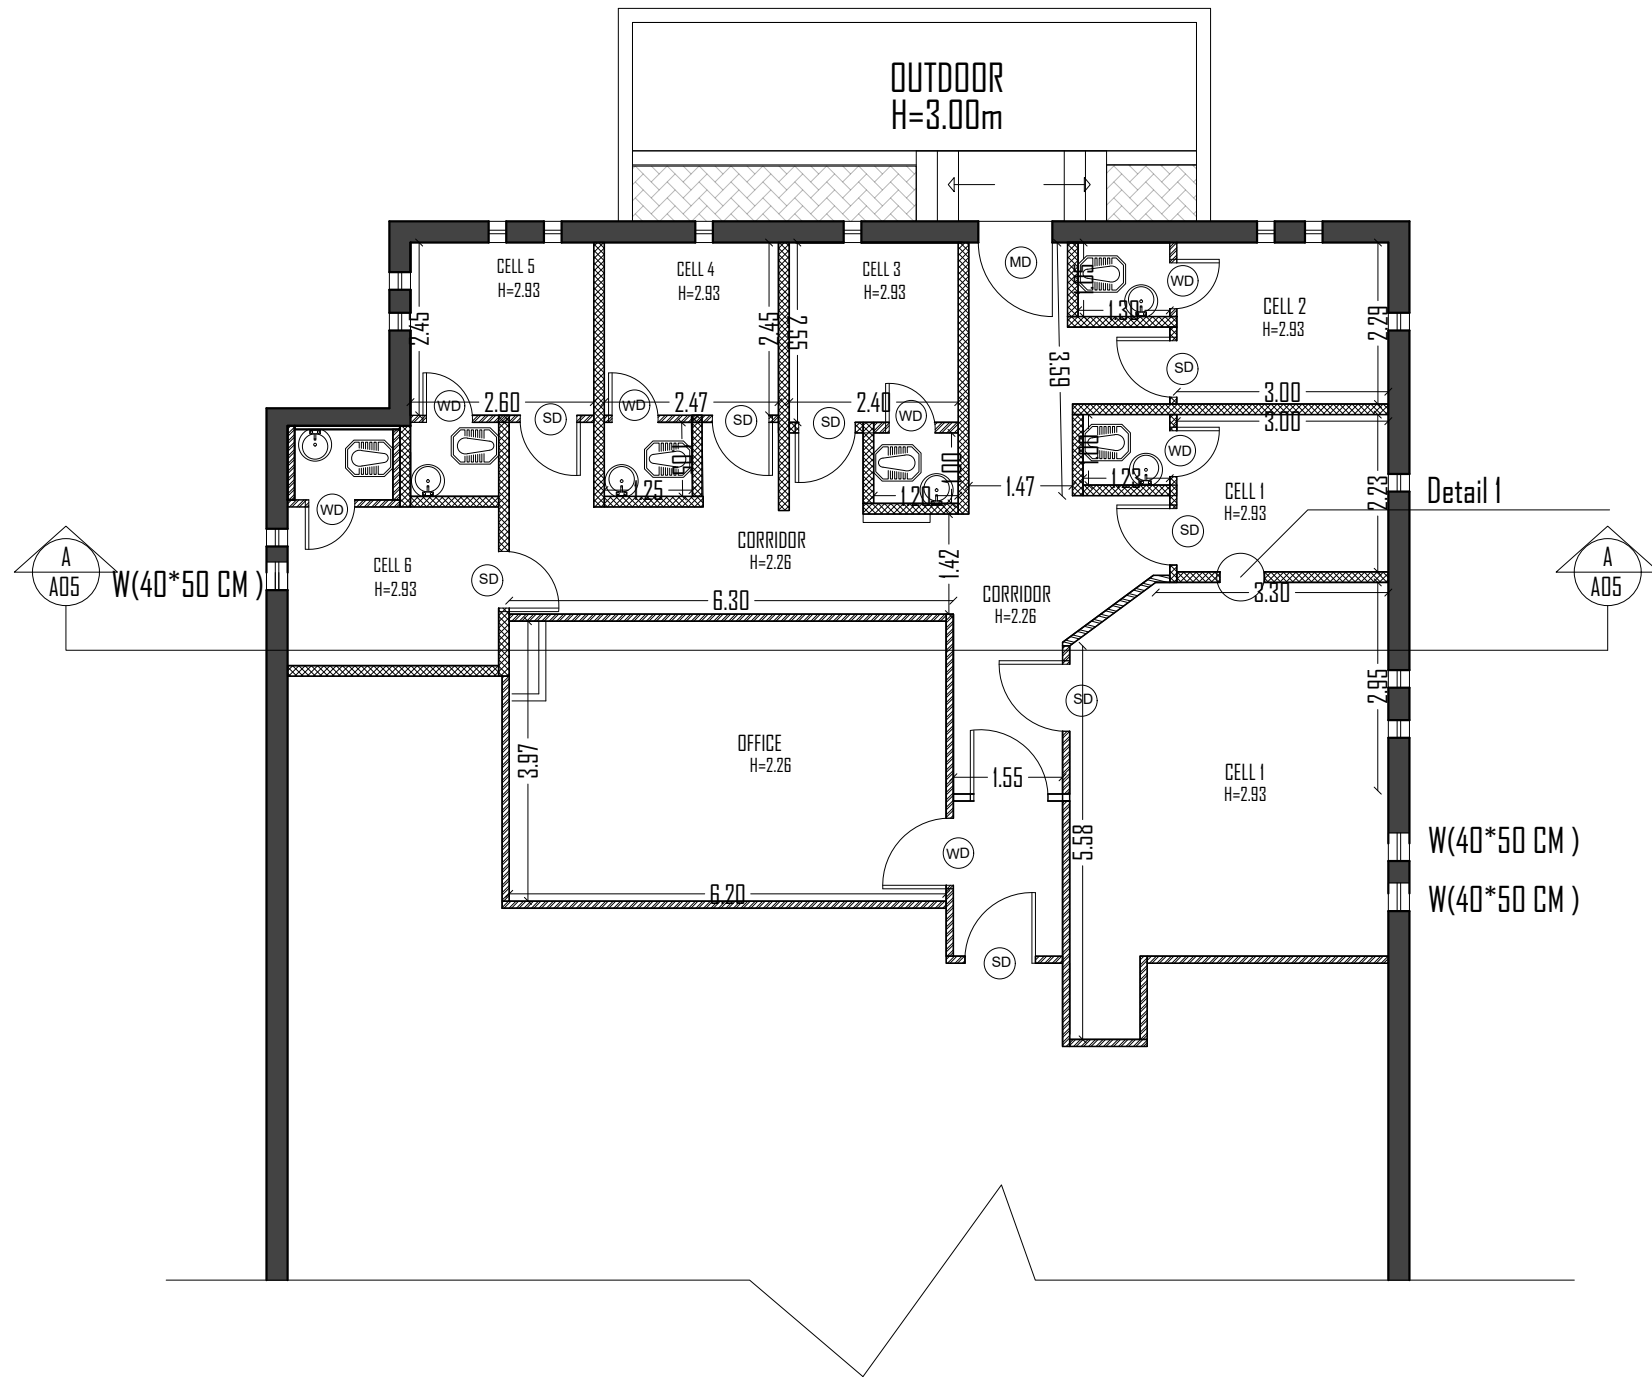

LEGEND

1- EXISTING EXTERNAL WALL

2- REINFORCED CONCRETE

3- CONCRETE BLOCK WALL

4- EXTERIOR PAVING

NOTES

Rev.:Date:Description:Approved:


All information in this document is the property of PALESTINIAN CIVIL POLICE and cannot be copied anywhere but in this project without prior written consent of PALESTINIAN CIVIL POLICE.

Partners:


The Independent Commission For Human Rights (ICHR)

PALESTINIAN CIVIL POLICE

Funded by:

Kingdom of Norway

Design & Implementation:



QURIE
ARCHITECTURE

Project Name:

Detention Centers Rehabilitation Project in the West Bank (Norwegian Grant)

Title:

Jericho Detention Center

Drawings Title:


Proposed Dimensional Plan

Project No.:Phase:Discipline:Date:Drawing No.:

0000001A8.2021A03

Drawn:Checked:Approved:Size:Scale:Rev.:

A3

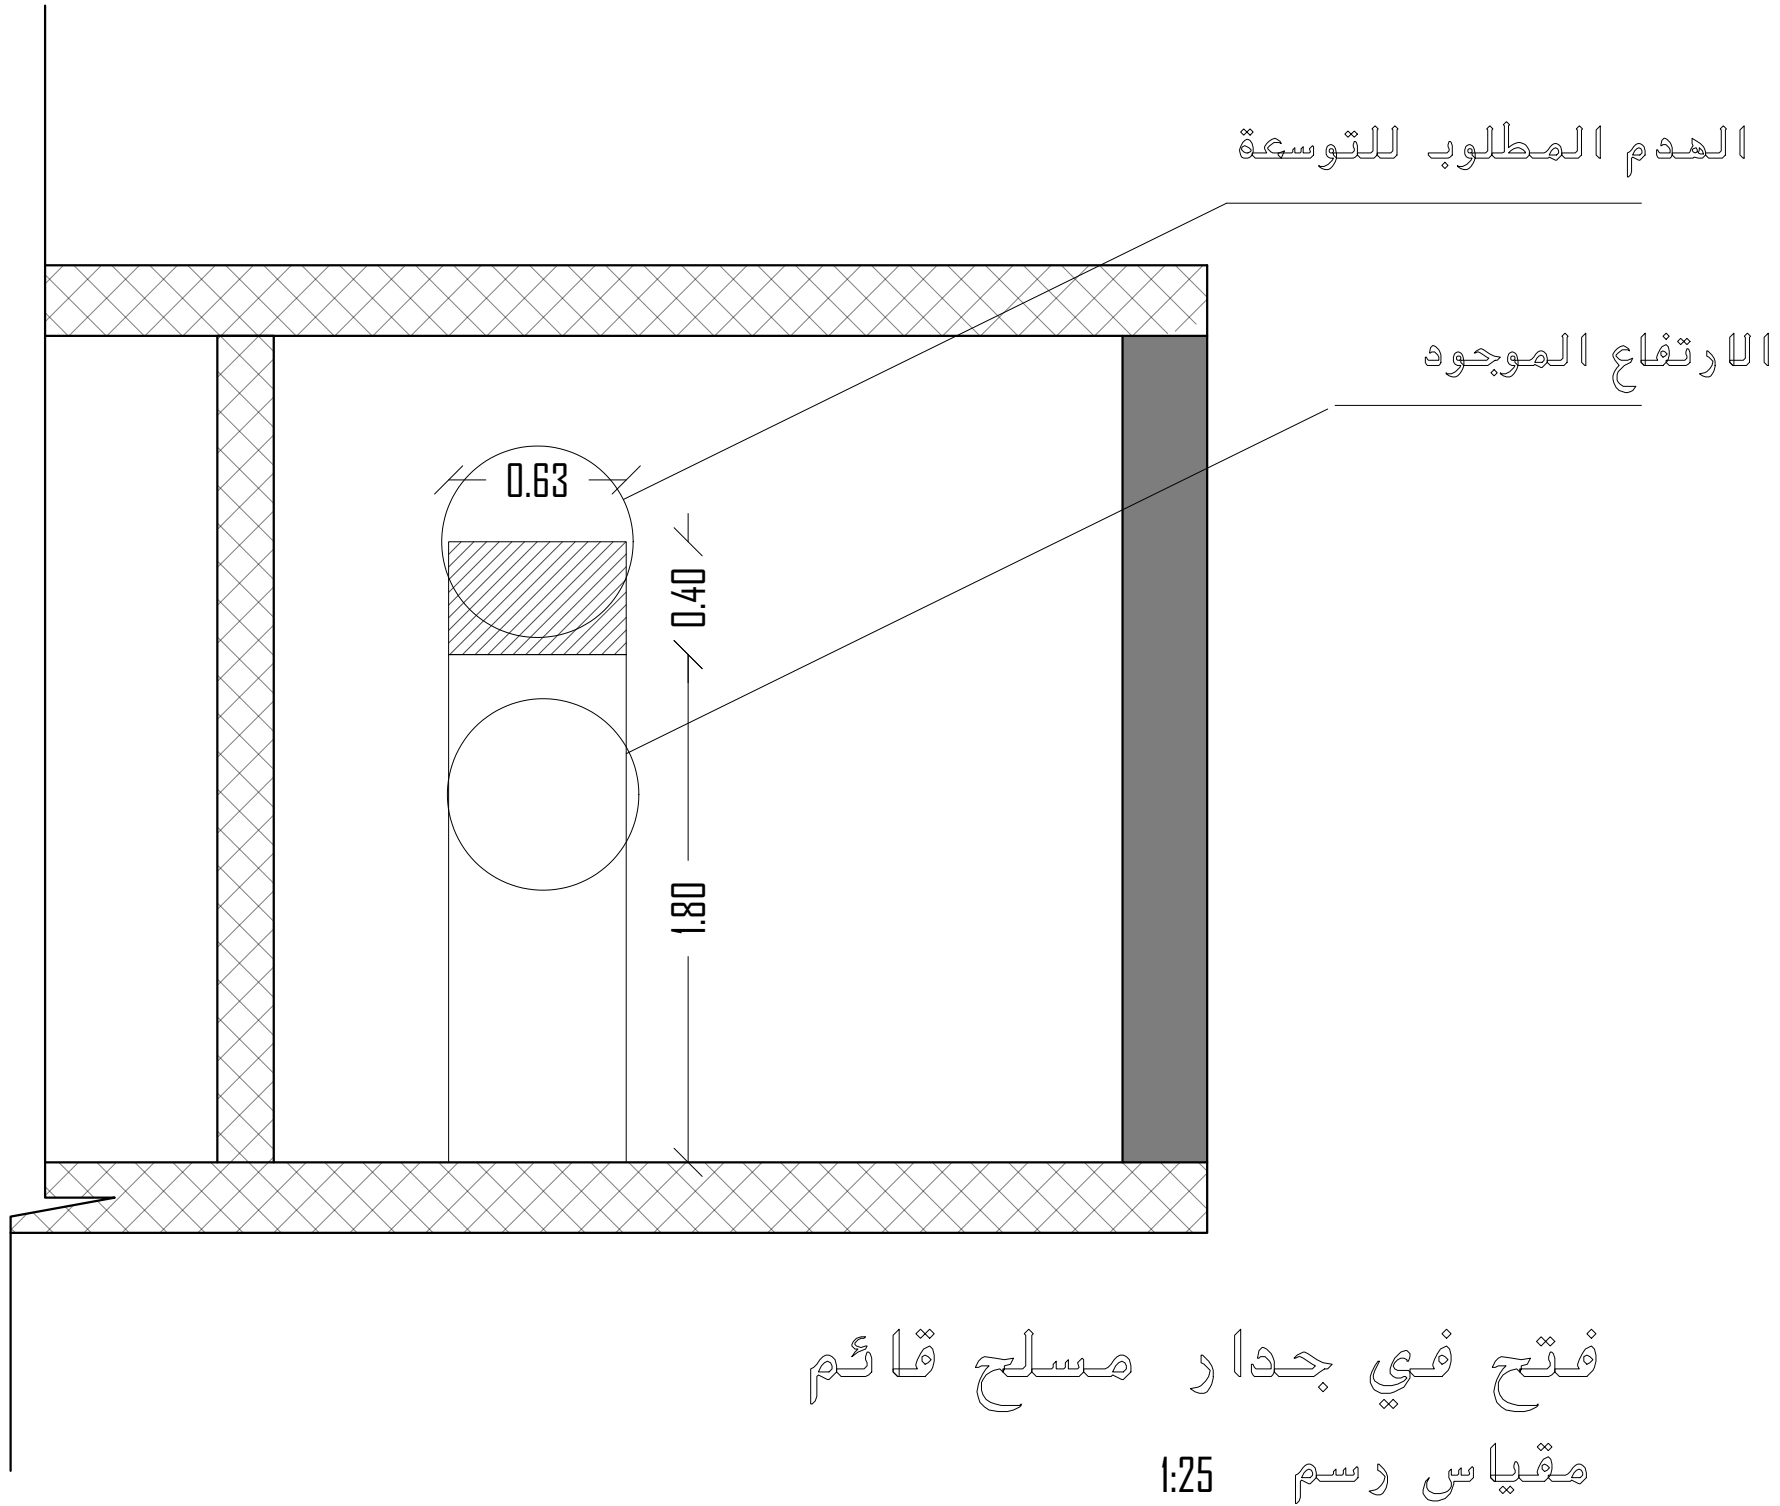


LEGEND

1- EXISTING EXTERNAL WALL	
2- REINFORCED CONCRETE	
3- CONCRETE BLOCK WALL	
4- EXTERIOR PAVING	


NOTES

Rev.:	Date:	Description:	Approved:		
All information in this document is the property of PALESTINIAN CIVIL POLICE and cannot be copied anywhere but in this project without prior written consent of PALESTINIAN CIVIL POLICE.					
Partners:					
The Independent Commission For Human Rights (ICHR)		PALESTINIAN CIVIL POLICE			
Funded by:					
		Kingdom of Norway			
Design & Implementation:					
		QURIE ARCHITECTURE			
Project Name:					
Detention Centers Rehabilitation Project in the West Bank (Norwegian Grant)					
Title:					
Jericho Detention Center					
Drawings Title:					
Proposed Edits Plan					
Project No.:	Phase:	Discipline:	Date:	Drawing No.:	
00000	01	A	8.2021	A04	
Drawn:	Checked:	Approved:	Size:	Scale:	Rev.:
			A3	1:25	

Plan - Section Guide
Scale 1:200

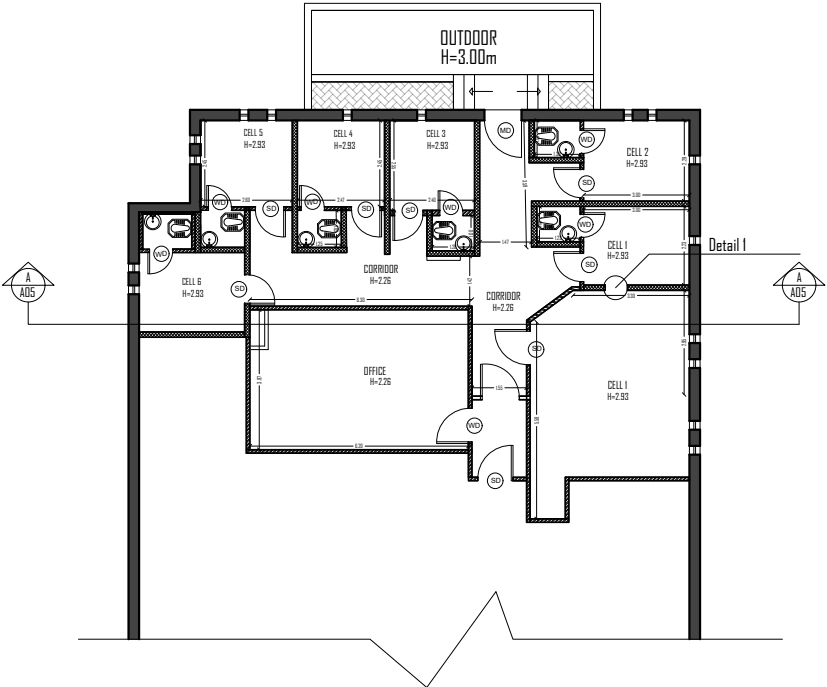

Section A-A
Scale 1:100

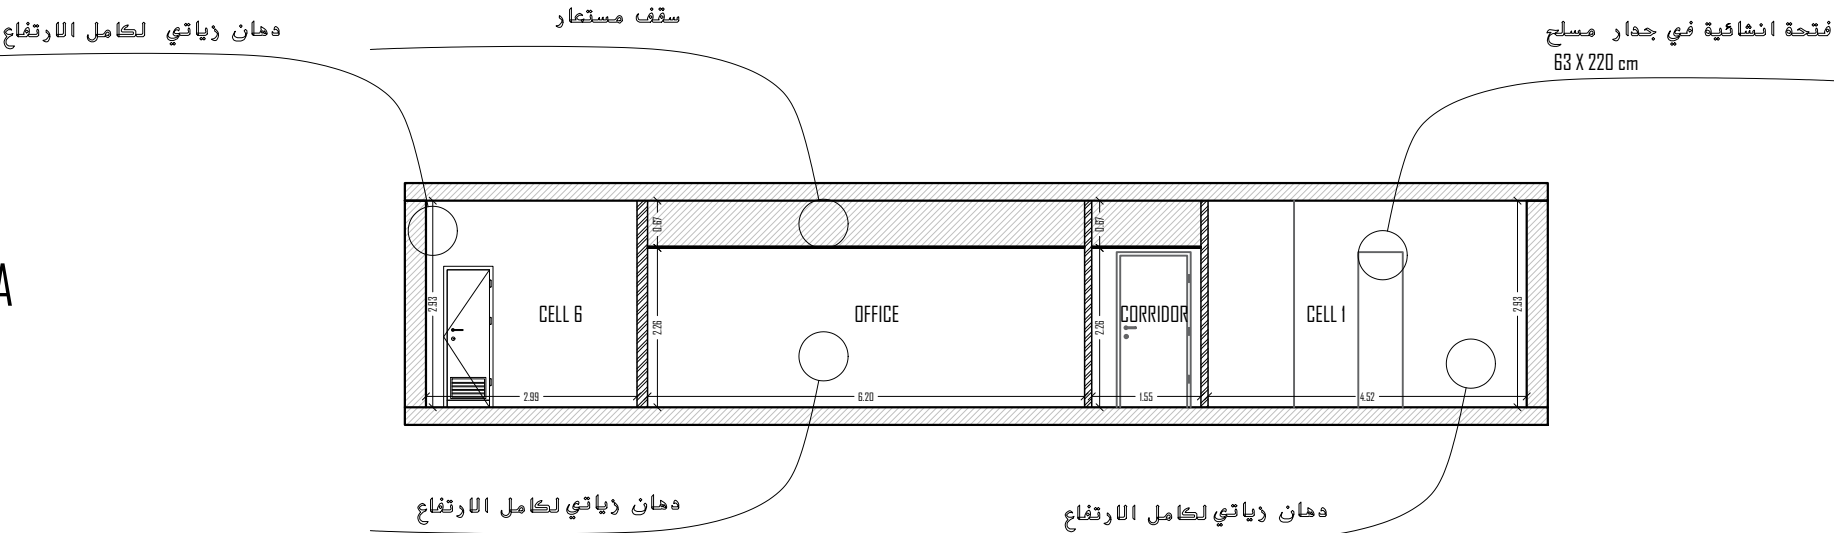

LEGEND

1- EXISTING EXTERNAL WALL

2- REINFORCED CONCRETE

3- CONCRETE BLOCK WALL

4- EXTERIOR PAVING

NOTES

Rev.:Date:Description:Approved:

All information in this document is the property of PALESTINIAN CIVIL POLICE and cannot be copied anywhere but in this project without prior written consent of PALESTINIAN CIVIL POLICE.

Partners:

The Independent Commission For Human Rights (ICHR)

PALESTINIAN CIVIL POLICE

Funded by:

Kingdom of Norway

Design & Implementation:

QURIE
ARCHITECTURE

Project Name:

Detention Centers Rehabilitation Project in the West Bank (Norwegian Grant)

Title:

Jericho Detention Center

Drawings Title:

Section A-A

Project No.:Phase:Discipline:Date:Drawing No.:

0000001A8.2021A05

Drawn:Checked:Approved:Size:Scale:Rev.:

A3

POLICE DETENTION CENTERS REHABILITATION PROJECT


CENTER NO (10):

Ramallah And Al-Bireh Detention Centers.

LIST OF DRAWINGS

[illegible]

LEGEND

1- EXISTING EXTERNAL WALL	
2- REINFORCED CONCRETE	
3- CONCRETE BLOCK WALL	
4- EXTERIOR PAVING	

NOTES

Rev.:	Date:	Description:	App:
-------	-------	--------------	------

All information in this document is the property of PALESTINIAN CIVIL POLICE and cannot be copied anywhere but in this project without prior written consent of PALESTINIAN CIVIL POLICE.

Partners:

The Independent Commission For Human Rights (ICHR)



PALESTINIAN CIVIL POLICE



unded by



Kingdom of Norway

Design & Implementation



Q U R I E

ARCHITECTURE

Project Name

Detention Centers Rehabilitation Project in the West Bank (Norwegian Grant)


title:

Ramallah And Al-Bireh Detention Centers.

Drawings Title:

List Of Drawings

Project No.:		Phase:	Discipline:	Date:	Drawing No.						
000000		01	A	8.2021	A000						
Drawn:	Checked:	Approved:	Size:	Scale:	Rev.:						
			A3		<table><tr><td></td><td></td><td></td></tr><tr><td></td><td></td><td></td></tr></table>						

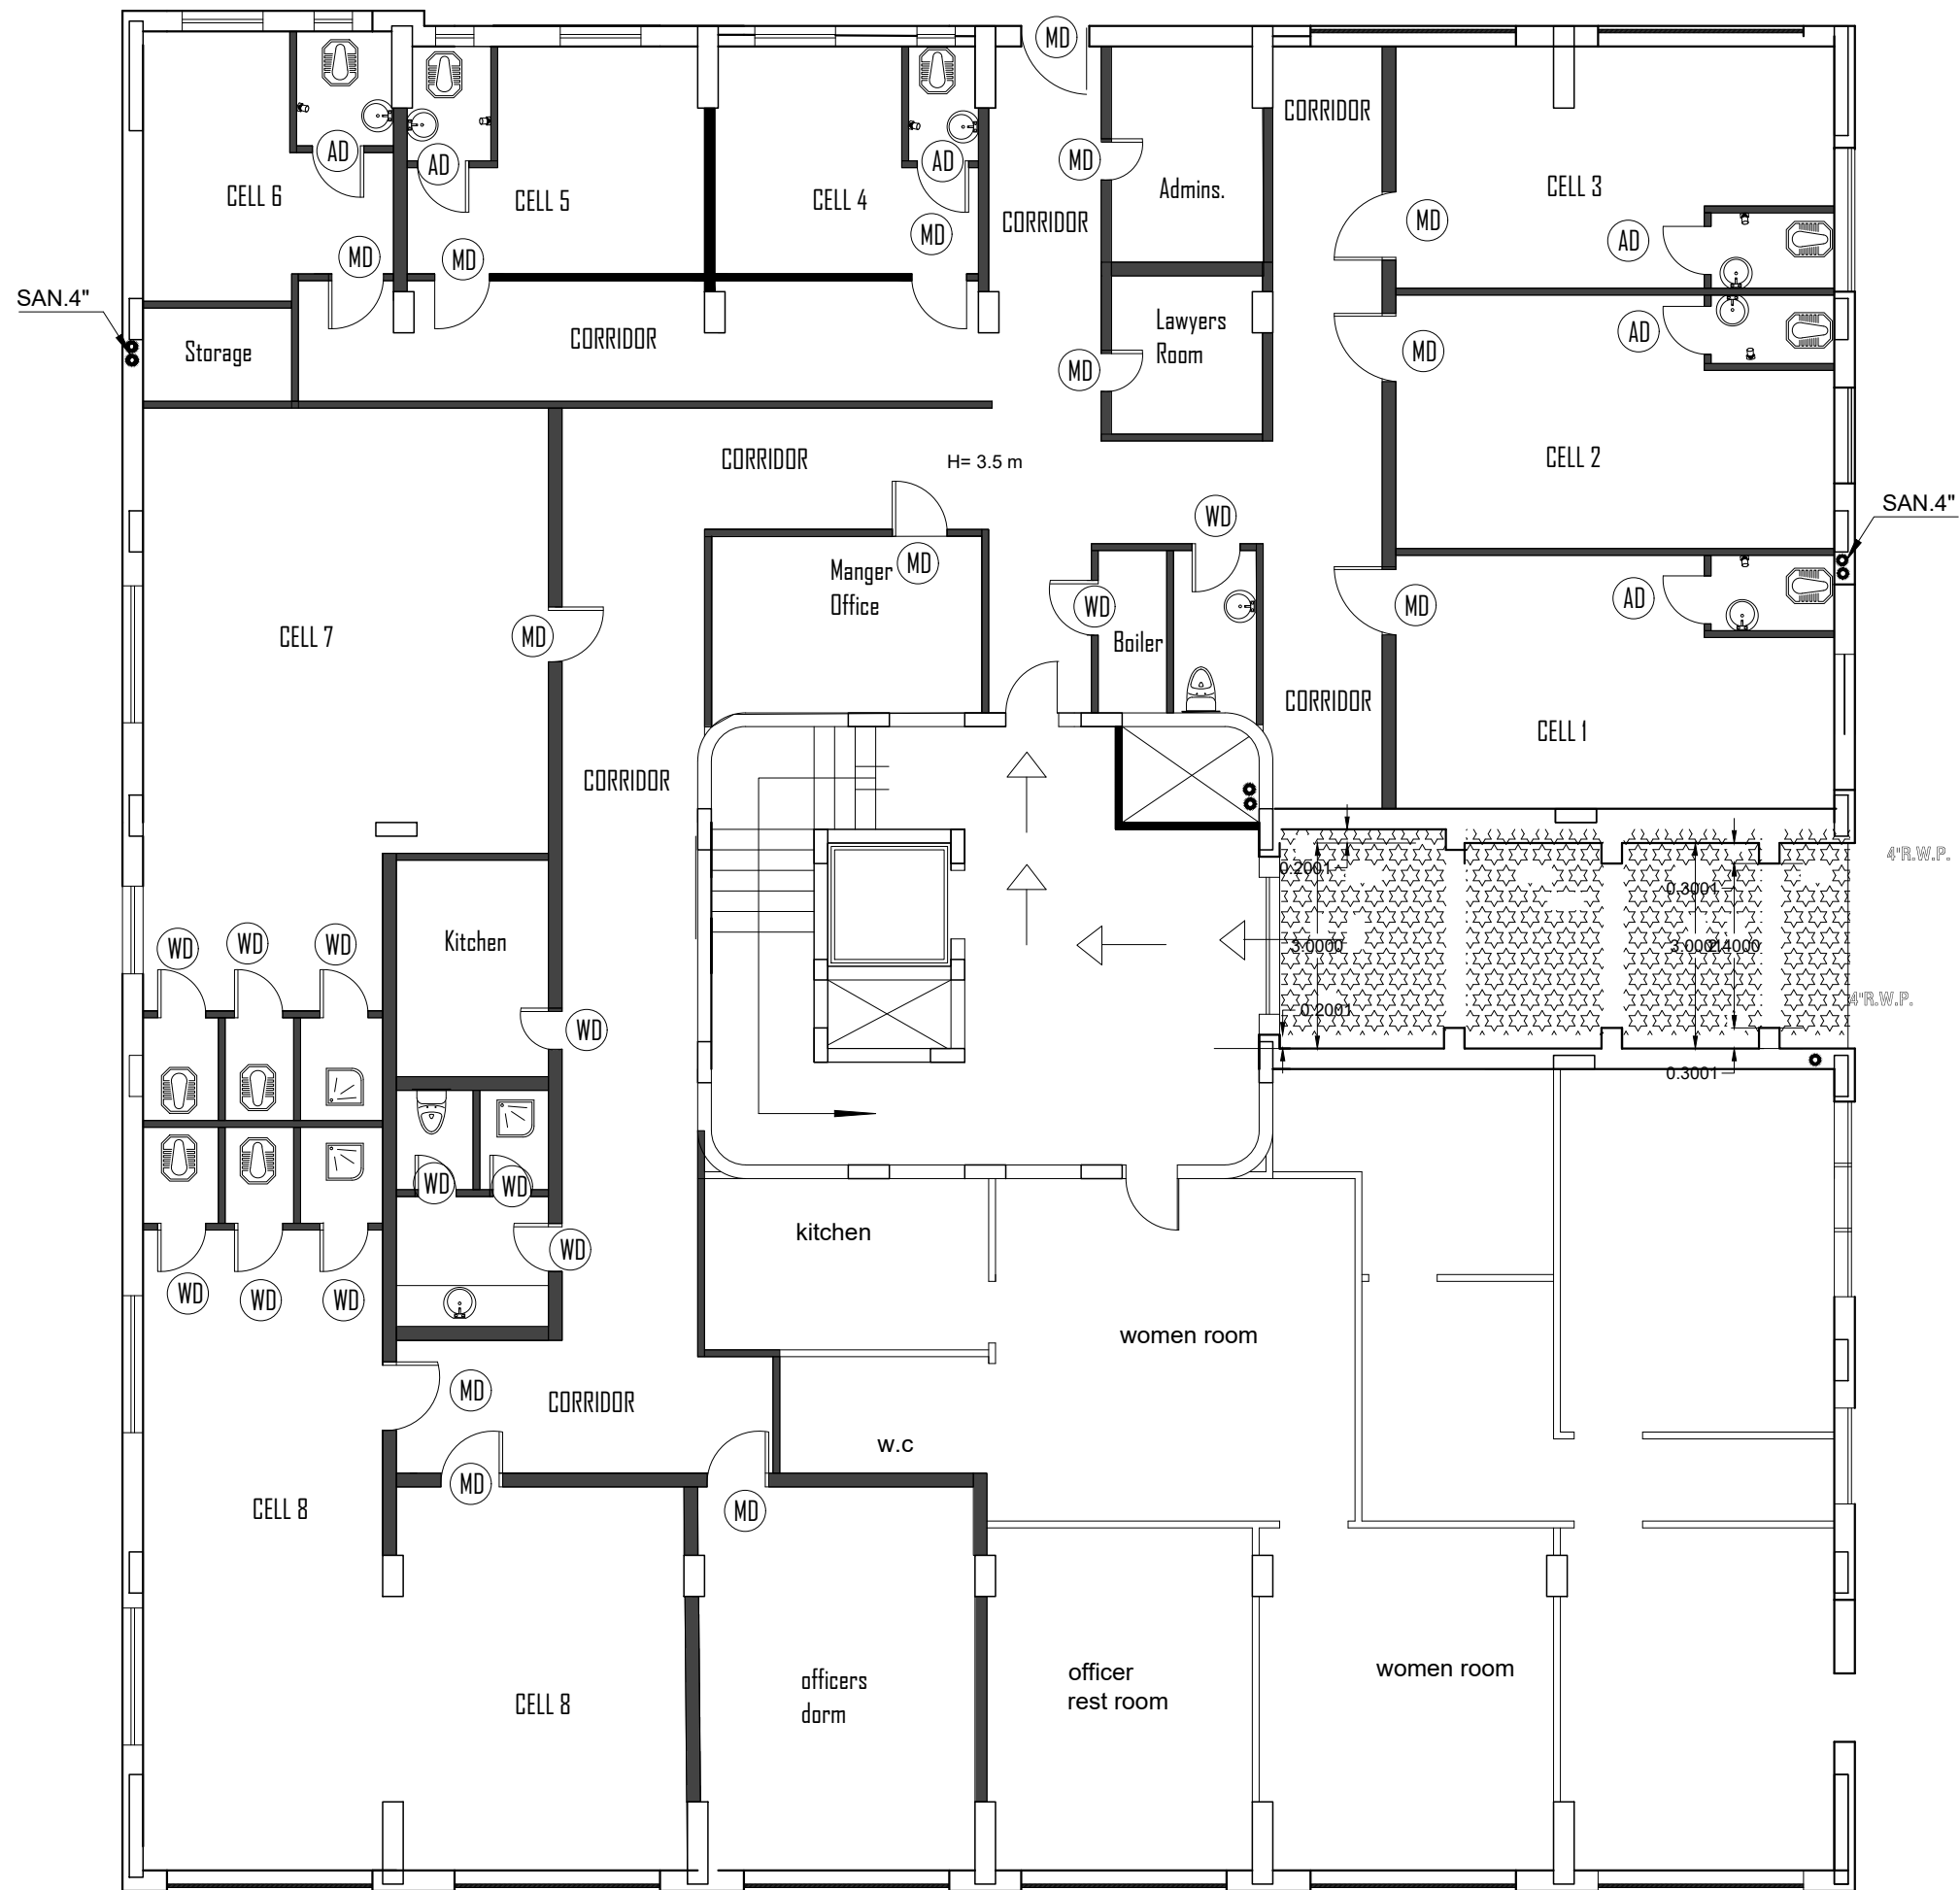


LEGEND

1- EXISTING EXTERNAL WALL	
2- REINFORCED CONCRETE	
3- CONCRETE BLOCK WALL	
4- EXTERIOR PAVING	

NOTES

Rev.:	Date:	Description:	Approved:	
All information in this document is the property of PALESTINIAN CIVIL POLICE and cannot be copied anywhere but in this project without prior written consent of PALESTINIAN CIVIL POLICE.				
Partners:				
The Independent Commission For Human Rights (ICHR)		PALESTINIAN CIVIL POLICE		
Funded by:				
		Kingdom of Norway		
Design & Implementation:				
		QURIE ARCHITECTURE		
Project Name:				
Detention Centers Rehabilitation Project in the West Bank (Norwegian Grant)				
Title:				
Ramallah And Al-Bireh Detention Centers.				
Drawings Title:				
As Built Plan				
Project No.:	Phase:	Discipline:	Date:	Drawing No.:
00000	01	A	8.2021	A00
Drawn:	Checked:	Approved:	Size:	Scale:
			A3	

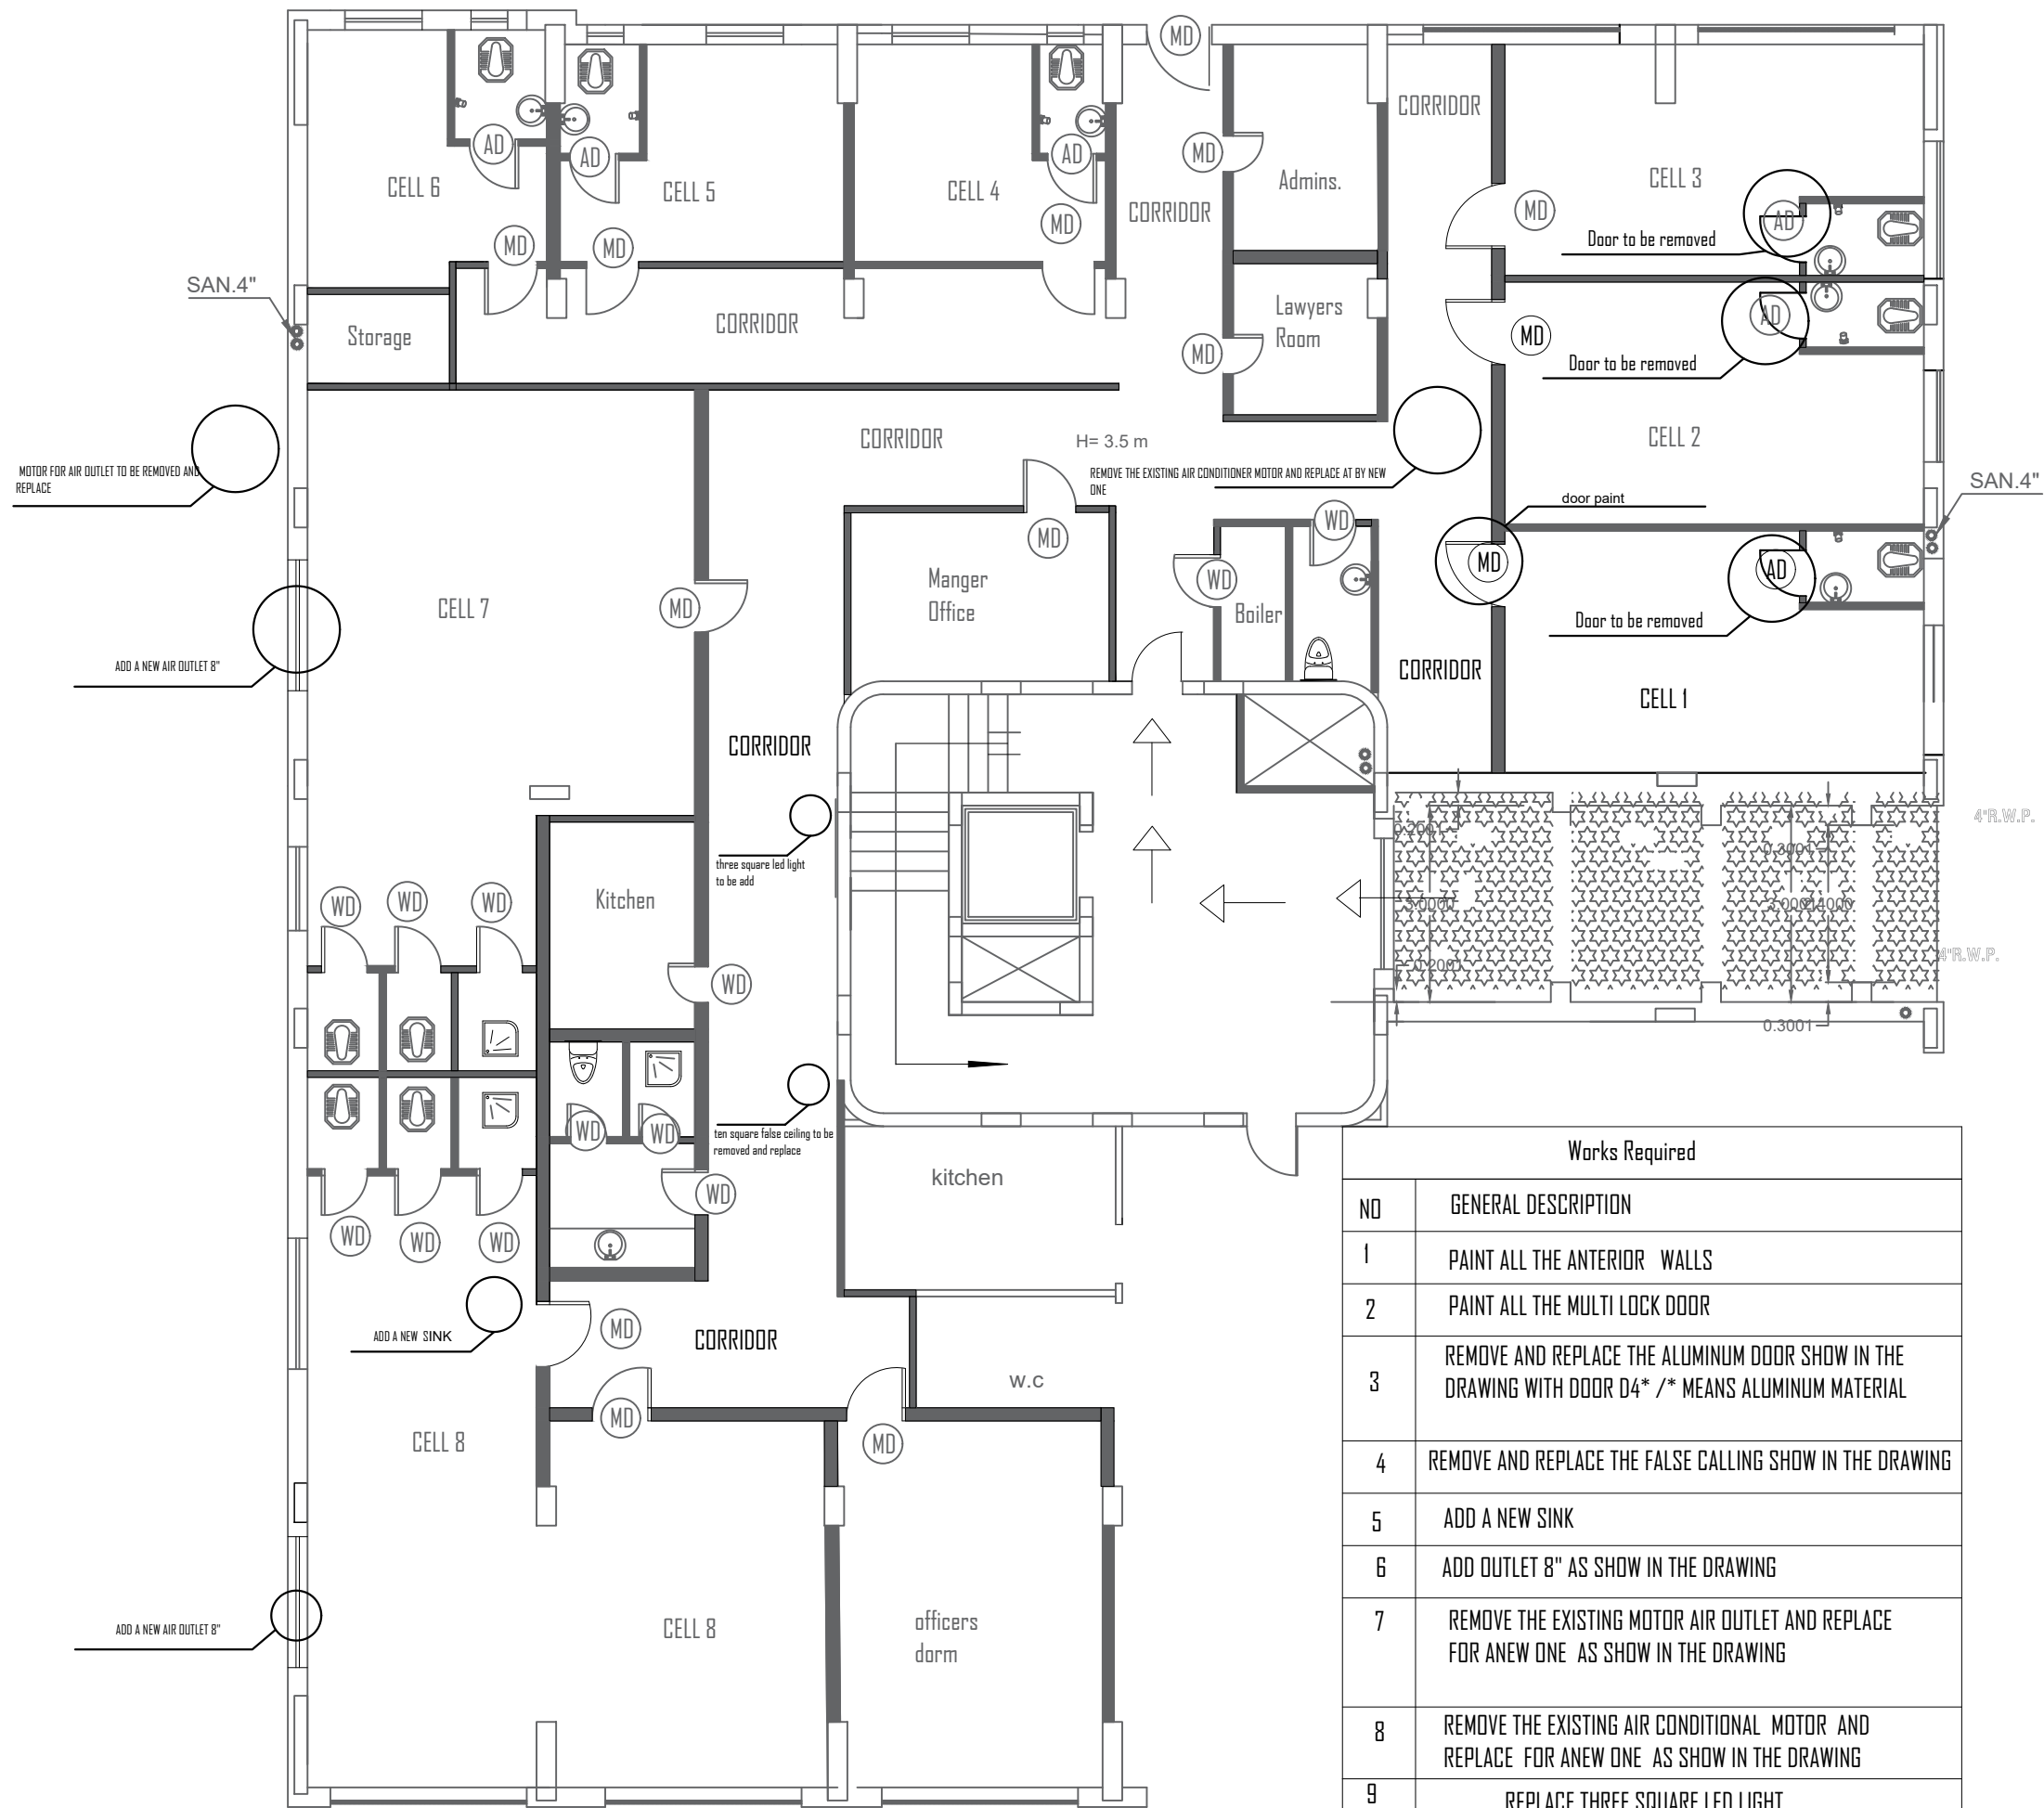

LEGEND

- 1- EXISTING EXTERNAL WALL
- 2- REINFORCED CONCRETE
- 3- CONCRETE BLOCK WALL
- 4- EXTERIOR PAVING

NOTES

	*	All MD doors to be paint	

Rev.: Date: Description: Approved:

All information in this document is the property of PALESTINIAN CIVIL POLICE and cannot be copied anywhere but in this project without prior written consent of PALESTINIAN CIVIL POLICE.

Partners:

The Independent Commission For Human Rights (ICHR)

PALESTINIAN CIVIL POLICE



Funded by:



Kingdom of Norway

Design & Implementation:



QURIE
ARCHITECTURE

Project Name:

Detention Centers Rehabilitation Project in the West Bank (Norwegian Grant)



Title:

Ramallah And Al-Bireh Detention Centers.


Drawings Title:

Addition/ Demolition Plan

Project No.:	Phase:	Discipline:	Date:	Drawing No.:
000000	01	A	8.2021	A00
Drawn:	Checked:	Approved:	Size:	Scale:
			A3	

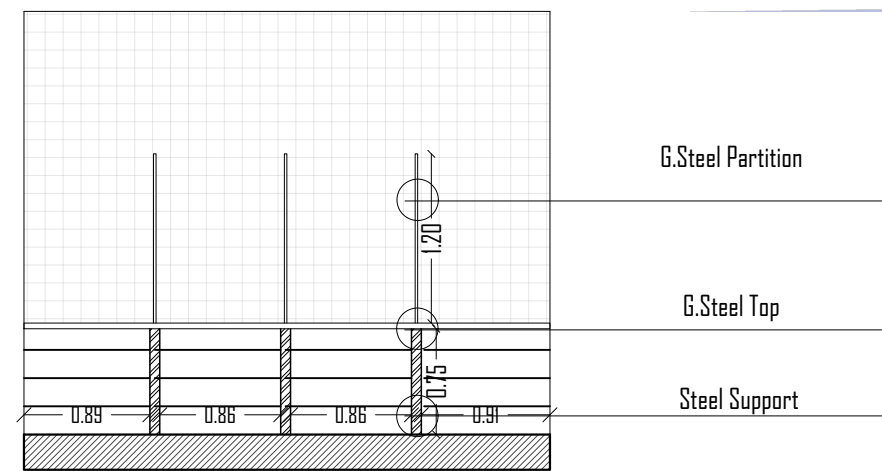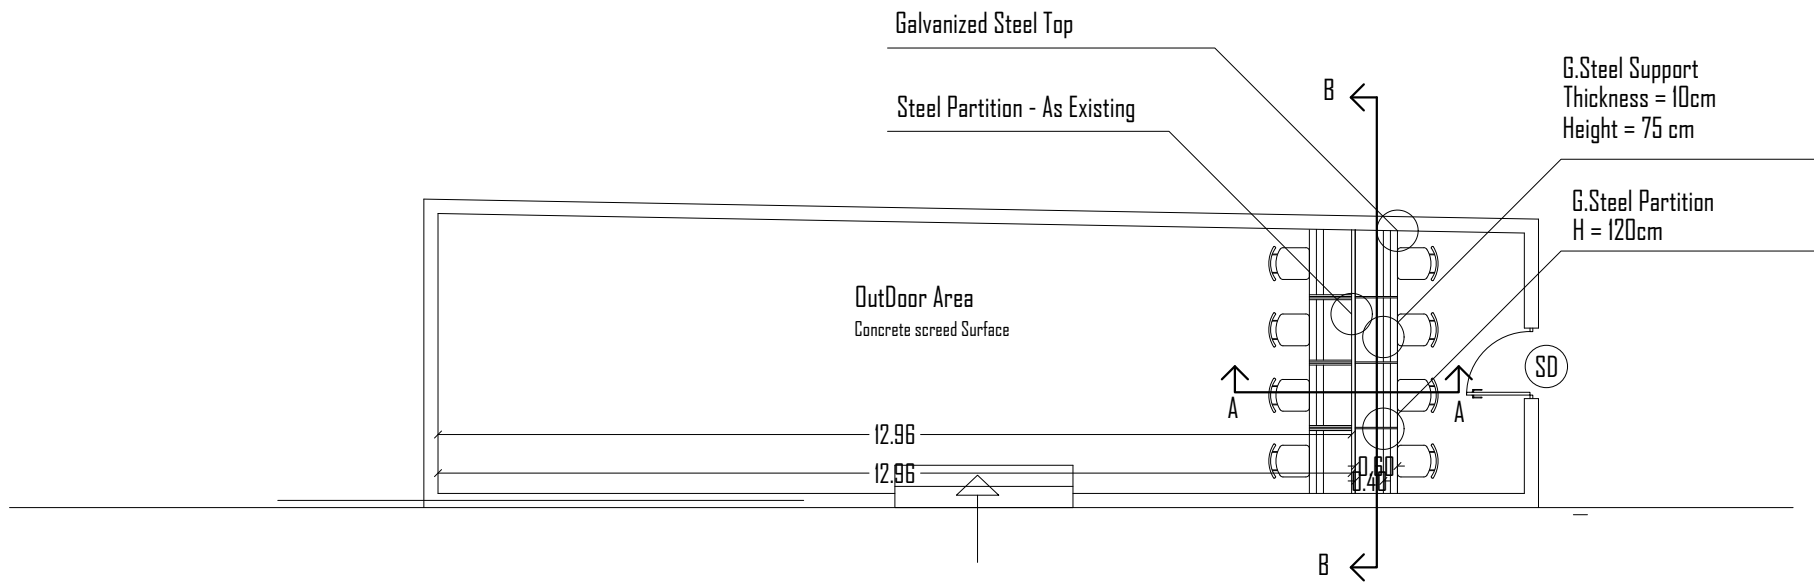

Section B-B
Scale 1:50

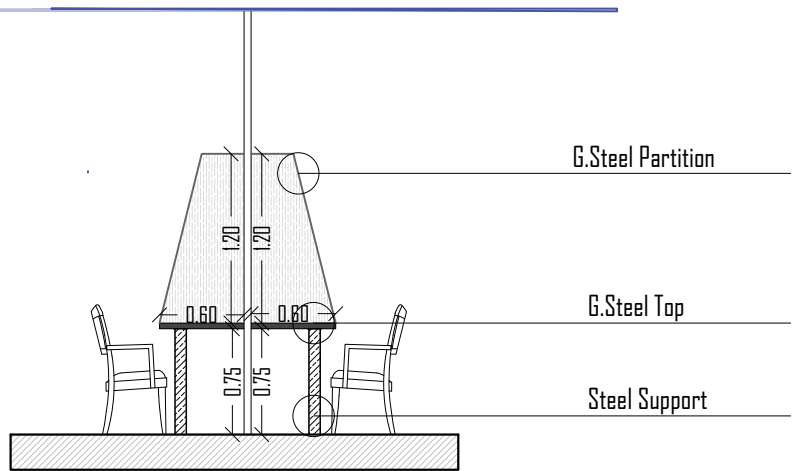

Section A-A
Scale 1:50

LEGEND

- 1- EXISTING EXTERNAL WALL
- 2- REINFORCED CONCRETE
- 3- CONCRETE BLOCK WALL
- 4- EXTERIOR PAVING

NOTES


Rev.: Date: Description: Approved:

All information in this document is the property of PALESTINIAN CIVIL POLICE and cannot be copied anywhere but in this project without prior written consent of PALESTINIAN CIVIL POLICE.

Partners:

The Independent Commission
For Human Rights (ICHR)

PALESTINIAN CIVIL POLICE

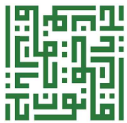

Funded by:



Kingdom of Norway

Design & Implementation:



QURIE
ARCHITECTURE

Project Name:

Detention Centers Rehabilitation
Project in the West Bank
(Norwegian Grant)

Title:

Ramallah And Al-Bireh Detention Centers.

Drawings Title:

Visitors Room Details

Project No.:	Phase:	Discipline:	Date:	Drawing No.:
000000	01	A	8.2021	A03
Drawn:	Checked:	Approved:	Size:	Scale:
			A3	

POLICE DETENTION CENTERS REHABILITATION PROJECT

CENTER NO (11):

JERUSALEM SUBURBS DETENTION CENTER

LIST OF DRAWINGS

ARCHITECTURAL DRAWINGS

NO.	DRAWING TITLE
A00	List Of Drawings
A01	Existing Plan
A02	Demolition Plan
A03	To Be Built Walls Plan
A04	Proposed Furniture Plan
A05	Proposed Dimensional Plan

LEGEND

1- EXISTING EXTERNAL WALL

2- REINFORCED CONCRETE

3- CONCRETE BLOCK WALL

4- EXTERIOR PAVING

NOTES

Rev.:

Date:

Description:

Approved:

All information in this document is the property of PALESTINIAN CIVIL POLICE and cannot be copied anywhere but in this project without prior written consent of PALESTINIAN CIVIL POLICE.

Partners:

The Independent Commission For Human Rights (ICHR)

PALESTINIAN CIVIL POLICE

Funded by:

Kingdom of Norway

Design & Implementation:

Project Name:

Detention Centers Rehabilitation Project in the West Bank (Norwegian Grant)

Title:

Jerusalem Suburbs Detention Center

Drawings Title:

List Of Drawings

Project No.:

Phase:

Discipline:

Date:

Drawing No.:

Drawn:


Checked:

Approved:

Size:

Scale:

Rev.:

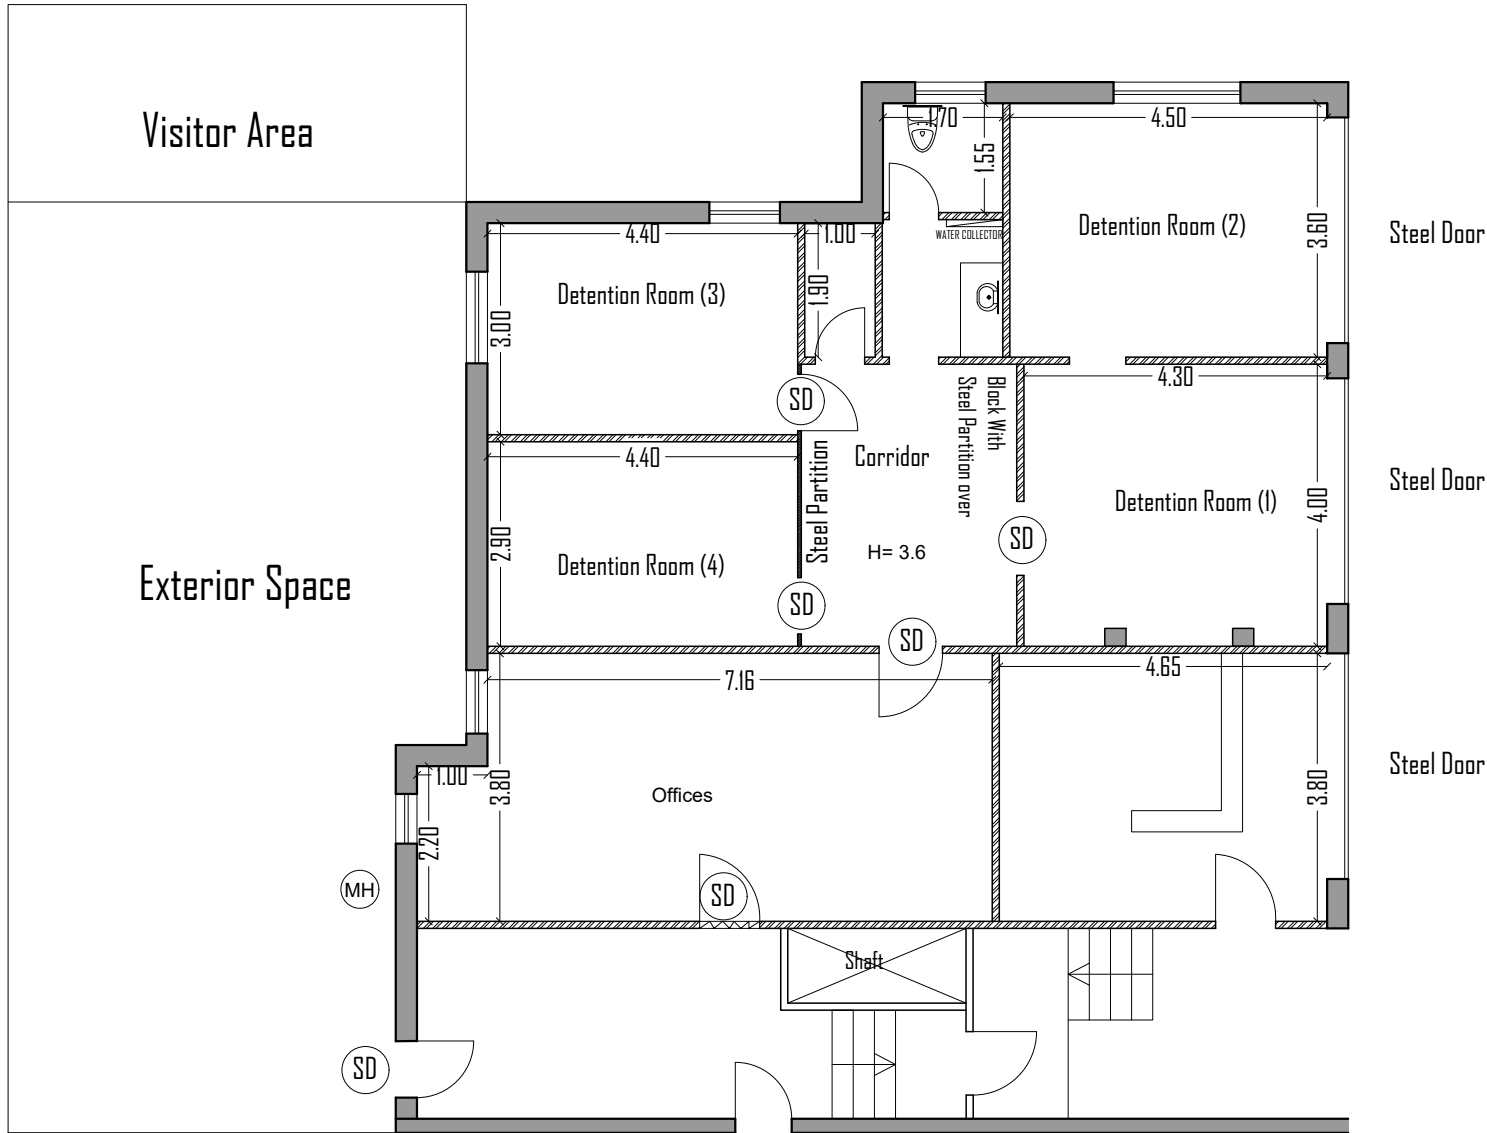

LEGEND

1- EXISTING EXTERNAL WALL	
2- REINFORCED CONCRETE	
3- CONCRETE BLOCK WALL	
4- EXTERIOR PAVING	

NOTES

Rev.:	Date:	Description:	Approved:
-------	-------	--------------	-----------

All information in this document is the property of PALESTINIAN CIVIL POLICE and cannot be copied anywhere but in this project without prior written consent of PALESTINIAN CIVIL POLICE.

Partners:

The Independent Commission For Human Rights (ICHR)	PALESTINIAN CIVIL POLICE

Funded by:

	Kingdom of Norway
--	-------------------

Design & Implementation:

	QURIE ARCHITECTURE
--	--------------------

Project Name:

Detention Centers Rehabilitation Project in the West Bank (Norwegian Grant)

Title:


Jerusalem Suburbs Detention Center

Drawings Title:

Existing Plan

Project No.:	Phase:	Discipline:	Date:	Drawing No.:
000000	01	A	8.2021	A01
Drawn:	Checked:	Approved:	Size:	Scale:
			A3	1:100

SD Steel Doors
Story Clear Height = 3.65m

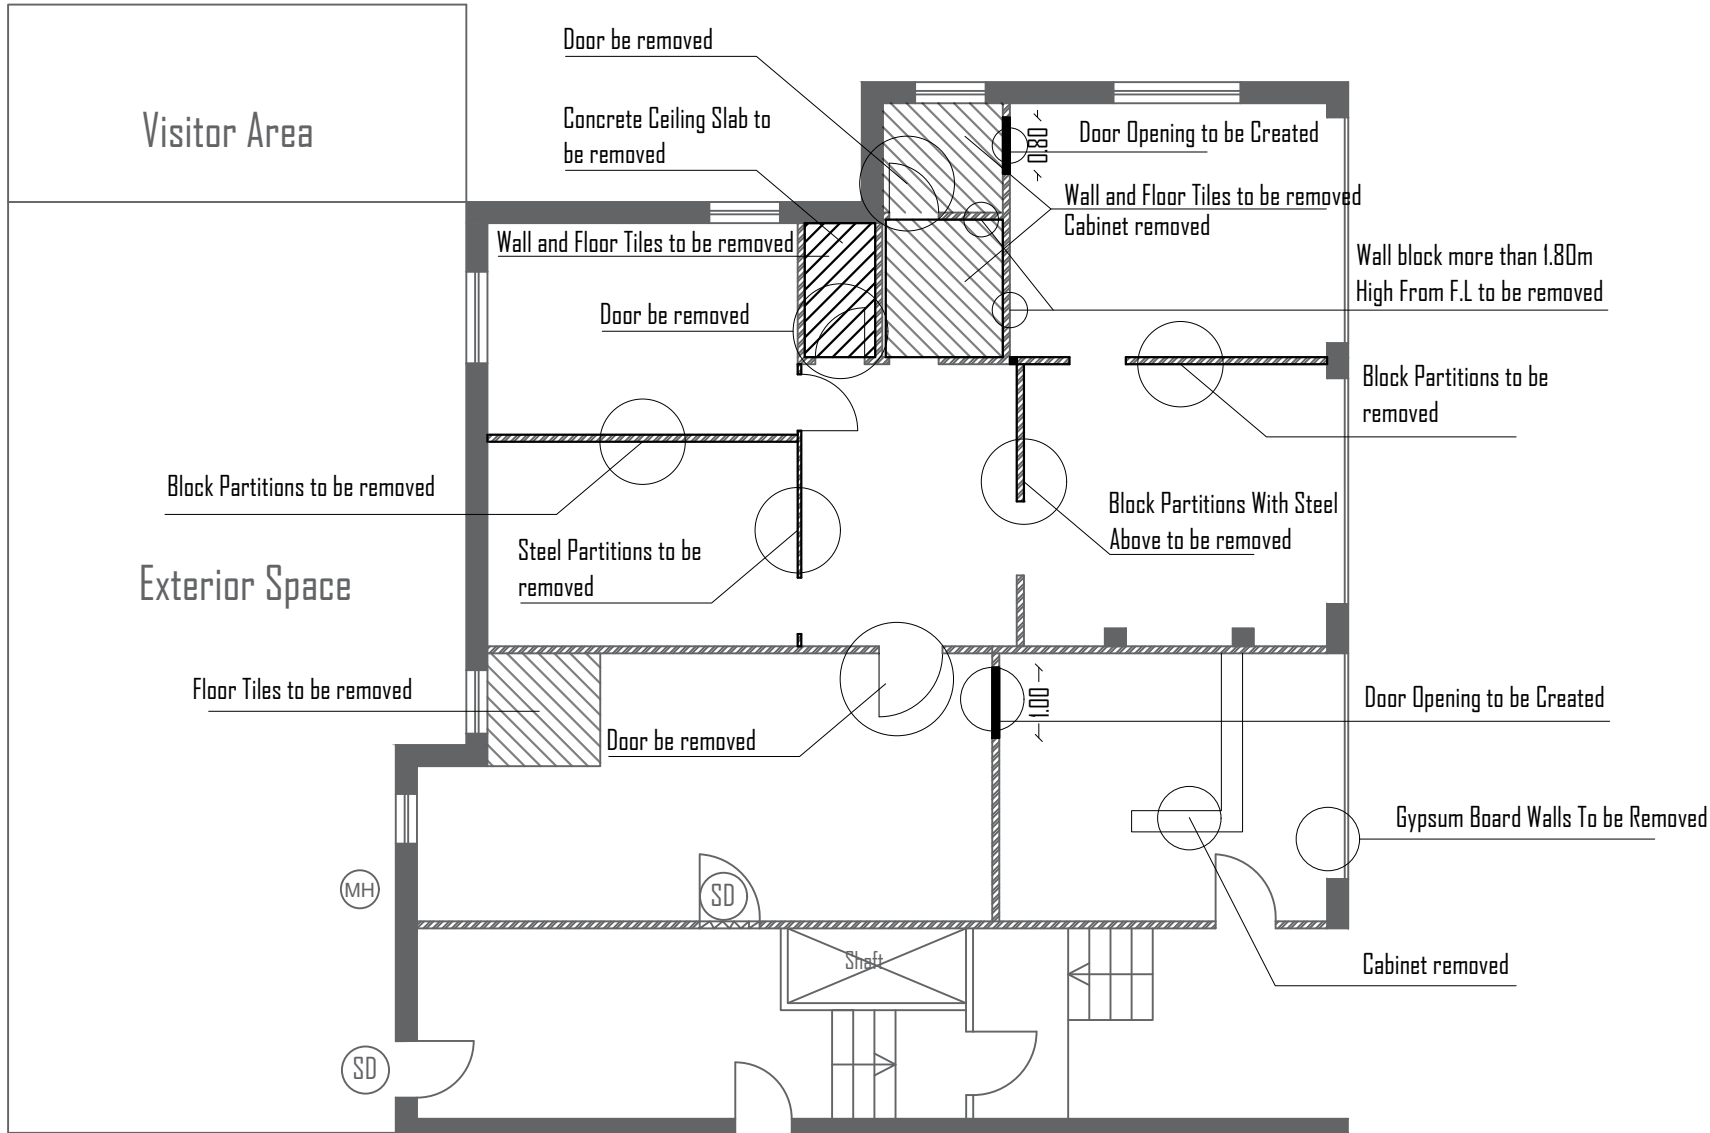

LEGEND

1- EXISTING EXTERNAL WALL	
2- REINFORCED CONCRETE	
3- CONCRETE BLOCK WALL	
4- EXTERIOR PAVING	

NOTES

Rev.:	Date:	Description:	Approved:
-------	-------	--------------	-----------

All information in this document is the property of PALESTINIAN CIVIL POLICE and cannot be copied anywhere but in this project without prior written consent of PALESTINIAN CIVIL POLICE.

Partners:	
The Independent Commission For Human Rights (ICHR)	PALESTINIAN CIVIL POLICE

Funded by:	
	Kingdom of Norway


Design & Implementation:	
	QURIE ARCHITECTURE

Project Name:
Detention Centers Rehabilitation Project in the West Bank (Norwegian Grant)

Title:
Jerusalem Suburbs Detention Center

Drawings Title:
Demolition Plan

Project No.:	Phase:	Discipline:	Date:	Drawing No.:
000000	01	A	8.2021	A02
Drawn:	Checked:	Approved:	Size:	Scale:
			A3	1:100

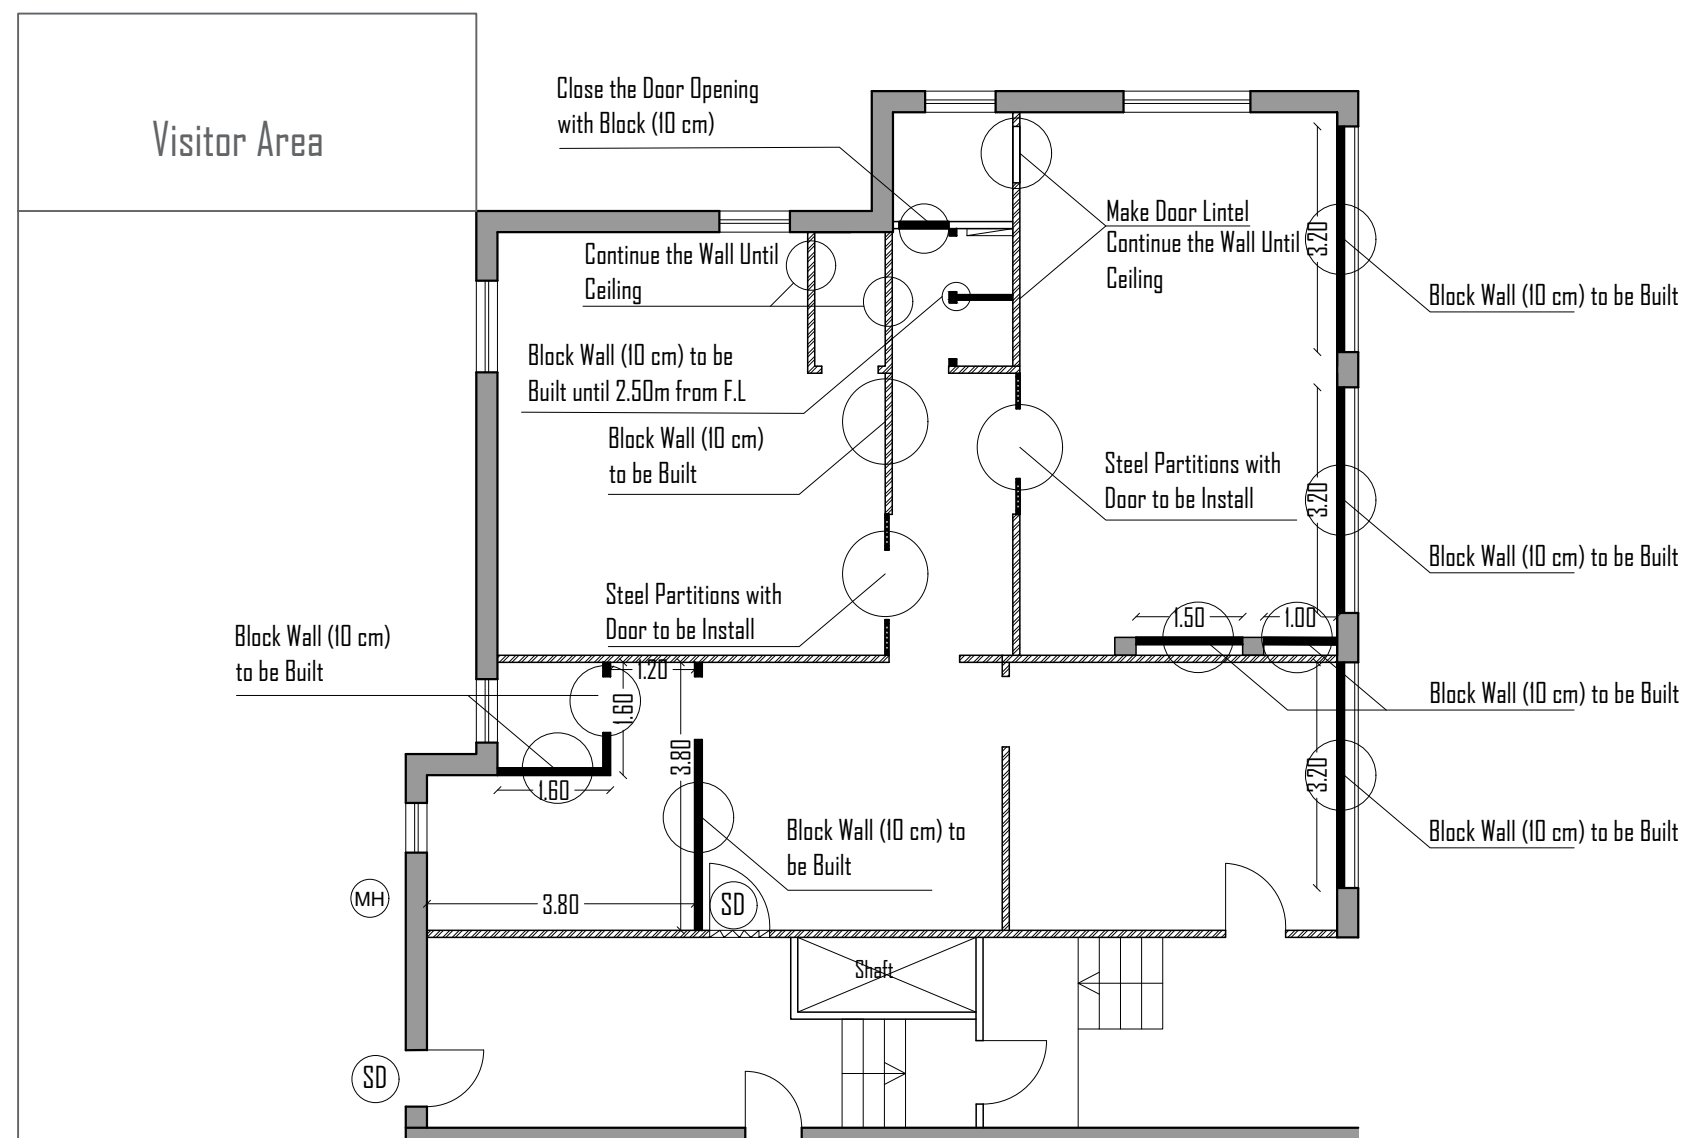

LEGEND

- | | |
|---------------------------|---|
| 1- EXISTING EXTERNAL WALL |  |
| 2- REINFORCED CONCRETE |  |
| 3- CONCRETE BLOCK WALL |  |
| 4- EXTERIOR PAVING |  |

NOTES

Rev.:	Date:	Description:	Approved:
<p>All information in this document is the property of PALESTINIAN CIVIL POLICE and cannot be copied anywhere but in this project without prior written consent of PALESTINIAN CIVIL POLICE.</p>			

Partners:

The Independent Commission
For Human Rights (ICHR)



PALESTINIAN CIVIL POLICE



Funded by:	
------------	--



Kingdom of Norway

Design & Implementation:



Q U I R I E

ARCHITECTURE

Project Name:

Detention Centers Rehabilitation
Project in the West Bank
(Norwegian Grant)


Title:

Jerusalem Suburbs Detention Center

Drawings Title:

To Be Built Walls Plan

Project No.:		Phase:		Discipline:		Date:		Drawing No.:	
000000		01		A		8.2021		A03	
Drawn:	Checked:	Approved:	Size:	Scale:		Rev.:			
			A3	1:100					

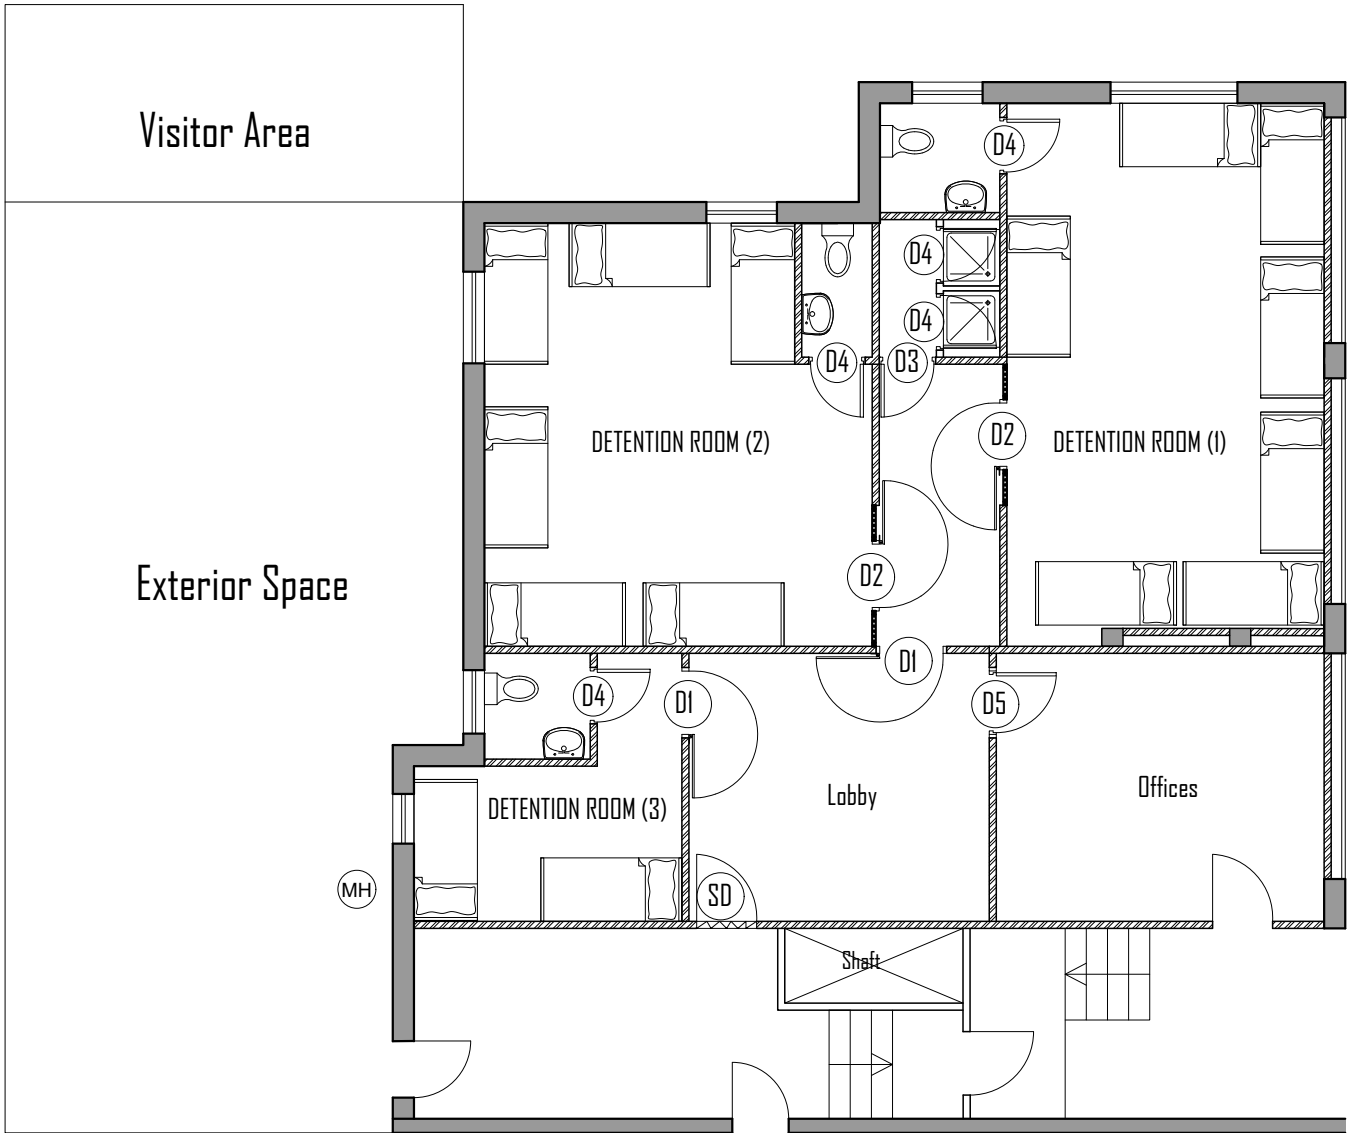

LEGEND

1- EXISTING EXTERNAL WALL	
2- REINFORCED CONCRETE	
3- CONCRETE BLOCK WALL	
4- EXTERIOR PAVING	

NOTES

Rev.:	Date:	Description:	Approved:
-------	-------	--------------	-----------

All information in this document is the property of PALESTINIAN CIVIL POLICE and cannot be copied anywhere but in this project without prior written consent of PALESTINIAN CIVIL POLICE.

Partners:

The Independent Commission For Human Rights (ICHR)	PALESTINIAN CIVIL POLICE

Funded by:

	Kingdom of Norway
--	-------------------

Design & Implementation:

	QURIE ARCHITECTURE
--	--------------------

Project Name:

Detention Centers Rehabilitation Project in the West Bank (Norwegian Grant)


Title:

Jerusalem Suburbs Detention Center

Drawings Title:

Proposed Furniture Plan

Project No.:	Phase:	Discipline:	Date:	Drawing No.:
000000	D1	A	8.2021	A04
Drawn:	Checked:	Approved:	Size:	Scale:
			A3	1:100

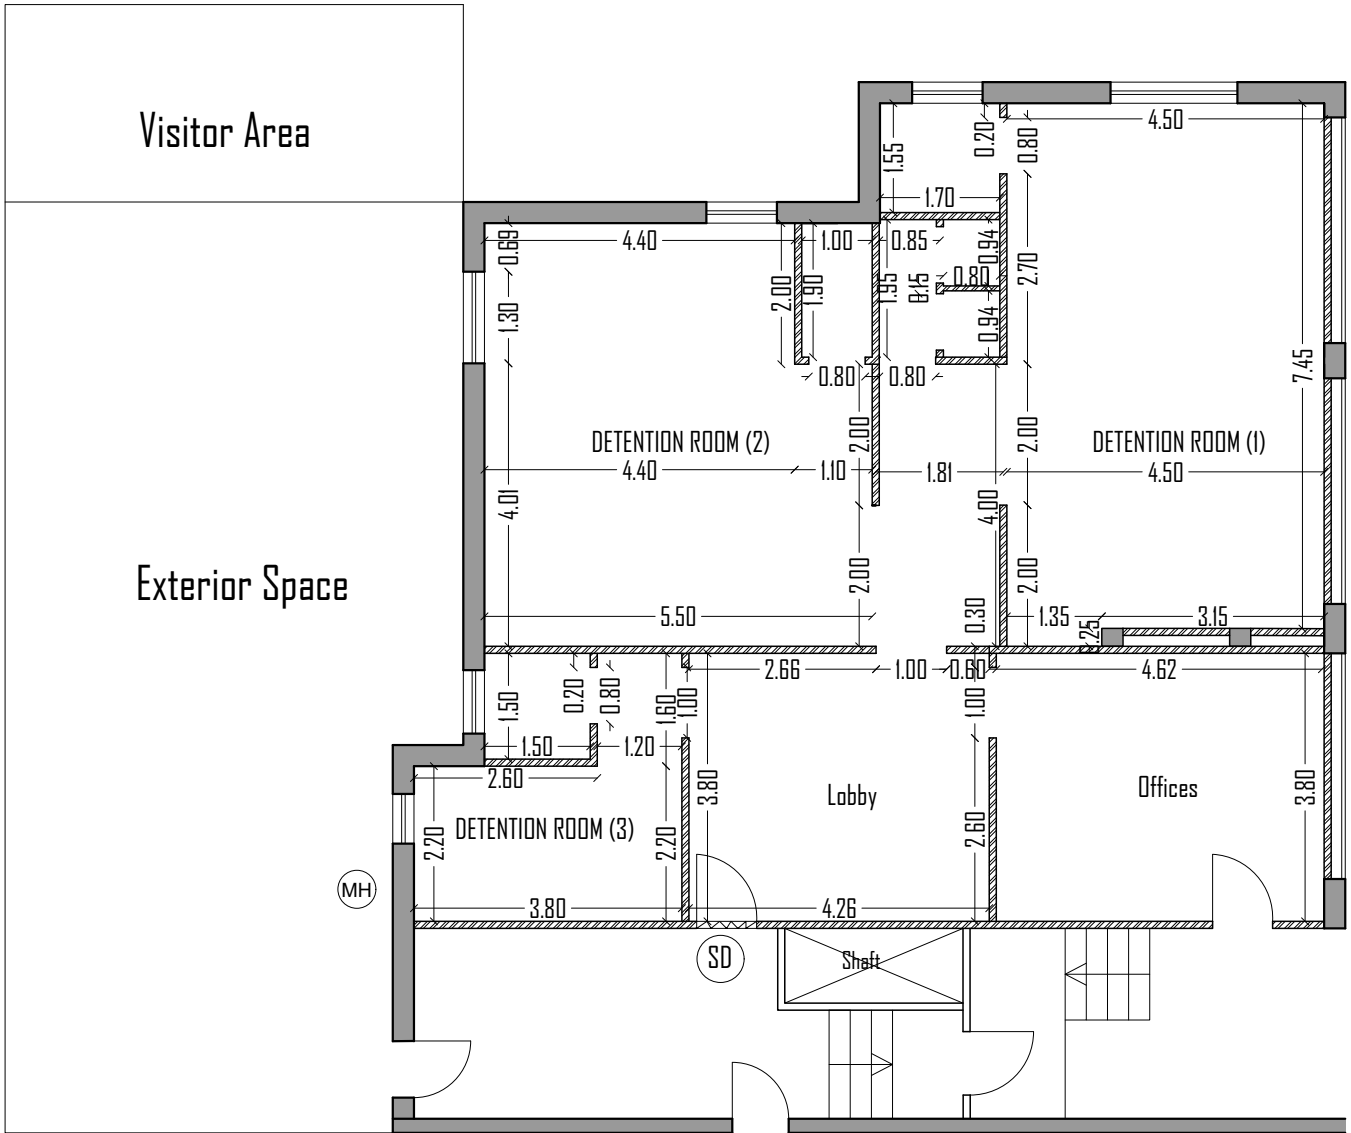

LEGEND

1- EXISTING EXTERNAL WALL	
2- REINFORCED CONCRETE	
3- CONCRETE BLOCK WALL	
4- EXTERIOR PAVING	

NOTES

Rev.:	Date:	Description:	Approved:
-------	-------	--------------	-----------

All information in this document is the property of PALESTINIAN CIVIL POLICE and cannot be copied anywhere but in this project without prior written consent of PALESTINIAN CIVIL POLICE.

Partners:


The Independent Commission For Human Rights (ICHR)

PALESTINIAN CIVIL POLICE

Funded by:

 Kingdom of Norway

Design & Implementation:



QURIE
ARCHITECTURE

Project Name:
Detention Centers Rehabilitation Project in the West Bank (Norwegian Grant)

Title:
Jerusalem Suburbs Detention Center

Drawings Title:
Proposed Dimensional Plan

Project No.:	Phase:	Discipline:	Date:	Drawing No.:
000000	01	A	8.2021	A05
Drawn:	Checked:	Approved:	Size:	Scale:
			A3	1:100